



STATE OF NEW YORK  
OFFICE OF GENERAL SERVICES  
DESIGN AND CONSTRUCTION GROUP  
THE GOVERNOR NELSON A. ROCKEFELLER  
EMPIRE STATE PLAZA  
ALBANY, NY 12242



---

---

**ADDENDUM NO. 1 TO PROJECT NO. 43996**

**CONSTRUCTION WORK  
PROVIDE CLASSROOM  
STATE ARMORY  
27 MASTEN AVENUE  
BUFFALO, NY, 14204**

February 14, 2013

**NOTE:** This Addendum forms a part of the Contract Documents. Insert it in the Project Manual. Acknowledge receipt of this Addendum in the space provided on the Bid Form.

**SPECIFICATIONS**

1. Section 064000 Architectural Woodwork: Discard the section bound in the Project Manual and substitute the attached Section (pages 064000-1 to 064000-4) noted Revised 2/14/13.

**DRAWINGS**

1. Addendum Drawing: The following drawings noted ADDENDUM DRAWING #1 2/14/13 accompany this Addendum and form part of the contract documents:
  - a. A-101 CODE PLAN, DEMO PLAN, FLOOR PLAN, RCP
  - a. A-401 SCHEDULES, ENLARGED PLAN, ELEVATIONS
  - b. P-101 FIRST FLOOR REMOVAL AND NEW WORK PLAN
  - c. E-101 FIRST FLOOR REMOVAL AND NEW WORK PLAN

**END OF ADDENDUM**

James Dirolf, P.E.  
Director of Design

**SECTION 064000**

**ARCHITECTURAL WOODWORK**

**PART 1 GENERAL**

**1.01 RELATED WORK SPECIFIED ELSEWHERE**

- A. Rough Carpentry: Section 061000.

**1.02 REFERENCES**

- A. Comply with the applicable provisions of the "Architectural Woodwork Standards" (First Edition-2009) (AWS) except as otherwise specified herein. References to "Premium", "Custom", and "Economy" Grades herein, shall be as defined in that Standard.

**1.03 SUBMITTALS**

- A. Shop Drawings: Show fabrication details and connections to adjacent Work.
- B. Product Data: Manufacturers' catalog sheets, specifications, and installation instructions for plastic laminates and hardware items.
- C. Samples:
  - 1. Plastic Laminate: 12 inch square section, each type.
    - a. Color Samples: Manufacturer's standard colors, textures, and finish.
- D. Samples
  - 1. Solid Surface:
    - a. Color Samples: Manufacturer's standard colors, textures, and finish.

**PART 2 PRODUCTS**

**2.01 CABINETS AND COUNTERTOPS**

- A. Comply with AWS Sections 10 and 11 except as otherwise specified herein.
- B. Cabinets:
  - 1. For Laminate Finish: Custom Grade, with plastic laminate cover on exposed cabinetwork and on inside face of hinged doors.
- C. Countertops: Configuration: Provide countertops with the following front and backsplash style:
  - 1. Front: Straight, slightly eased at top.
  - 2. Backsplash: Straight, slightly eased at corner.
  - 3. Endsplash: Matching backsplash.

- C. Countertops: ~~3/4-inch-~~ (19-mm-) thick, solid surface material with front edge built up with same material.
- D. Countertops: ~~1/4-inch-~~ (6.4-mm-) thick, solid surface material laminated to ~~3/4-inch-~~ (19-mm-) thick particleboard with exposed edges built up with ~~3/4-inch-~~ (19-mm-) thick, solid surface material.
- E. Backsplashes: ~~3/4-inch-~~ (19-mm-) thick, solid surface material.
- F. Fabrication: Fabricate tops in one piece with shop-applied edges and backsplashes unless otherwise indicated. Comply with solid-surface-material manufacturer's written instructions for adhesives, sealers, fabrication, and finishing.
  - 1. Fabricate with loose backsplashes for field assembly.
  - 2. Install integral sink bowls in countertops in the shop.

## 2.02 COUNTERTOP MATERIALS

- A. Plywood: Exterior softwood plywood complying with DOC PS 1, Grade C-C Plugged, touch sanded.
- B. Solid Surface Material: Homogeneous solid sheets of filled plastic resin complying with ANSI SS1.
  - 1. Manufacturers: Subject to compliance with requirements, available manufacturers offering products that may be incorporated into the Work include, but are not limited to, the following:
    - a. Avonite Surfaces.
    - b. E. I. du Pont de Nemours and Company.
    - c. Formica Corporation.
    - d. LG Chemical, Ltd.
    - e. Meganite Inc.
    - f. Samsung Chemical USA, Inc.
    - g. Swan Corporation (The).
    - h. Transolid, Inc.
    - i. Wilsonart International.
  - 2. Integral Sink Bowls: Comply with ISSFA-2 and ANSI Z124.3, Type 5 or Type 6, without a precoated finish.
  - 3. Colors and Patterns: As selected by Architect from manufacturer's full range.
- C.. Plastic Laminate: NEMA Standards Publication LD3 for the following types; color, texture, and finish as indicated, or if not indicated, as selected by the Director.
  - 1. Horizontal Surfaces: General Purpose Type; GP 50 Grade; 0.050 inch nominal thickness.

2. Post-Formed Surfaces: Postforming Type; PF 42 Grade; 0.042 inch nominal thickness.
3. Vertical Surfaces: General Purpose Type; GP 28 Grade; 0.028 inch nominal thickness.
4. Chemical Resistant Surfaces: Specific Purpose Type; SP 62 Grade; 0.062 inch nominal thickness.
5. Concealed Back Faces: Backer Type; BK 20 Grade; 0.020 inch nominal thickness.

## **2.03 HARDWARE**

- A. Provide hardware as required for architectural woodwork, including cabinet hardware and miscellaneous items. Provide dull chrome finish (US26D), or nearest match available, except as otherwise indicated.
  1. Closet Rods: Steel tubing with bright nickel finish; Knape & Vogt KV2, or Stanley V7050.
  2. Adjustable Shelf Pilaster Standards and Supports: Steel with bright nickel or zinc finish; Knape & Vogt 255 x 256, or Grant 120 x 21.
  3. Adjustable Shelf Slotted Standards and Brackets: Steel; satin anachrome or zinc finish, Knape & Vogt 80 x 180 and 179 adjustable brackets, or Garcy 649 x 689 and N768 adjustable brackets.
  4. Hinges: Steel for 3/4 inch flush doors; Stanley 1586, or Hager 1822.
  5. Pivots: Steel for 3/4 inch overlay doors; Stanley 331 and 332, or Hager 1043 and 1044.
  6. Bottom Track and Sheaves: Knape & Vogt 455SS with 413 sheaves and 953 upper "T" guide, or Grant 2011 with Series 20 sheaves.
  7. Drawer Slides: Full extension, 50 lb capacity; Knape & Vogt 1428, or Grant 328.
  8. Cabinet Door/Drawer Pulls, Surface: Stanley 4477, or H.B. Ives 237.
  9. Sliding Door Pulls, Flush: H.B. Ives 22, or Grant 424.
  10. Magnetic Cabinet Door Catches: Stanley SP45, or H.B. Ives 325.
  11. Cabinet Drawer Lock: Corbin Cabinet Lock 0666, or National Cabinet Lock M2-3700.
  12. Cabinet Door Lock: Corbin Cabinet Lock 0370B, or National Cabinet Lock M2-3702, hand as required.
  13. Sliding Door Lock: Corbin Cabinet Lock 02291, or National Cabinet Lock C8042-26D.

## **PART 3 EXECUTION**

### **3.01 INSTALLATION**






- A. Install the Work of this Section in strict accordance with the manufacturer's printed instructions and approved shop drawings (if any).
- B. Fit joints neatly and accurately with adjoining surfaces in same plane. Maintain field joint tolerances equal to those specified in AWS Standards.
- C. Fastening:
  1. Use concealed fasteners for work to receive transparent finish.

2. Fasten assembled items together securely.
3. Fasten items securely to supporting surfaces.
4. Set exposed nails for putty stopping.
5. Plug stop screws in exposed-to-view surfaces.
6. Perform gluing operations in such a manner that the glued surfaces will be in close contact throughout, firmly cemented together and with joints as nearly invisible as possible.

**END OF SECTION**

# ELECTRICAL SYMBOL LIST

	FIRE ALARM SYSTEM NOTIFICATION APPLIANCE
	FIRE ALARM SYSTEM SMOKE DETECTOR
	FIRE ALARM SYSTEM SMOKE DETECTOR DUCT MOUNTED TYPE
	FIRE ALARM FAN SHUT-DOWN RELAY
	EQUIPMENT CONNECTION WITH DESIGNATION FROM ELECTRICAL EQUIPMENT AND CONTROL SCHEDULE
	LOCATION OF ONE OR MORE EQUIPMENT CONTROL DEVICES AS SCHEDULED ON ELECTRICAL EQUIPMENT AND CONTROL SCHEDULE
	REMOTE TEST STATION FOR DUCT DETECTOR
	WALL MOUNTED OCCUPANCY SENSOR
	TELEDATA OUTLET. REFER TO DETAIL FOR ASSOCIATED WORK
	CEILING PROJECTOR. REFER TO DETAIL FOR ASSOCIATED WORK
	CEILING MOUNTED EXIT SIGN
	EMERGENCY LIGHTING UNIT. INTEGRAL BATTERY
	AV 150d FIRE ALARM SYSTEM NOTIFICATION APPLIANCE 150d = CANDELA RATING
	F-1 FIRE ALARM SYSTEM SMOKE DETECTOR
	F-1 FIRE ALARM FAN SHUT-DOWN RELAY
	REMOVAL SYMBOL

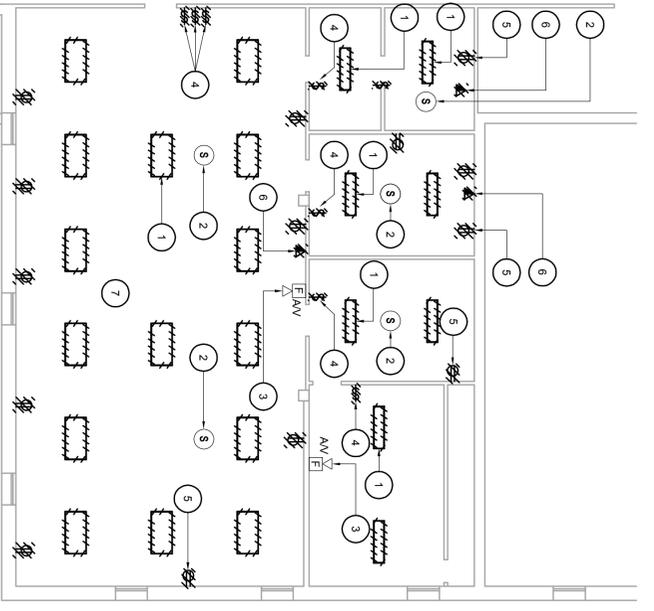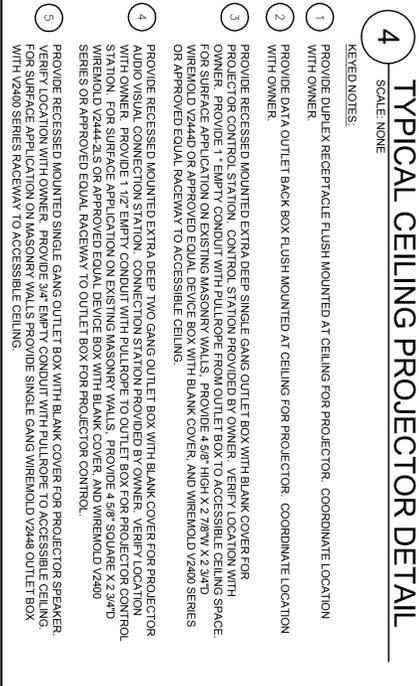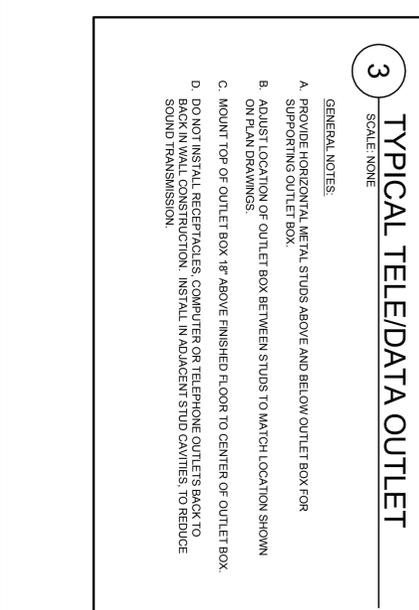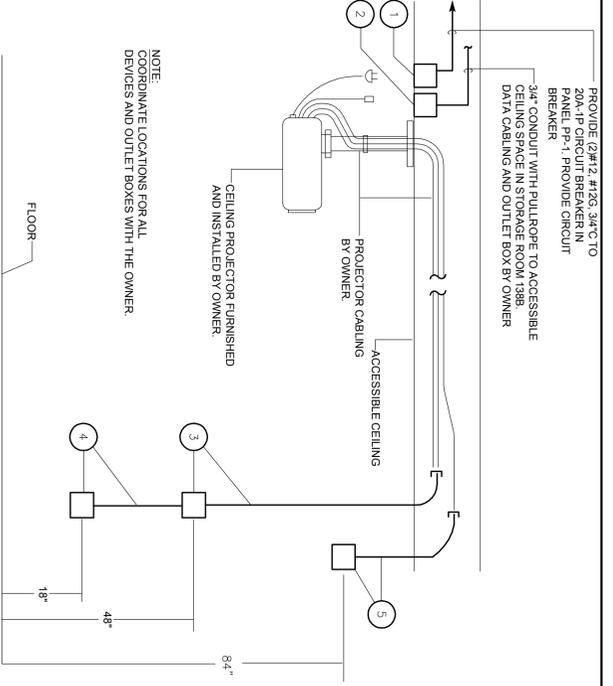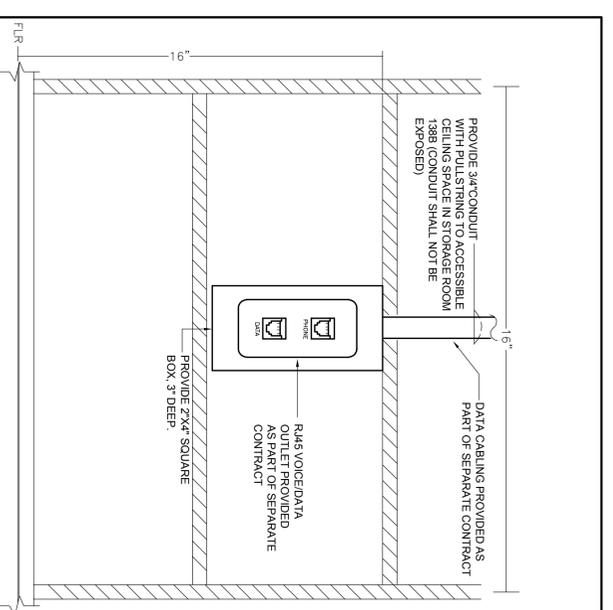


**KEYED NOTES:**

- DISCONNECT AND REMOVE EXISTING LIGHT FIXTURE AND ASSOCIATED CONDUIT AND WIRING BACK TO SOURCE. MAINTAIN CONTINUITY OF DEVICES TO REMAIN. TRACE AND FIELD VERIFY SOURCE. TYPICAL OF ALL LIGHT FIXTURES IN THIS ROOM.
- DISCONNECT EXISTING SMOKE DETECTOR AND RECONNECT AT ITS NEW LOCATION. EXTENDING ROUTE CONDUIT AND WIRING TO NEW LOCATION. REFER TO DRAWING 1E-101 FOR NEW LOCATION.
- DISCONNECT EXISTING AUDIO/VISUAL DEVICE AND RECONNECT AT ITS NEW LOCATION. REFER TO DRAWING 1E-101 FOR NEW LOCATION.
- DISCONNECT AND REMOVE EXISTING LIGHT SWITCH AND ASSOCIATED CONDUIT AND WIRING BACK TO SOURCE. TRACE AND FIELD VERIFY SOURCE.
- DISCONNECT AND REMOVE EXISTING DUPLEX RECEPTACLE AND ASSOCIATED CONDUIT AND WIRING BACK TO SOURCE. MAINTAIN CONTINUITY OF DEVICES TO REMAIN. TRACE AND FIELD VERIFY SOURCE. TYPICAL OF DUPLEX RECEPTABLES IN THIS ROOM.
- DISCONNECT AND REMOVE EXISTING TELEDATA OUTLET AND ASSOCIATED CONDUIT AND WIRING BACK TO SOURCE. TRACE AND FIELD VERIFY SOURCE.
- DISCONNECT AND REMOVE EXISTING ABANDONED 2x4 LIGHT FIXTURES LOCATED ABOVE EXISTING CEILING GRID AND ASSOCIATED CONDUIT AND WIRING BACK TO SOURCE. TRACE AND FIELD VERIFY SOURCE. QUANTITY OF ABANDONED LIGHT FIXTURES: 18.

**GENERAL NOTES:**

- UNLESS OTHERWISE NOTED, HOOKUP CONDUCTORS FOR 20 AMP RECEPTACLE CIRCUITS SHALL BE #12 AWG FOR RUNS 1-100 FEET, #10 AWG FOR RUNS 101-150 FEET. REDUCE CONDUCTOR SIZE TO A MAXIMUM CONDUCTOR SIZE THAT THE RECEPTACLE TERMINALS CAN ACCOMMODATE. REDUCED SIZE NOT LONGER THAN ONE FOOT. INCREASE RACEWAY SIZE AS NEEDED PER NEC. FOR THE LARGER SIZES.
- UNLESS OTHERWISE NOTED, ALL BRANCH CIRCUITS SHALL BE CIRCUITED TO PANEL PP-1.
- ALL CONDUIT AND WIRING SHALL BE CONCEALED.
- ALL CONDUIT AND WIRING IN CLASSROOM 138 FOR RECEPTABLES AND CONDUIT DATA SHALL BE ROUTED THROUGH 3" HIGH FURRED OUT WALL SECTION AROUND THE ROOM PERIMETER. REFER TO ARCHITECTURAL PLANS FOR WALL DETAIL.
- CIRCUIT TYPE LA EMERGENCY LIGHTS TO UNSWITCHED LEG OF LOCAL LIGHTING CIRCUIT.
- CIRCUIT EXIT SIGNS TO EXISTING BUILDING EXIT SIGN CIRCUIT.
- EXISTING FIRE ALARM SYSTEM IS NOTIFIER. NEW DEVICES SHALL BE COMPATIBLE WITH EXISTING SYSTEM EXPANSION ITEMS REQUIRED TO PROGRAMMABLE AND TESTING OF ALL NEW AND RELOCATED DEVICES AS PART OF CONTRACT.
- PROVIDE TYPEWRITEN PANELBOARD DIRECTORIES WHERE CIRCUITS HAVE BEEN ADDED OR MODIFIED.
- PROVIDE TEMPORARY LIGHTING DURING CONSTRUCTION UNTIL NEW LIGHTING IS INSTALLED AND OPERATIONAL.
- COORDINATE HEIGHT OF REFRIGERATOR AND MICROVAPE RECEPTACLE WITH ARCHITECT.
- RELOCATED FIRE ALARM DEVICE. EXTEND/ROUTE EXISTING CONDUIT AND WIRING TO DEVICE AT ITS NEW LOCATION.
- VERIFY EXACT LOCATION OF CEILING PROJECTOR AND ASSOCIATED EQUIPMENT WITH ARCHITECT.
- PANEL PP-1 LOCATED ON FLOOR BELOW IN BOILER ROOM. PANEL TYPE: CUTLER HAMMER POW-R-LINE C, PRL18, 100A, 3P/4W, 208V/120V, 42 SPACE.
- AHU-1 LOCATED ON ROOF ABOVE. DISCONNECT SWITCH INTEGRAL TO UNIT.
- FAN LOCATED ON ROOF ABOVE.
- MOUNT REMOTE TEST STATION FOR DUCT DETECTORS IN VISIBLE AREA ON CEILING GRID.
- WEATHER-PROOF: GFI, DUPLEX RECEPTACLE MOUNTED ON AHU-1 LOCATED ON ROOF.
- PROVIDE DUCT DETECTOR TO WORK IN CONJUNCTION WITH EXISTING NOTIFER FIRE ALARM SYSTEM. FIELD VERIFY. PROVIDE ONE DUCT DETECTOR ON SUPPLY DUCTWORK AND ONE DUCT DETECTOR ON RETURN DUCTWORK. PROVIDE WIRING PER IAWD NUMBER REQUIREMENTS.

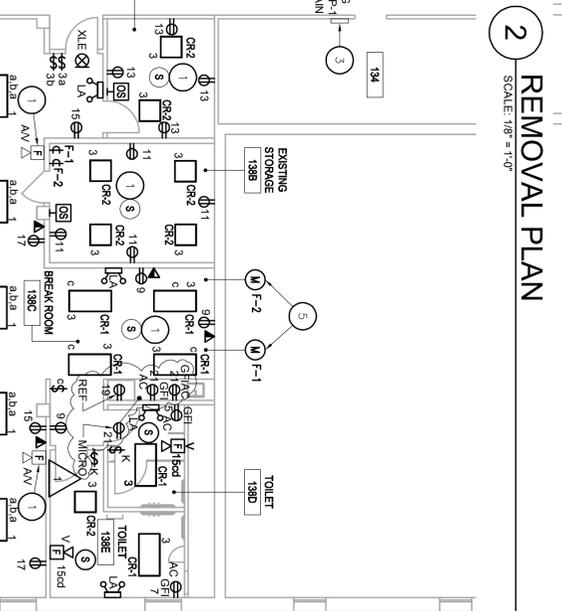


**KEYED NOTES:**

- INDICATES EQUIPMENT DESIGNATION FROM SCHEDULE
- INDICATES ROOM LOCATION FOR CONTROL DEVICE
- INDICATES FIRE ALARM FAN SHUT-DOWN IS REQUIRED
- INDICATES EQUIPMENT DESIGNATION FROM SCHEDULE
- INDICATES ROOM LOCATION FOR CONTROL DEVICE
- INDICATES FIRE ALARM FAN SHUT-DOWN IS REQUIRED
- INDICATES EQUIPMENT DESIGNATION FROM SCHEDULE
- INDICATES ROOM LOCATION FOR CONTROL DEVICE
- INDICATES FIRE ALARM FAN SHUT-DOWN IS REQUIRED

**ITEMS FURNISHED AND INSTALLED BY ELECTRICAL DIVISION**

ITEMS FURNISHED AND INSTALLED BY ELECTRICAL DIVISION	ITEMS FURNISHED BY OTHER DIVISIONS AND INSTALLED BY ELECTRICAL DIVISION
F-1	INDICATES EQUIPMENT DESIGNATION FROM SCHEDULE
101	INDICATES ROOM LOCATION FOR CONTROL DEVICE
AU	INDICATES FIRE ALARM FAN SHUT-DOWN IS REQUIRED
X	INDICATES EQUIPMENT DESIGNATION FROM SCHEDULE
138B	INDICATES ROOM LOCATION FOR CONTROL DEVICE
138B	INDICATES FIRE ALARM FAN SHUT-DOWN IS REQUIRED

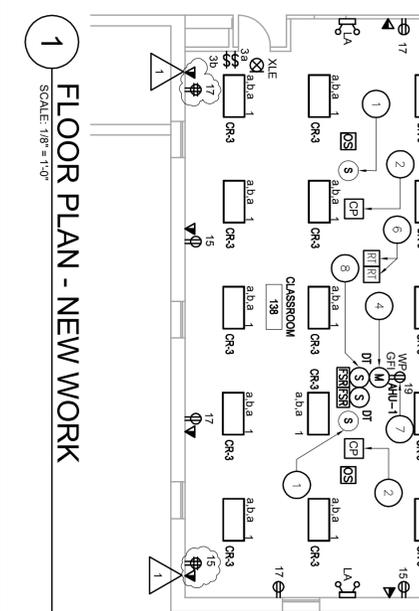

**KEYED NOTES:**

- INDICATES EQUIPMENT DESIGNATION FROM SCHEDULE
- INDICATES ROOM LOCATION FOR CONTROL DEVICE
- INDICATES FIRE ALARM FAN SHUT-DOWN IS REQUIRED
- INDICATES EQUIPMENT DESIGNATION FROM SCHEDULE
- INDICATES ROOM LOCATION FOR CONTROL DEVICE
- INDICATES FIRE ALARM FAN SHUT-DOWN IS REQUIRED
- INDICATES EQUIPMENT DESIGNATION FROM SCHEDULE
- INDICATES ROOM LOCATION FOR CONTROL DEVICE
- INDICATES FIRE ALARM FAN SHUT-DOWN IS REQUIRED

**ITEMS FURNISHED AND INSTALLED BY ELECTRICAL DIVISION**

ITEMS FURNISHED AND INSTALLED BY ELECTRICAL DIVISION	ITEMS FURNISHED BY OTHER DIVISIONS AND INSTALLED BY ELECTRICAL DIVISION
F-1	INDICATES EQUIPMENT DESIGNATION FROM SCHEDULE
101	INDICATES ROOM LOCATION FOR CONTROL DEVICE
AU	INDICATES FIRE ALARM FAN SHUT-DOWN IS REQUIRED
X	INDICATES EQUIPMENT DESIGNATION FROM SCHEDULE
138B	INDICATES ROOM LOCATION FOR CONTROL DEVICE
138B	INDICATES FIRE ALARM FAN SHUT-DOWN IS REQUIRED

**FIGURE SCHEDULE**

TYPE	LAMPS	TYPE AND MOUNTING	LENS	FINISH	DESIGN
CR-1	(2) 32W T8	2x4 RECESSED LINEAR FLUORESCENT (GRID MOUNT)	PRISMATIC	WHITE	COOPER
CR-2	(2) 17W T8	2x4 RECESSED LINEAR FLUORESCENT (GRID MOUNT)	PRISMATIC	WHITE	COOPER
CR-3	(3) 32W T8	2x4 RECESSED LINEAR FLUORESCENT (GRID MOUNT)	PRISMATIC	WHITE	COOPER
LA	(2) 8V, 5.4W TUNGSTEN	THERMOPLASTIC EMERGENCY WALL UNIT	POLYCARBONATE	WHITE	COOPER
XLE	LED	ILLUMINATED EXIT SIGN - CEILING MOUNTED	ACRYLIC PANEL	WHITE	COOPER

**ELECTRIC EQUIPMENT AND CONTROL SCHEDULE**

ELECTRIC EQUIPMENT AND CONTROL SCHEDULE									
EQUIPMENT					ITEMS FURNISHED AND INSTALLED BY ELECTRICAL DIVISION				
NAME	ROOM LOCATION	HP	KW	V	PH	PANEL OR CONTROL CENTER	CIRCUIT BREAKER	POWER WIRING FROM PANEL TO CONTROL UNIT	POWER WIRING FROM UNIT TO EQUIPMENT
AHU-1	A HANDLING UNIT	ROOF	7	208	3	PP-1	30A-3P	3#10, 34°C	3#10, 34°C
F-1	FAN	ROOF	1/11	115	1	PP-1	15A-1P	2#12, 12°C	2#12, 12°C
F-2	FAN	ROOF	1/12	115	1	PP-1	15A-1P	2#12, 12°C	2#12, 12°C

**FIRST FLOOR REMOVAL AND NEW WORK PLANS**

PROJECT NUMBER: 43996-C

DATE: 02/14/2013

REVISION: 11/13/2012

ADENDUM #1

FINAL DOCUMENTS

MARK: DATE DESCRIPTION

DESIGNED BY: 43996-C

DRAWN BY:

FIELD CHECK:

APPROVED:

SHEET TITLE:

DRAWING NUMBER: E-101

SHEET 11 OF 11

**WARNING:**

THE ALTERATION OF THIS MATERIAL IN ANY WAY, UNLESS DONE UNDER THE DIRECTION OF A COMPETENT PROFESSIONAL ENGINEER, IS PROHIBITED. ANY CONTRACTOR OR PROFESSIONAL ENGINEER WHO VIOLATES THIS WARNING FOR A LANDSCAPE ARCHITECT IS A VIOLATION OF THE NEW YORK STATE EDUCATION LAW AND/OR REGULATIONS AND IS A CLASS X MISDEMEANOR.

OFFICE OF ISSUE:  
SALVA MEDONOS OFFICE PARK  
307 PLAINFIELD ROAD, SUITE 180  
SYRACUSE, NY 13212  
EMAIL: RNS@ROBSONWOESE.COM  
F: 315.445.0588

ROBSONWOESE INC  
CONSULTING ENGINEERS

Albany Boston Buffalo Rochester Syracuse  
RW #1263

CLIENT: DIVISION OF MILITARY AND NAVAL AFFAIRS

LOCATION: STATE ARMORY, 27 MASTEN STREET, BUFFALO, NY 14204

TITLE: PROVIDE CLASSROOM

CONTRACT:

NY'S OFFICE OF GENERAL SERVICES

Spring New York


ANDREW M. CUOMO  
GOVERNOR

CARLA CHAIKO  
NY State Commissioner


CONSULTANT






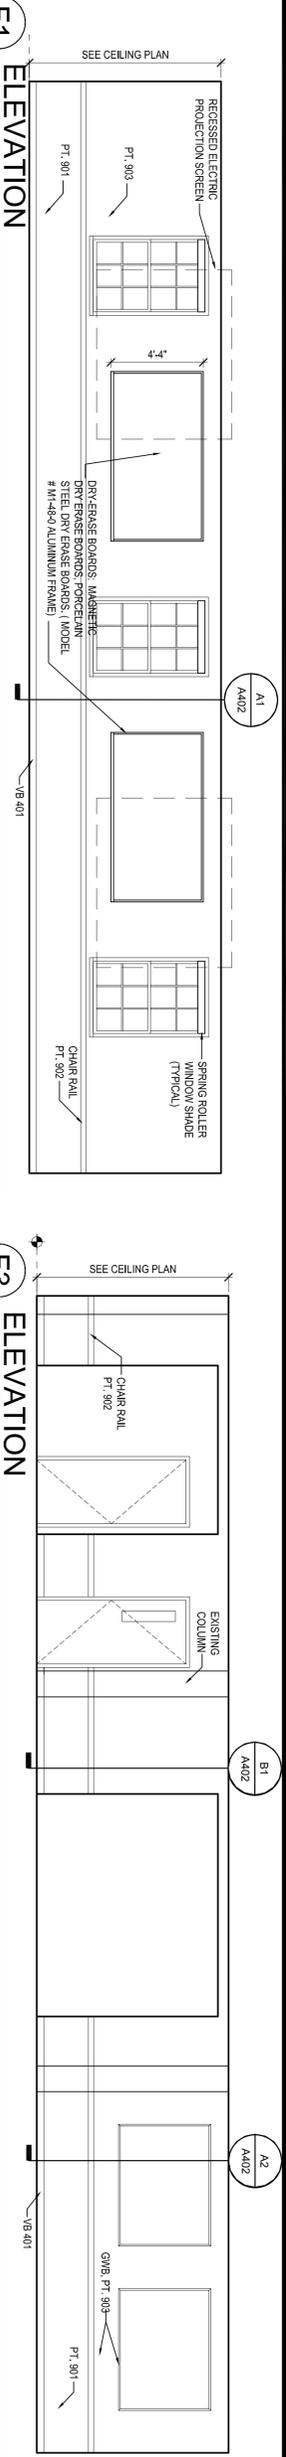


**F1**  
ELEVATION  
1/4"=1'-0"

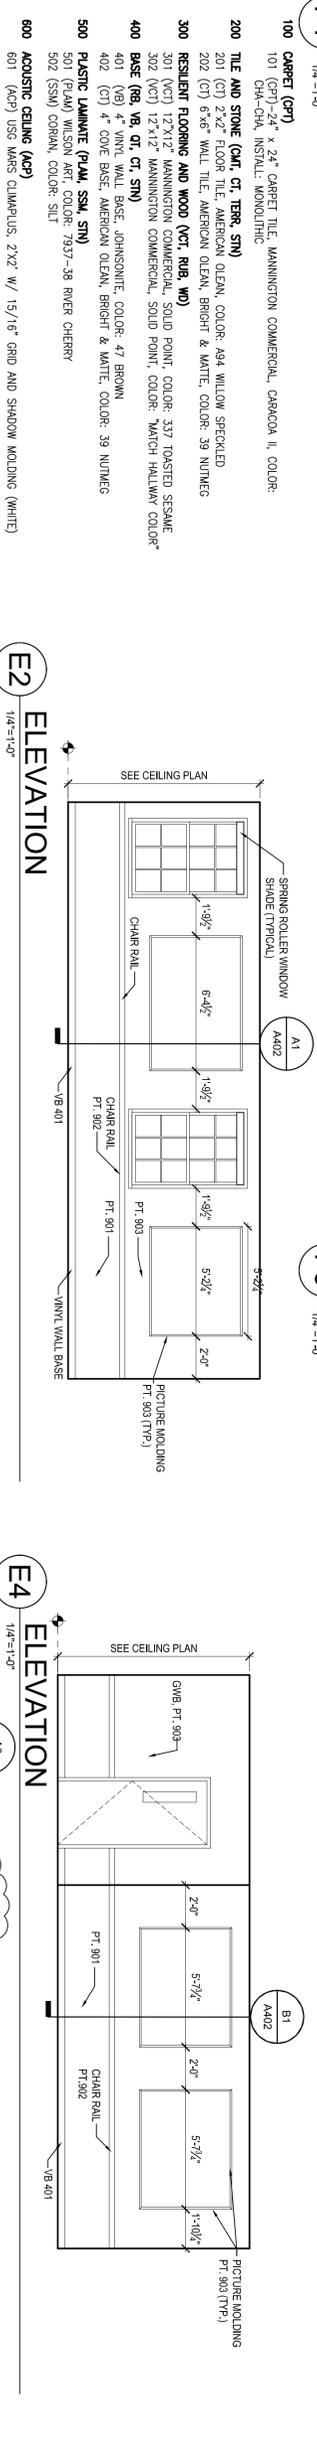


**F2**  
ELEVATION  
1/4"=1'-0"

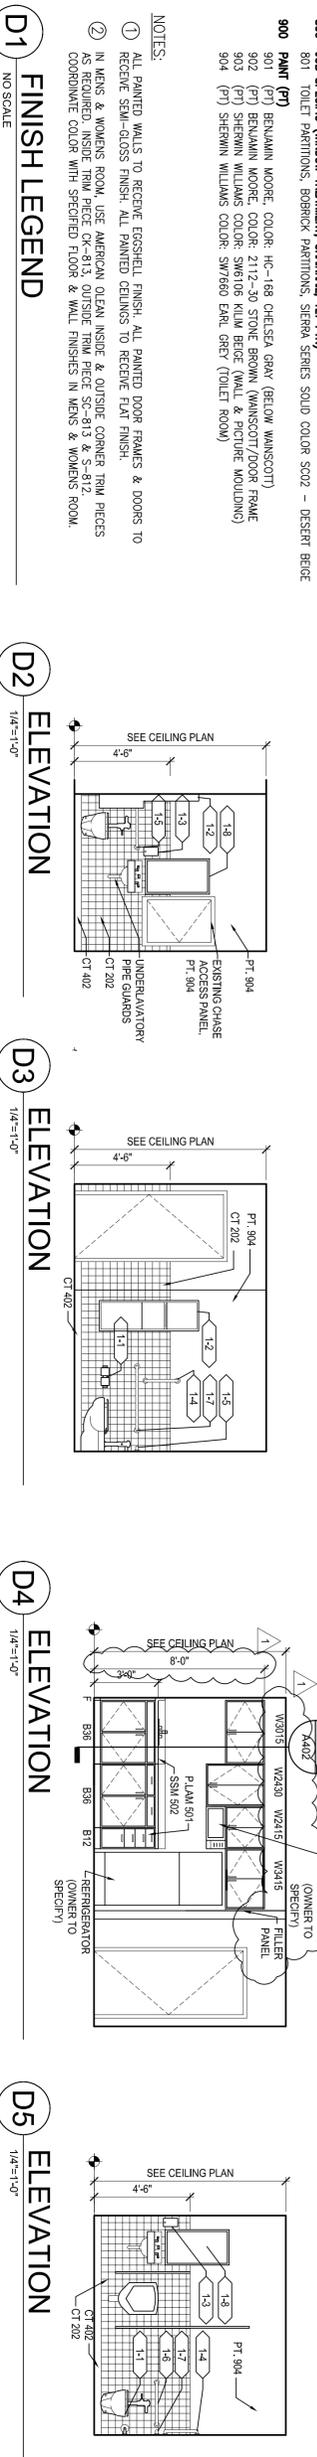

**F3**  
ELEVATION  
1/4"=1'-0"

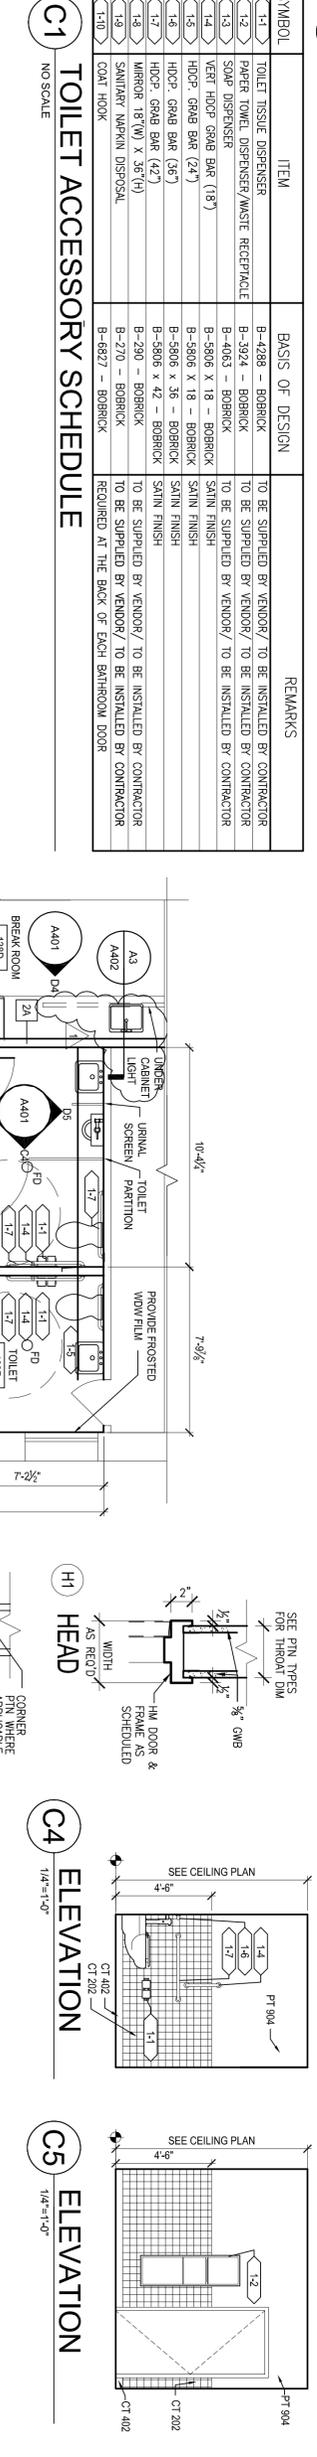

**F4**  
ELEVATION  
1/4"=1'-0"

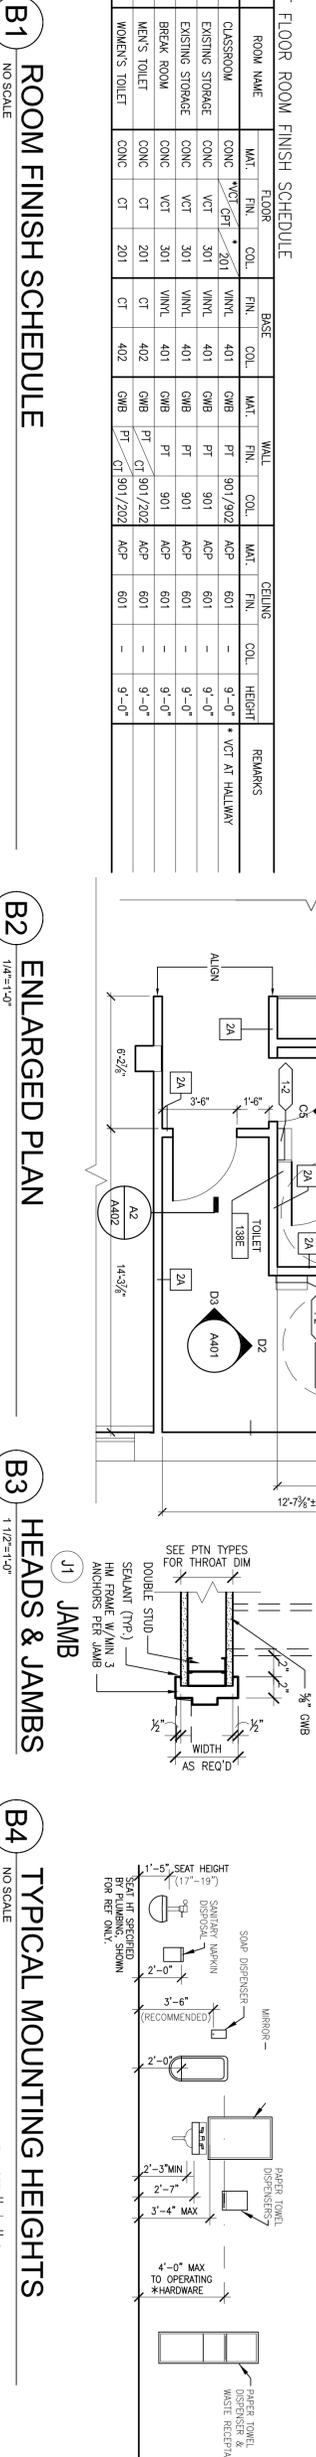

**F5**  
ELEVATION  
1/4"=1'-0"



**F6**  
ELEVATION  
1/4"=1'-0"

**CONSULTANT**

**QPK DESIGN**  
ARCHITECTURE  
ENGINEERING  
SITE & PLANNING

480 SO. SARATOGA STREET  
SYRACUSE, NEW YORK 13201-5029  
TEL: 315.472.8000 FAX: 315.472.8000

**WARNING:**  
THE FABRICATION OF THIS MATERIAL IN ANY WAY THAT DEVIATES FROM THE MANUFACTURER'S PROFESSIONAL, I.E. ARCHITECT OR AN ARCHITECT ENGINEER FOR A LANDSCAPE ARCHITECT IS A VIOLATION OF THE PROFESSIONAL SEAL AND/OR REGULATIONS AND IS A CLASS "A" MISDEMEANOR.

**CONTRACT:**  
CONSTRUCTION  
PROVIDE CLASSROOM

**TITLE:**  
STATE ARMOY  
27 MASTER STREET  
BUFFALO, NY, 14204

**LOCATION:**  
STATE ARMOY  
27 MASTER STREET  
BUFFALO, NY, 14204

**DATE:**

**DOOR SCHEDULE**

NO.	TYPE	WIDTH	HEIGHT	THICK.	MAT.	FINISH	TYPE	HEAD	JAMB	SILL	MAT.	FINISH	RATING	HARDWARE	SET	REMARKS
100	B	3'-0"	7'-0"	1 1/2"	WD	PT	1	H1	J1	T3	ALUM	902	3/4 HR	2		
101	A	3'-0"	7'-0"	1 1/2"	WD	PT	1	H1	J1	T3	ALUM	902		1		
102	A	3'-0"	7'-0"	1 1/2"	WD	PT	1	H1	J1	T1	HM	902		1		
103	A	3'-0"	7'-0"	1 1/2"	WD	PT	1	H1	J1	T1	HM	902		1		
104	B	3'-0"	7'-0"	1 1/2"	WD	PT	1	H1	J1	T3	HM	902	3/4 HR	2		

**FINISH LEGEND**





 


NO.	ITEM	BASIS OF DESIGN	REMARKS
1-1	TOILET TISSUE DISPENSER	B-4288 - BOBRICK	TO BE SUPPLIED BY VENDOR/ TO BE INSTALLED BY CONTRACTOR
1-2	PAPER TOWEL DISPENSER/WASTE RECEPTACLE	B-3924 - BOBRICK	TO BE SUPPLIED BY VENDOR/ TO BE INSTALLED BY CONTRACTOR
1-3	SOAP DISPENSER	B-4063 - BOBRICK	TO BE SUPPLIED BY VENDOR/ TO BE INSTALLED BY CONTRACTOR
1-4	VERT HOCP GRAB BAR (18")	B-5806 X 18 - BOBRICK	SAFIN FINISH
1-5	HOCP GRAB BAR (24")	B-5806 X 18 - BOBRICK	SAFIN FINISH
1-6	HOCP GRAB BAR (36")	B-5806 X 36 - BOBRICK	SAFIN FINISH
1-7	HOCP GRAB BAR (42")	B-5806 X 42 - BOBRICK	SAFIN FINISH
1-8	MIRROR 18" (W) X 36" (H)	B-290 - BOBRICK	TO BE SUPPLIED BY VENDOR/ TO BE INSTALLED BY CONTRACTOR
1-9	SANITARY NAPRIN DISPOSAL	B-270 - BOBRICK	TO BE SUPPLIED BY VENDOR/ TO BE INSTALLED BY CONTRACTOR
1-10	CAINT HOOK	B-6827 - BOBRICK	REQUIRED AT THE BACK OF EACH BATHROOM DOOR

**TOILET ACCESSORY SCHEDULE**

ROOM NO.	ROOM NAME	FLOOR	MAT.	FIN.	COL.	BASE	MAT.	FIN.	COL.	WALL	MAT.	FIN.	COL.	CEILING	MAT.	FIN.	COL.	HEIGHT	REMARKS
138A	CLASSROOM	CONC	VCT	201	401	GWB	PT	901/902	ACP	601	9'-0"	VCT AT HALLWAY							
138B	EXISTING STORAGE	CONC	VCT	301	401	GWB	PT	901	ACP	601	9'-0"								
138C	EXISTING STORAGE	CONC	VCT	301	401	GWB	PT	901	ACP	601	9'-0"								
138D	BRKCK ROOM	CONC	VCT	301	401	GWB	PT	901	ACP	601	9'-0"								
138E	MEN'S TOILET	CONC	CT	201	402	GWB	PT	901/202	ACP	601	9'-0"								
138E	WOMEN'S TOILET	CONC	CT	201	402	GWB	PT	901/202	ACP	601	9'-0"								

**ROOM FINISH SCHEDULE**

ROOM NO.	ROOM NAME	FLOOR	MAT.	FIN.	COL.	BASE	MAT.	FIN.	COL.	WALL	MAT.	FIN.	COL.	CEILING	MAT.	FIN.	COL.	HEIGHT	REMARKS
138A	CLASSROOM	CONC	VCT	201	401	GWB	PT	901/902	ACP	601	9'-0"	VCT AT HALLWAY							
138B	EXISTING STORAGE	CONC	VCT	301	401	GWB	PT	901	ACP	601	9'-0"								
138C	EXISTING STORAGE	CONC	VCT	301	401	GWB	PT	901	ACP	601	9'-0"								
138D	BRKCK ROOM	CONC	VCT	301	401	GWB	PT	901	ACP	601	9'-0"								
138E	MEN'S TOILET	CONC	CT	201	402	GWB	PT	901/202	ACP	601	9'-0"								
138E	WOMEN'S TOILET	CONC	CT	201	402	GWB	PT	901/202	ACP	601	9'-0"								

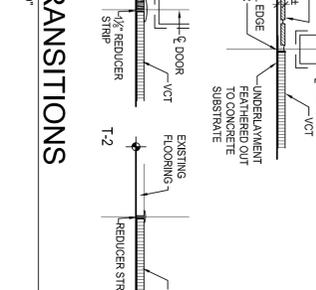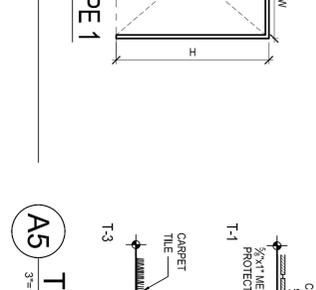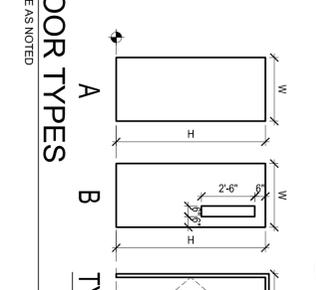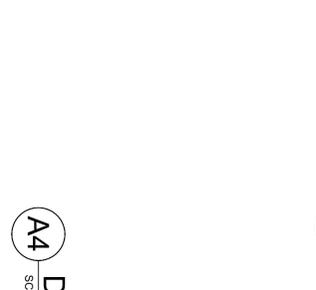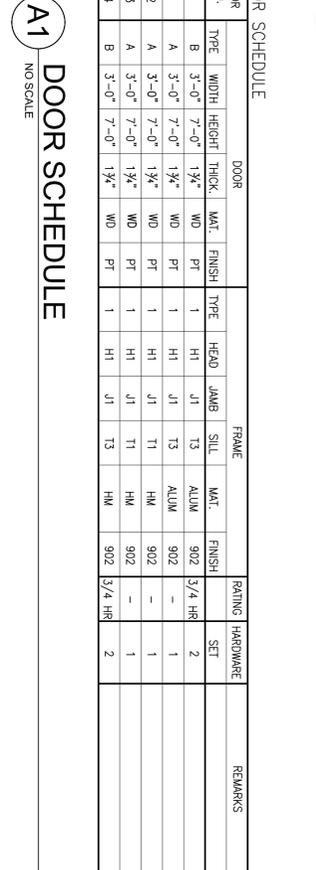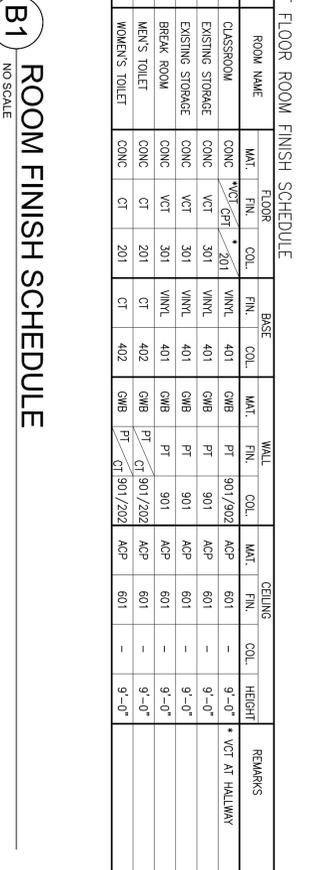

**SCHEDULES, ENLARGED PLAN, ELEVATIONS**

**PROJECT NUMBER:** 43996-C

**DATE:** 2/14/2013

**APPROVED:**

**DESIGNED BY:**

**DRAWN BY:**

**FIELD CHECK:**

**DATE:** 11/13/2012

**NO. DOCUMENTS:** 80

**ADDITIONAL # 1**

**DRAWING NUMBER:** A-401

**SHEET NUMBER:** 3

**SHEET:** 3

**OF:** 11