



---

---

**ADDENDUM NO. 3 TO PROJECT NO. M2891**

**ELECTRICAL WORK  
REPLACE ELECTRICAL DISTRIBUTION SYSTEM – BUILDING 18  
CREEDMOOR PC  
80-45 WINCHESTER BLVD.  
QUEENS VILLAGE, NEW YORK**

November 21, 2011

**NOTE:** This Addendum forms a part of the Contract Documents. Insert it in the Project Manual.  
Acknowledge receipt of this Addendum in the space provided on the Bid Form.

**DRAWINGS**

1. Drawing No. H-100:
  - a. Abatement Notes Column, Add the following note:

“5. All work shown on the abatement drawings is diagrammatic only and shall be coordinated with the Notes on the Electrical Demolition Drawings E-100.”
  
2. Drawing No. H-101:
  - a. Abatement Notes Column, Add the following notes:

“2. All existing conduits to remain shall be cleaned /decontaminated of Asbestos Containing Material. Where conduits are indicated to be removed the same shall be removed and disposed of as Asbestos Containing Material and shall be coordinated with the Notes on Electrical Demolition Drawing E-101.

3. Remove and dispose of all wiring as Asbestos Containing Materials after the same has been disconnected from its power source and shall be coordinated with the Notes Electrical Demolition Drawing E-101”
  
3. Drawing No. H-102:
  - a. Abatement Notes Column, Add the following note:

“5. All work shown on the abatement drawings is diagrammatic only and shall be coordinated with the Notes on the Electrical Demolition Drawing E-102.”

- b. Floor Plan, Revise Note at wall Sconces to read:

“Wall Sconces in Gym Area Shall Be Removed And Decontaminated Of Asbestos Containing Material And Reinstalled.”

4. Drawing H-103:

- a. Abatement Notes Column, Add the following note:

“8. All work shown on the abatement drawings is diagrammatic only and shall be coordinated with the Notes on the Electrical Demolition Drawing E-103.”

5. Revised Drawings:

- a. Drawings Nos. E-100, E-102, E-200, E-201, E-202, E-203 and E-400, noted Addendum 3 dated 11/21/11 accompanies this Addendum and supersedes the same numbered originally issued drawings.

**END OF ADDENDUM**

James Dirolf, P.E.  
Director of Design



NYS OFFICE OF GENERAL SERVICES

Serving New York

ANDREW M. CUOMO  
Governor  
ROANN DESTITO  
Commissioner  
JAMES M. DAVIES, A.L.A.  
Deputy Commissioner, Design and Construction

CONSULTANT

**Lilker Associates**  
Mechanical and Electrical Engineers

1001 Avenue of the Americas  
New York, NY 10018  
tel 212.695.1000  
fax 212.695.1299  
www.lilker.com



**WARNING:**

THE ALTERATION OF THIS MATERIAL IN ANY WAY, UNLESS DONE UNDER THE DIRECTION OF A COMPARABLE PROFESSIONAL, I.E. ARCHITECT FOR AN ARCHITECT, ENGINEER FOR AN ENGINEER OR LANDSCAPE ARCHITECT FOR A LANDSCAPE ARCHITECT, IS A VIOLATION OF THE NEW YORK STATE EDUCATION LAW AND/OR REGULATIONS AND IS A CLASS 'A' MISDEMEANOR.



CONTRACT:

**ELECTRICAL**

TITLE:  
REPLACE ELECTRICAL DISTRIBUTION SYSTEM - BUILDING No. 18

LOCATION:  
CREEDMOOR PC  
80-45 WINCHESTER BLVD  
QUEENS VILLAGE, NY 11427

CLIENT:  
OFFICE OF GENERAL SERVICES


MARK	DATE	DESCRIPTION
△	11/03/2011	ADDENDUM #3
	9/21/2010	ISSUED FOR BID

PROJECT NUMBER:	M2891-E
DESIGNED BY:	JG
DRAWN BY:	NR
FIELD CHECK:	
APPROVED:	
SHEET TITLE:	

DEMOLITION SUB BASEMENT LIGHTING AND POWER PLAN

DRAWING NUMBER:  
E-100


SHEET 3 OF 13

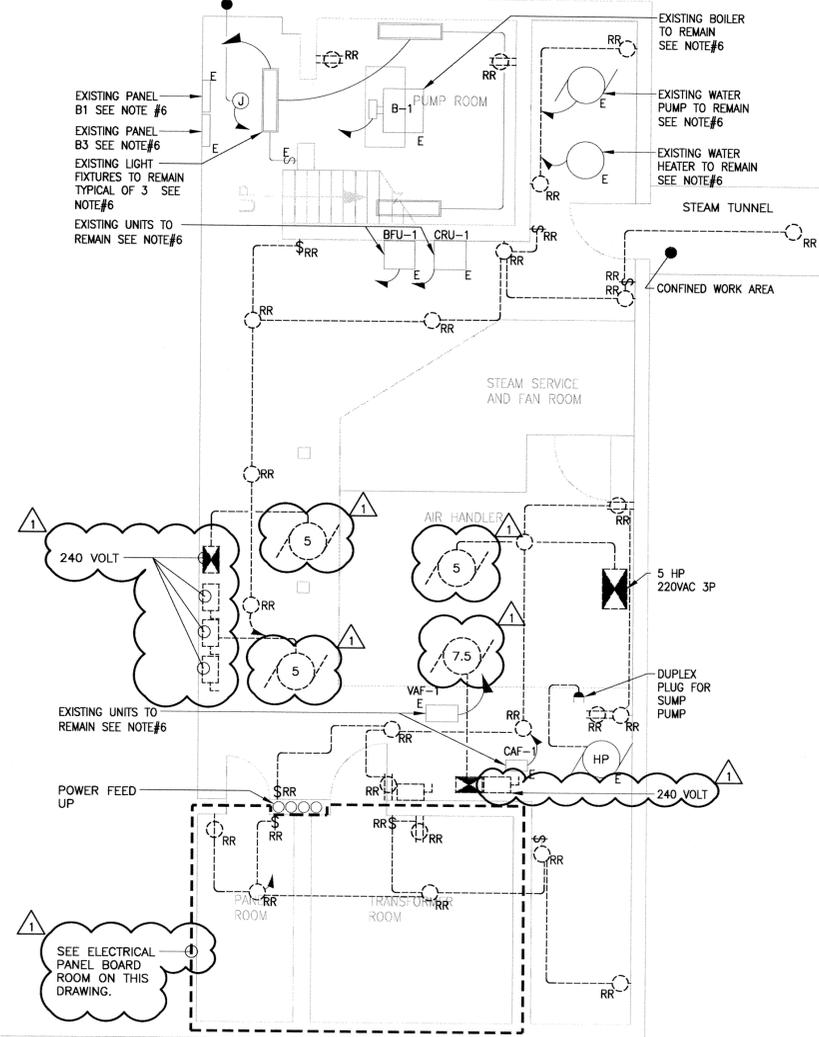

**1 BUILDING 18 - SUB-BASEMENT**

SCALE: 3/16"=1'-0"  
NOTES:

- CONTRACTOR SHALL REMOVE MAIN 4160 VOLT SWITCH AND 3 TRANSFORMERS FROM TRANSFORMER ROOM.
- GROUND BAR SHALL REMAIN IN TRANSFORMER ROOM.
- PANEL BOARDS IN PANEL ROOM SHALL BE REMOVED IN THEIR ENTIRETY.
- ALL CONDUITS INDICATED ON DRAWINGS ARE EXISTING TO REMAIN.
- ALL EXISTING WIRING SHALL BE REMOVED. CLEAN CONDUIT AND INSTALL DRAG LINE. REPORT TO THE DIRECTOR'S REPRESENTATIVE ANY BLOCKAGE, AND LOCATION, IN CONDUIT THAT CANNOT BE CLEANED.
- EXISTING EQUIPMENT AND WIRING TO REMAIN, EQUIPMENT TO BE INSTALLED UNDER NEW BOILER PROJECT OGS# 43369-H. COORDINATE WITH OGS AND CONTRACTOR.

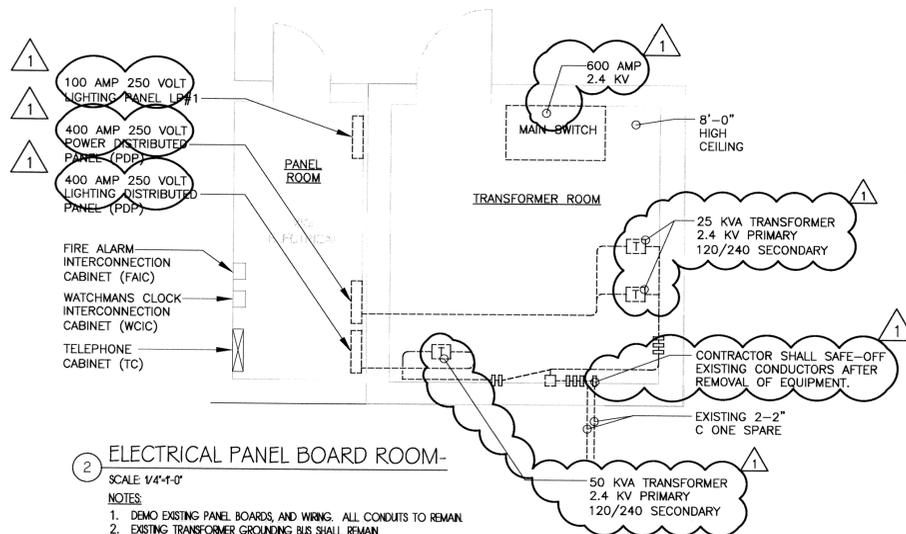

**2 ELECTRICAL PANEL BOARD ROOM-**

SCALE: 1/4"=1'-0"

NOTES:

- DEMO EXISTING PANEL BOARDS, AND WIRING. ALL CONDUITS TO REMAIN.
- EXISTING TRANSFORMER GROUNDING BUS SHALL REMAIN.

GRAPHIC SCALE:  
SCALE: 3/16"=1'-0"

CONSULTANT

**Lilker Associates**  
Mechanical and Electrical Engineers

1001 Avenue of the Americas  
New York, NY 10018  
tel 212.695.1000  
fax 212.695.1299  
www.lilker.com



WARNING:

THE ALTERATION OF THIS MATERIAL IN ANY WAY, UNLESS DONE UNDER THE DIRECTION OF A COMPARABLE PROFESSIONAL, I.E. ARCHITECT FOR AN ARCHITECT, ENGINEER FOR AN ENGINEER OR LANDSCAPE ARCHITECT FOR A LANDSCAPE ARCHITECT, IS A VIOLATION OF THE NEW YORK STATE EDUCATION LAW AND/OR REGULATIONS AND IS A CLASS 4 MISDEMEANOR.




CONTRACT:

**ELECTRICAL**

TITLE:  
REPLACE ELECTRICAL DISTRIBUTION SYSTEM - BUILDING No. 18

LOCATION:  
CREEDMOOR PC  
80-45 WINCHESTER BLVD  
QUEENS VILLAGE, NY 11427

CLIENT:  
OFFICE OF GENERAL SERVICES

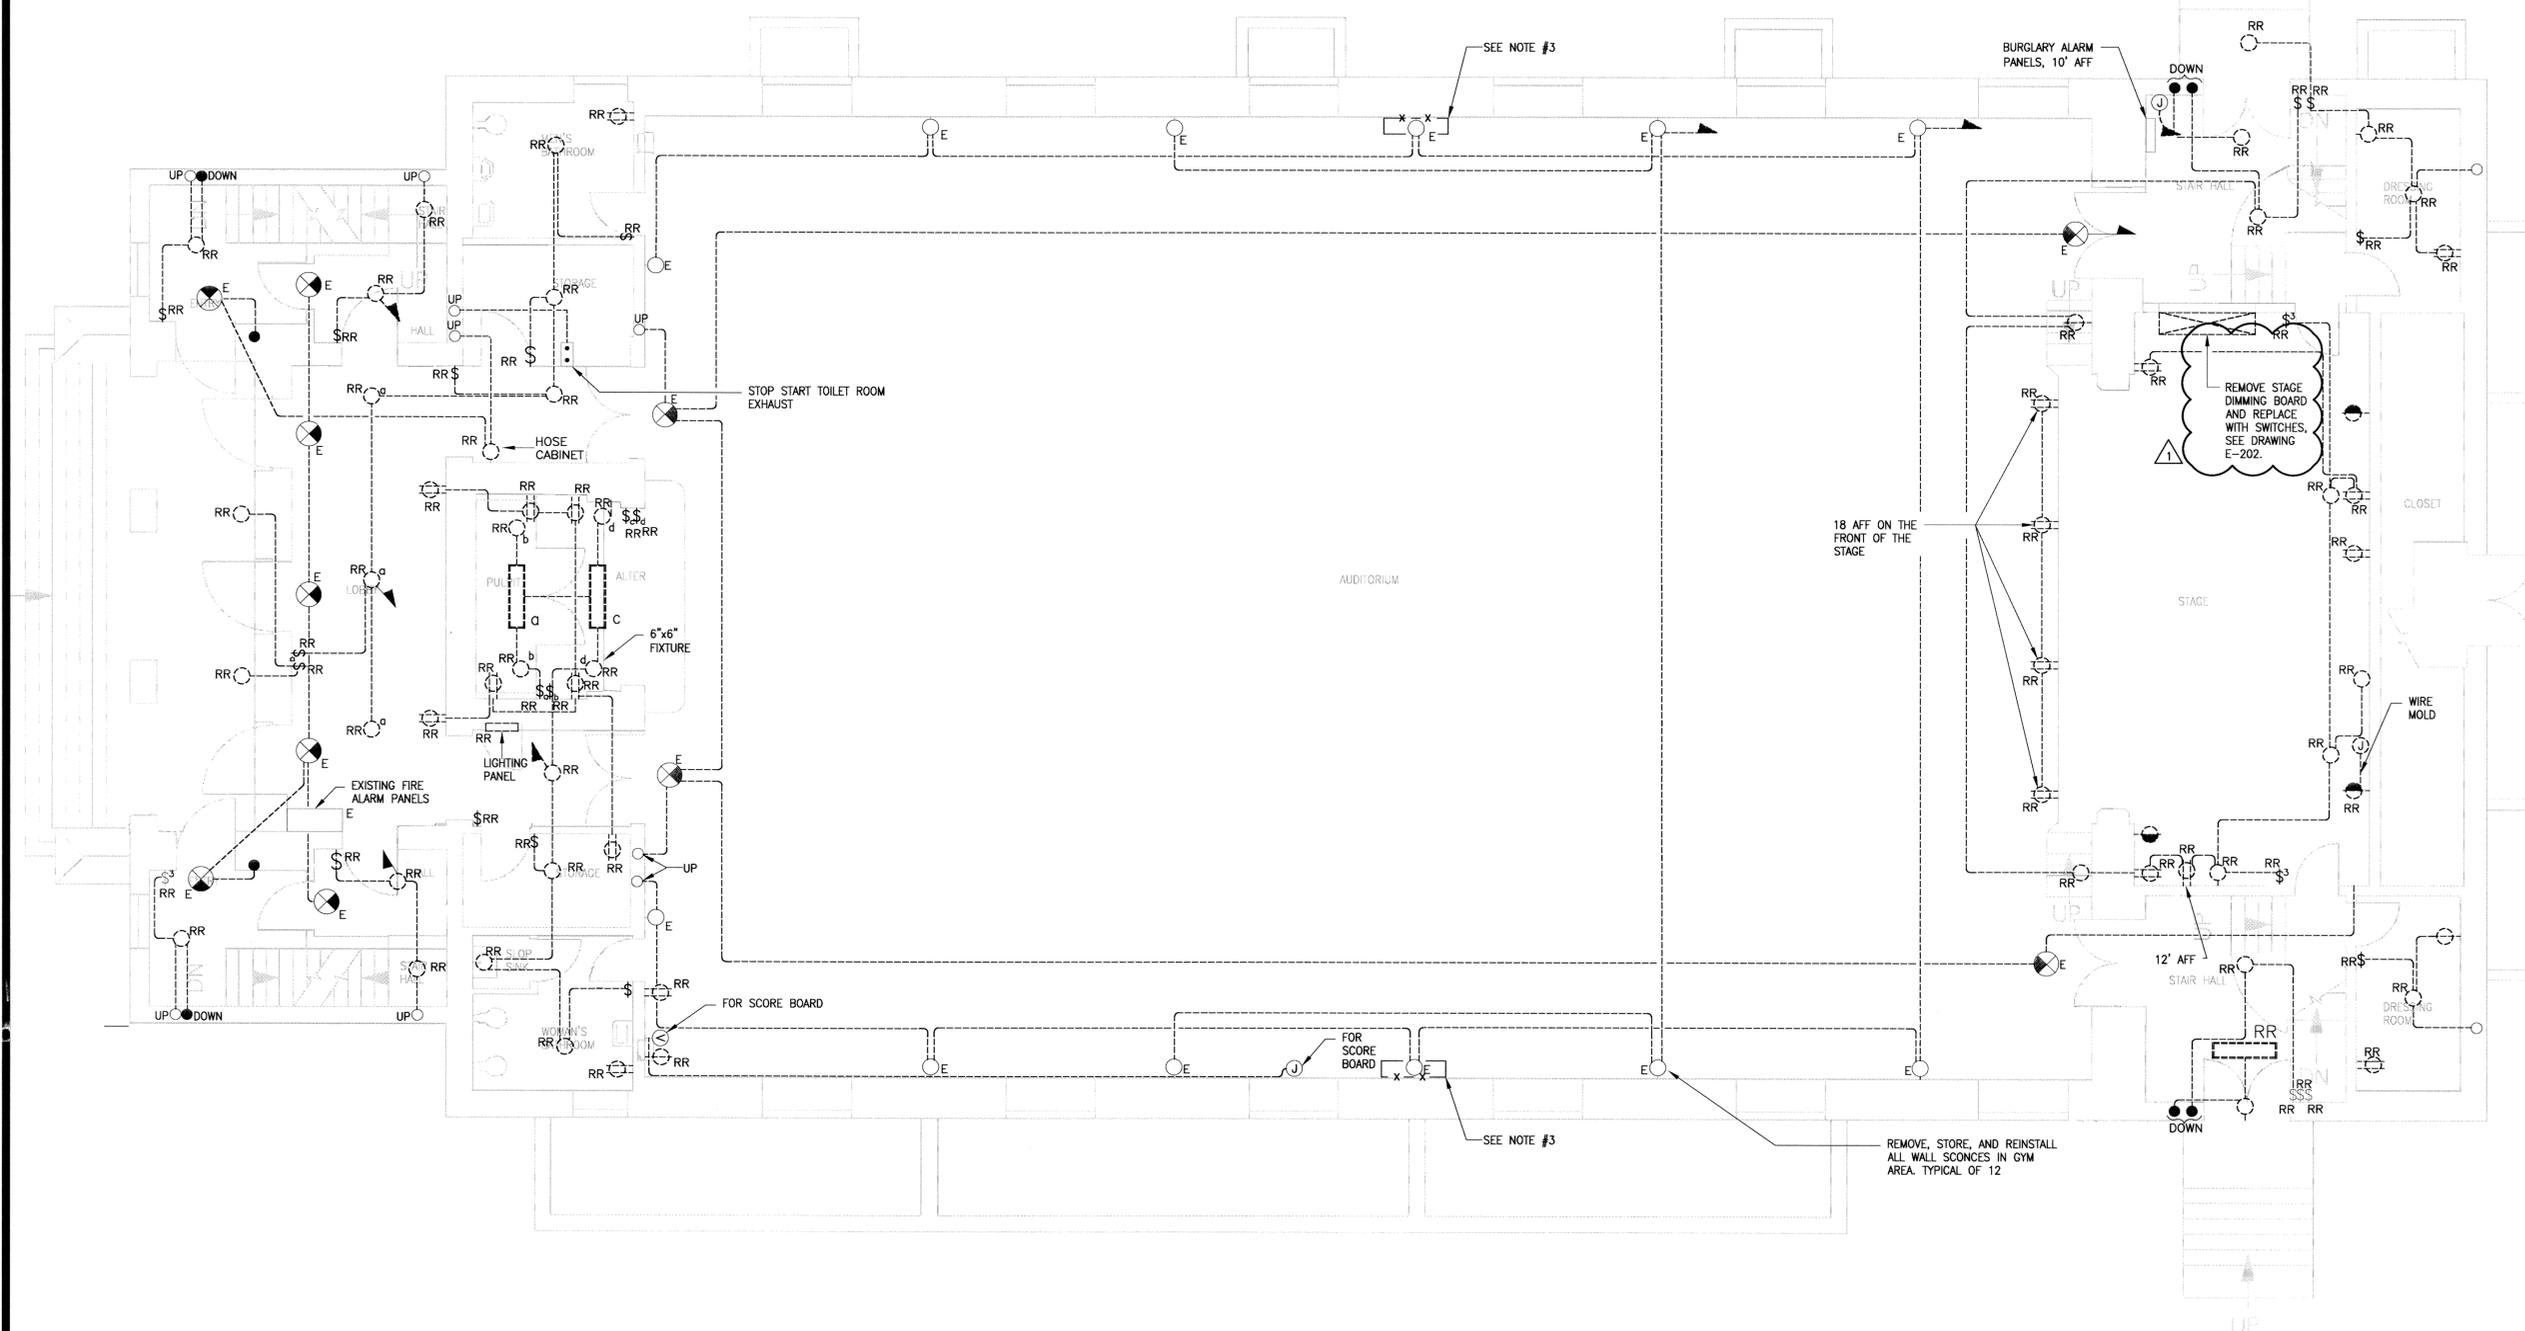

**BUILDING 18 - FIRST FLOOR**

SCALE 3/16"=1'-0"



- ALL CONDUIT INDICATED ON DRAWINGS IS EXISTING TO REMAIN U.O.N.
- ALL ELECTRICAL WIRING IS TO BE REMOVED. CLEAN CONDUIT AND INSTALL DRAG LINE. REPORT TO DIRECTOR'S REPRESENTATIVE ANY BLOCKAGE, AND LOCATION, IN CONDUIT THAT CANNOT BE CLEANED.
- REMOVE EXISTING WALL MOUNTED EMERGENCY FIXTURES IN THEIR ENTIRETY. INCLUDING CONDUIT AND WIRE BACK TO SOURCE OF POWER.


GRAPHIC SCALE:  
SCALE 3/16"=1'-0"

	11/03/2011	ADDENDUM #3
	9/21/2010	ISSUED FOR BID

MARK	DATE	DESCRIPTION
PROJECT NUMBER:	M2891-E	
DESIGNED BY:	JG	
DRAWN BY:	NR	
FIELD CHECK:		
APPROVED:		
SHEET TITLE:		

DEMOLITION FIRST FLOOR LIGHTING AND POWER PLAN

DRAWING NUMBER:  
E-102

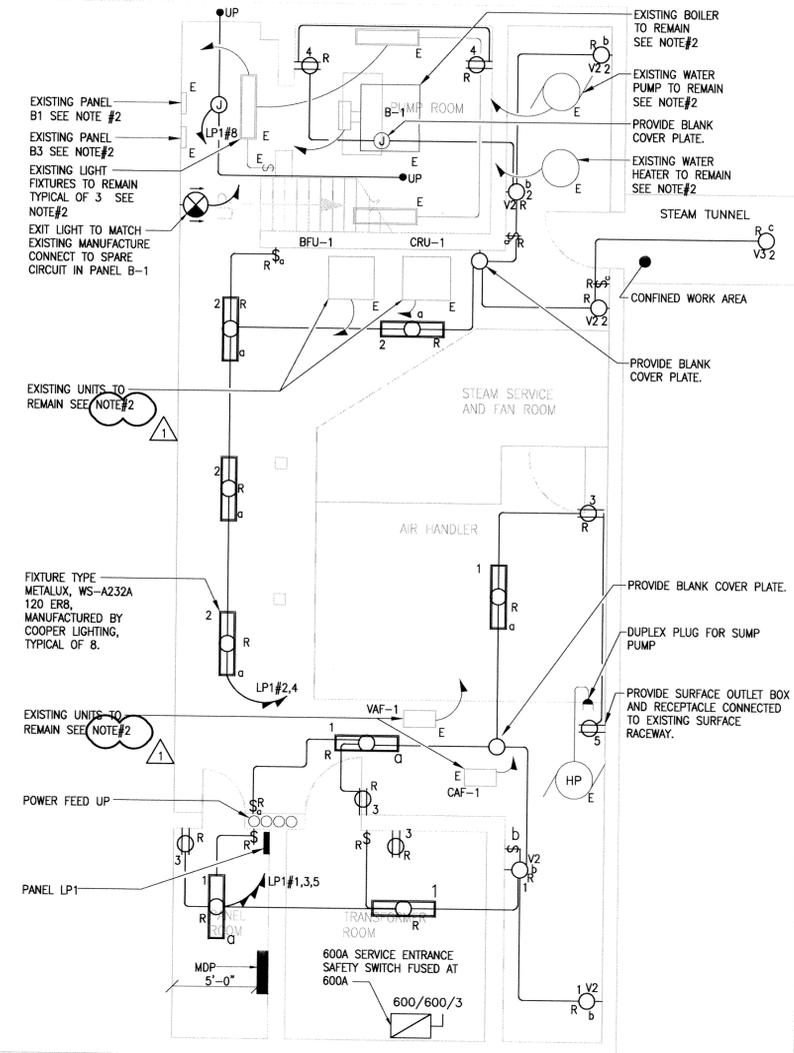

**BUILDING 18 - SUB-BASEMENT**  
SCALE 3/16"=1'-0"

- 1 ALL BRANCH CIRCUIT WIRING SHALL BE #10 AWG, U.O.N. ALL NEW WIRING SHALL BE RUN IN EXISTING CONDUIT.
- 2 EXISTING EQUIPMENT AND WIRING TO REMAIN, EQUIPMENT TO BE INSTALLED UNDER NEW BOILER PROJECT OGS# 43369-H. COORDINATE WITH OGS AND CONTRACTOR.

GRAPHIC SCALE  
SCALE 3/16"=1'-0"



ANDREW M. CUOMO  
Governor  
ROANN DESTITTO  
Commissioner  
JAMES M. DAVIES, A.I.A.  
Deputy Commissioner, Design and Construction

**Lilker Associates**  
Mechanical and Electrical Engineers  
1001 Avenue of the Americas  
New York, NY 10018  
tel 212.695.1000  
fax 212.695.1299  
www.lilker.com

**WARNING:**  
THE ALTERATION OF THIS MATERIAL IN ANY WAY, UNLESS DONE UNDER THE DIRECTION OF A COMPARABLE PROFESSIONAL, I.E. ARCHITECT FOR AN ARCHITECT, ENGINEER FOR AN ENGINEER OR LANDSCAPE ARCHITECT FOR A LANDSCAPE ARCHITECT, IS A VIOLATION OF THE NEW YORK STATE EDUCATION LAW AND/OR REGULATIONS AND IS A CLASS 'A' MISDEMEANOR.



CONTRACT: **ELECTRICAL**  
TITLE: **REPLACE ELECTRICAL DISTRIBUTION SYSTEM - BUILDING No. 18**  
LOCATION: **CREEDMOOR PC  
80-45 WINCHESTER BLVD  
QUEENS VILLAGE, NY 11427**  
CLIENT: **OFFICE OF GENERAL SERVICES**

MARK	DATE	DESCRIPTION
△	11/03/2011	ADDENDUM #3
	9/21/2010	ISSUED FOR BID
PROJECT NUMBER: M2891-E		
DESIGNED BY: JG		
DRAWN BY: NR		
FIELD CHECK:		
APPROVED:		
SHEET TITLE:		

SUB BASEMENT  
LIGHTING AND POWER  
PLAN

DRAWING NUMBER: **E-200**

**WARNING:**  
THE ALTERATION OF THIS MATERIAL IN ANY WAY, UNLESS DONE UNDER THE DIRECTION OF A COMPARABLE PROFESSIONAL, I.E. ARCHITECT FOR AN ARCHITECT, ENGINEER FOR AN ENGINEER OR LANDSCAPE ARCHITECT FOR A LANDSCAPE ARCHITECT, IS A VIOLATION OF THE NEW YORK STATE EDUCATION LAW AND/OR REGULATIONS AND IS A CLASS "A" MISDEMEANOR.



CONTRACT:

**ELECTRICAL**

TITLE:  
REPLACE ELECTRICAL DISTRIBUTION SYSTEM - BUILDING No. 18

LOCATION:  
CREEDMOOR PC  
80-45 WINCHESTER BLVD  
QUEENS VILLAGE, NY 11427

CLIENT:  
OFFICE OF GENERAL SERVICES

REVISIONS:


MARK	DATE	DESCRIPTION
1	11/03/2011	ADDENDUM #3
	9/21/2010	ISSUED FOR BID
PROJECT NUMBER:	M2891-E	
DESIGNED BY:	JG	
DRAWN BY:	NR	
FIELD CHECK:		
APPROVED:		
SHEET TITLE:		

BASEMENT LIGHTING AND POWER PLAN

DRAWING NUMBER:

E-201

SHEET 8 OF 13

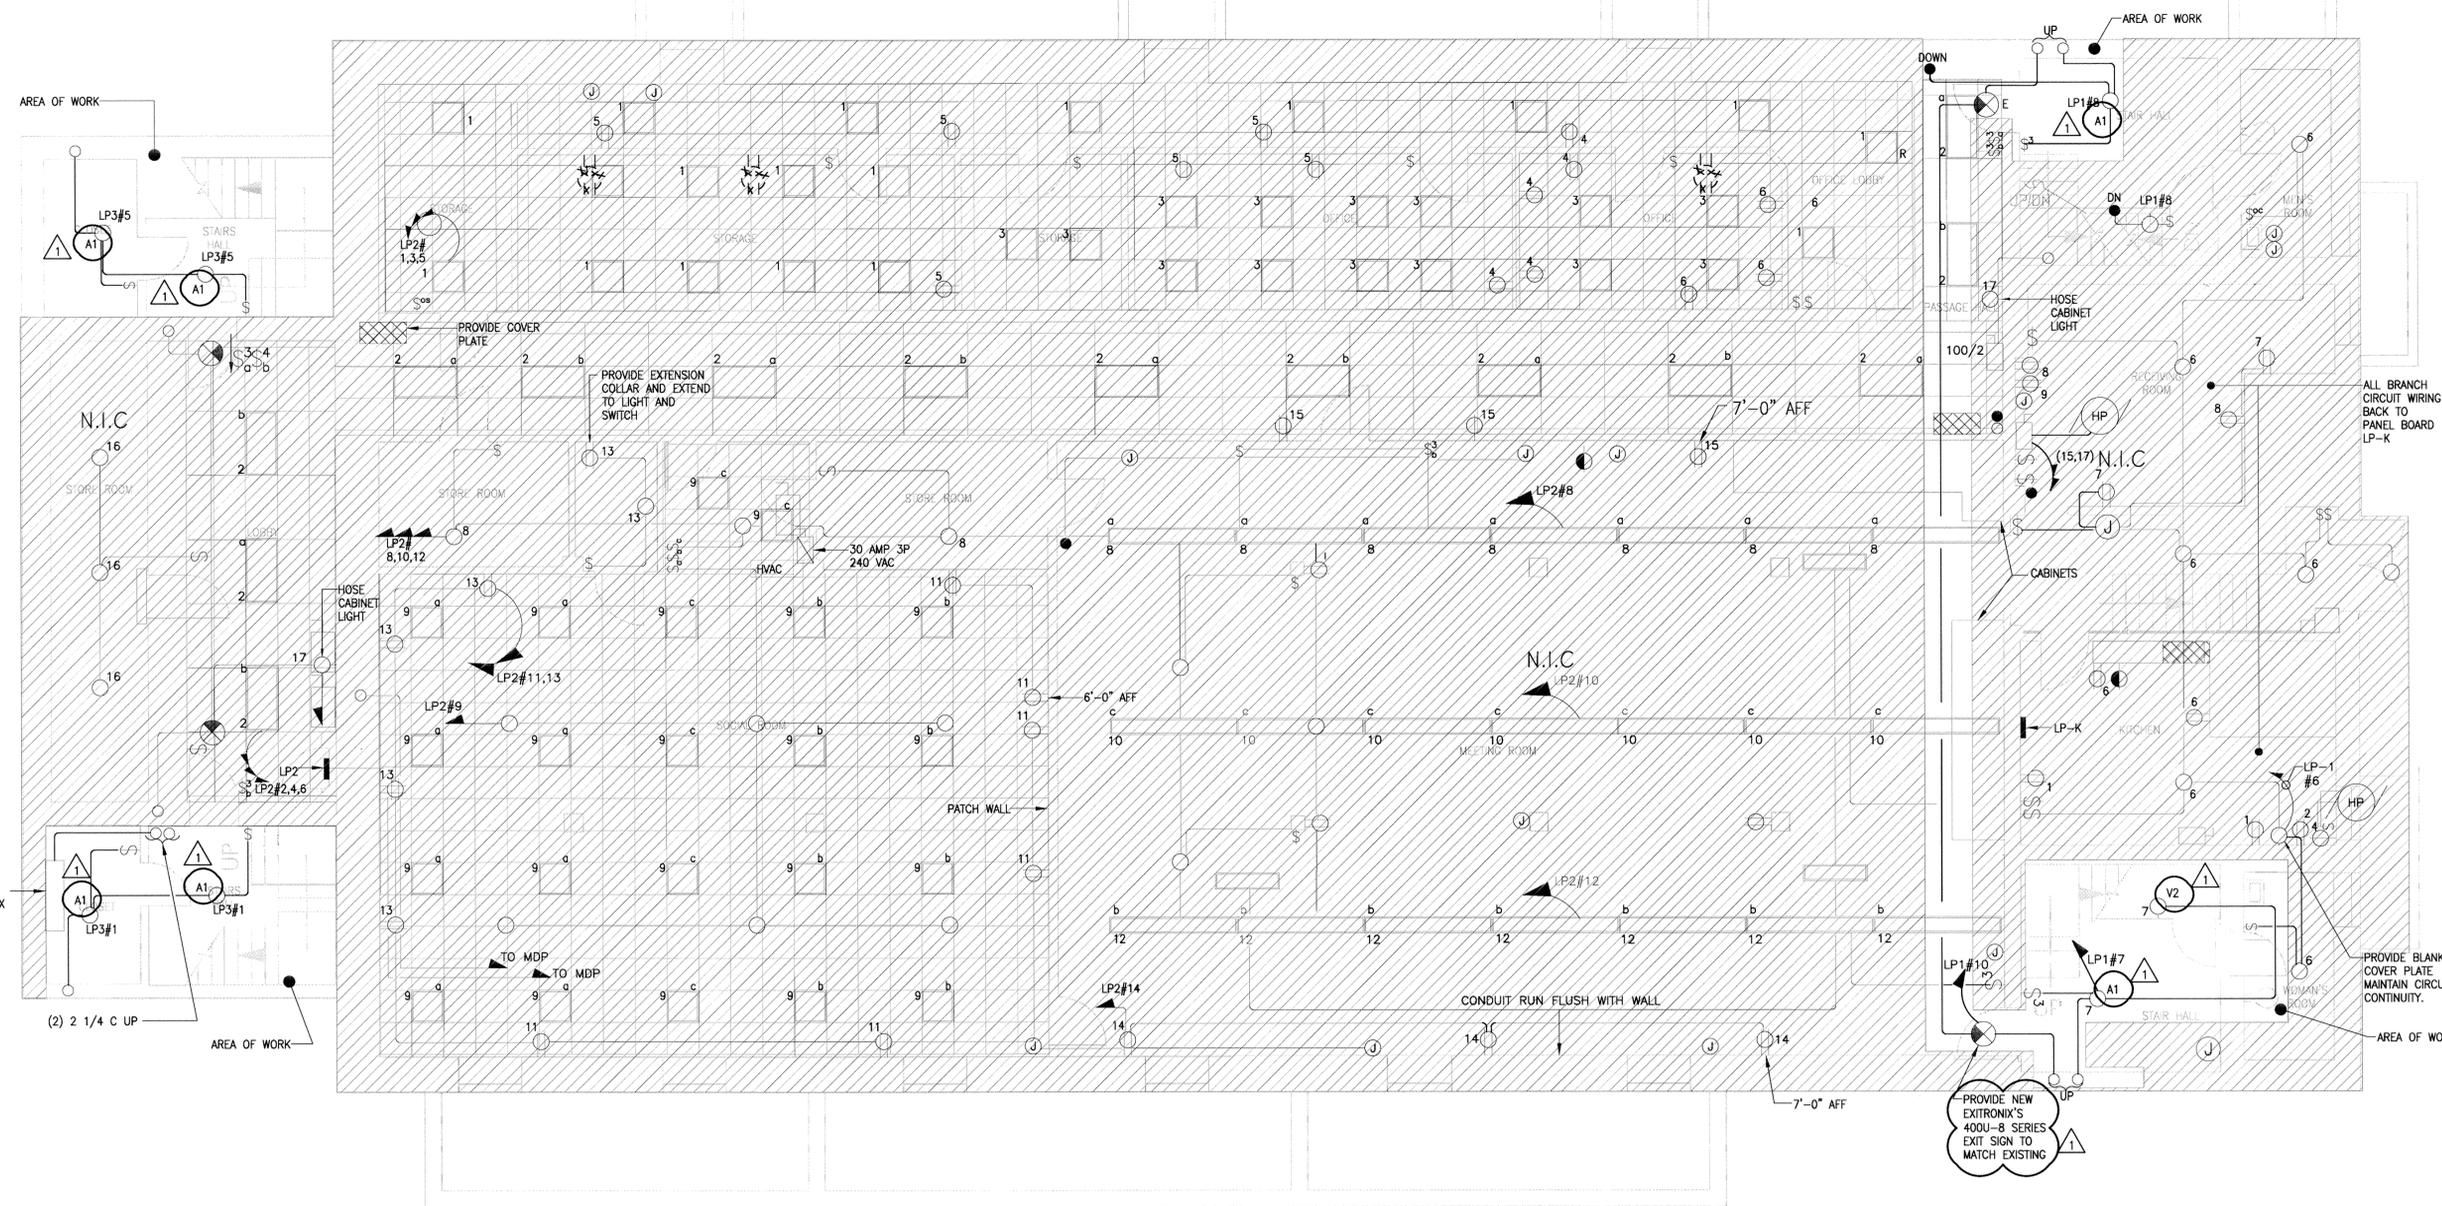

**BUILDING 18 - BASEMENT**


SCALE: 3/16"=1'-0"

NOTES:

- 1 ALL BRANCH CIRCUIT WIRING SHALL BE #10 AWG, U.O.N. ALL NEW WIRING SHALL BE RUN IN EXISTING CONDUIT.
- 2 ENTIRE BASEMENT IS N.I.C. UNLESS OTHERWISE NOTED.




GRAPHIC SCALE  
SCALE: 3/16"=1'-0"

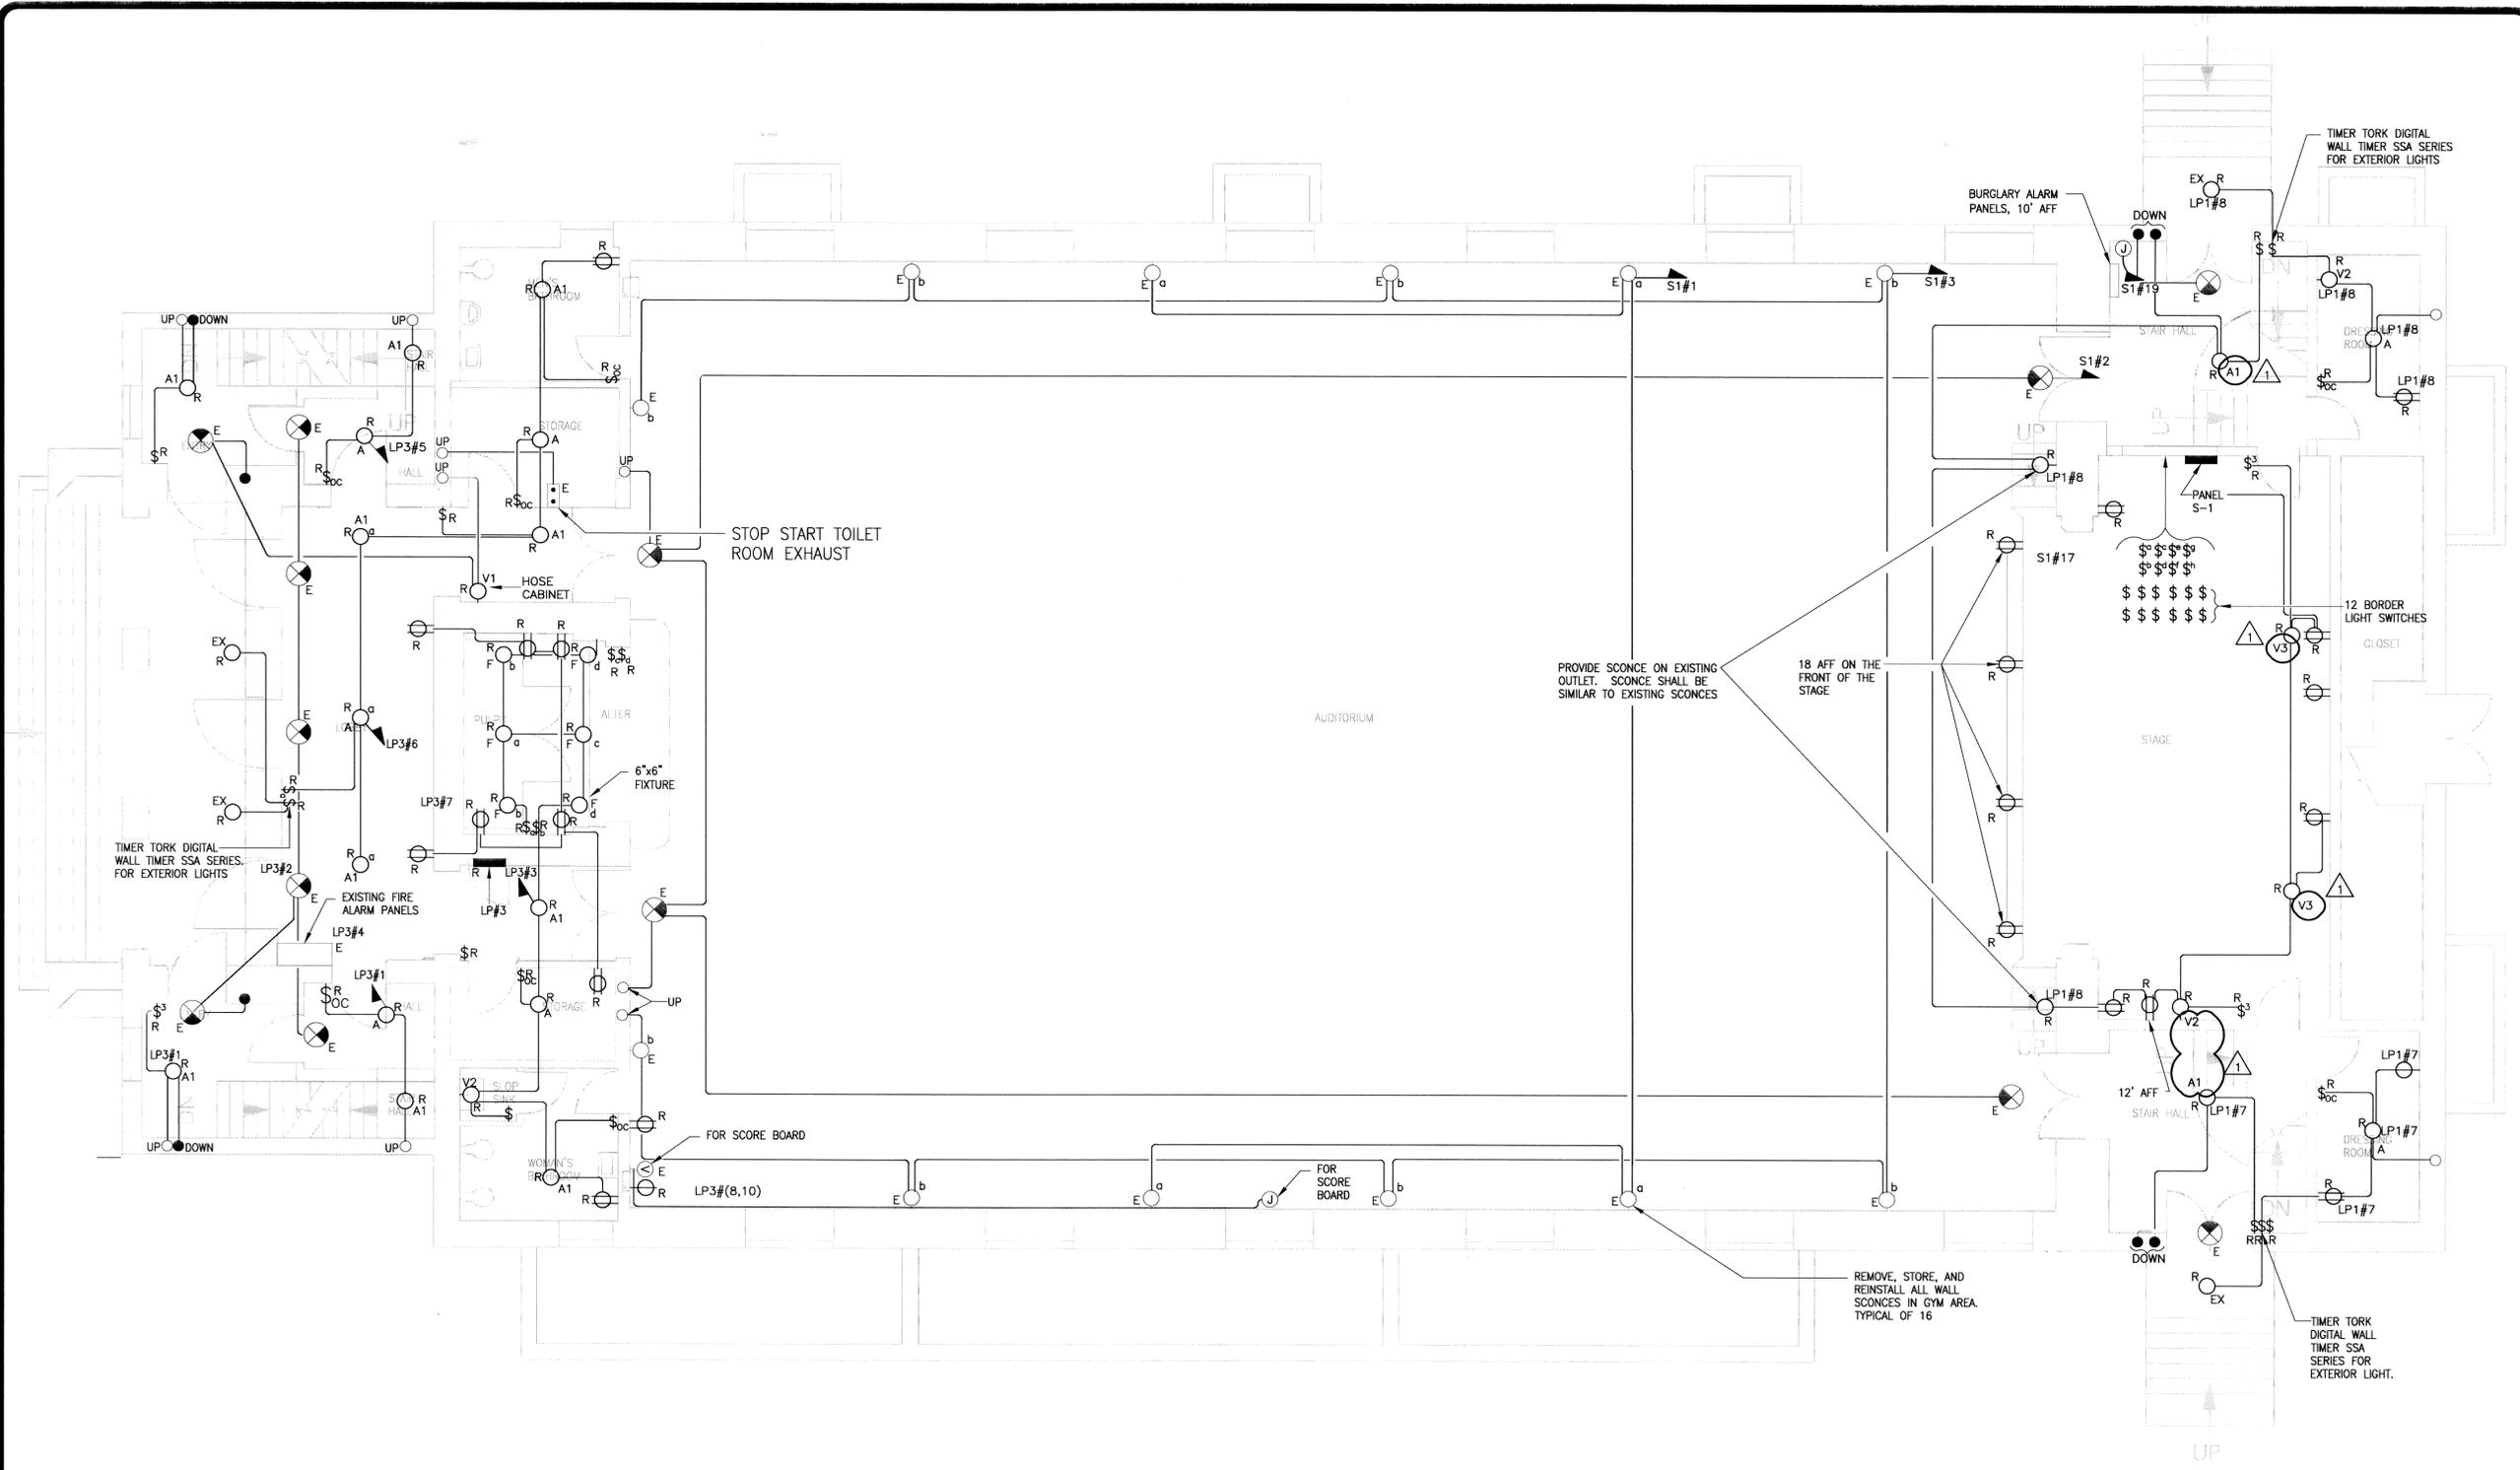

**BUILDING 18 - FIRST FLOOR**  
SCALE 3/16"=1'-0"

- NOTES:
1. ALL EXIT SIGNS ARE EXISTING TO REMAIN, U.O.N.
  2. ALL BRANCH CIRCUIT WIRING SHALL BE #10AWG, U.O.N.. ALL NEW WIRING SHALL BE RUN IN EXISTING CONDUIT.
  3. EXISTING FIRE ALARM, SECURITY SYSTEM, AND TELEPHONE WIRING SHALL REMAIN IN ITS ENTIRETY INCLUDING WIRING AND CONDUIT, U.O.N.

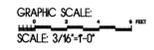

NYS OFFICE OF GENERAL SERVICES  
 Serving New York  
 ANDREW M. CUOMO  
 Governor  
 ROANN DESTITO  
 Commissioner  
 JAMES M. DAVIES, A.I.A.  
 Deputy Commissioner, Design and Construction

CONSULTANT  
**Lilker Associates**  
 Mechanical and Electrical Engineers  
 1001 Avenue of the Americas  
 New York, NY 10018  
 tel 212.695.1000  
 fax 212.695.1299  
 www.lilker.com



WARNING:  
 THE ALTERATION OF THIS MATERIAL IN ANY WAY, UNLESS DONE UNDER THE DIRECTION OF A COMPARABLE PROFESSIONAL, I.E. ARCHITECT FOR AN ARCHITECT, ENGINEER FOR AN ENGINEER OR LANDSCAPE ARCHITECT FOR A LANDSCAPE ARCHITECT, IS A VIOLATION OF THE NEW YORK STATE EDUCATION LAW AND/OR REGULATIONS AND IS A CLASS 'A' MISDEMEANOR.



CONTRACT: **ELECTRICAL**

TITLE:  
 REPLACE ELECTRICAL DISTRIBUTION SYSTEM - BUILDING No. 18

LOCATION:  
 CREEDMOOR PC  
 80-45 WINCHESTER BLVD  
 QUEENS VILLAGE, NY 11427

CLIENT:  
 OFFICE OF GENERAL SERVICES

MARK	DATE	DESCRIPTION
1	11/03/2011	ADDENDUM #3
	9/21/2010	ISSUED FOR BID

PROJECT NUMBER: M2891-E  
 DESIGNED BY: JG  
 DRAWN BY: NR  
 FIELD CHECK:  
 APPROVED:  
 SHEET TITLE:

FIRST FLOOR LIGHTING AND POWER PLAN  
 DRAWING NUMBER: E-202

**WARNING:**

THE ALTERATION OF THIS MATERIAL IN ANY WAY, UNLESS DONE UNDER THE DIRECTION OF A COMPARABLE PROFESSIONAL, I.E. ARCHITECT FOR AN ARCHITECT, ENGINEER FOR AN ENGINEER OR LANDSCAPE ARCHITECT FOR A LANDSCAPE ARCHITECT, IS A VIOLATION OF THE NEW YORK STATE EDUCATION LAW AND/OR REGULATIONS AND IS A CLASS 'A' MISDEMEANOR.



**CONTRACT:**

**ELECTRICAL**

**TITLE:**  
 REPLACE ELECTRICAL DISTRIBUTION SYSTEM - BUILDING No. 18


**LOCATION:**  
 CREEDMOOR PC  
 80-45 WINCHESTER BLVD  
 QUEENS VILLAGE, NY 11427

**CLIENT:**  
 OFFICE OF GENERAL SERVICES

MARK	DATE	DESCRIPTION
1	11/03/2011	ADDENDUM #3
	9/21/2010	ISSUED FOR BID
PROJECT NUMBER:	M2891-E	
DESIGNED BY:	JG	
DRAWN BY:	NR	
FIELD CHECK:		
APPROVED:		
SHEET TITLE:		


**SECOND FLOOR LIGHTING AND POWER PLAN**

DRAWING NUMBER:  
**E-203**

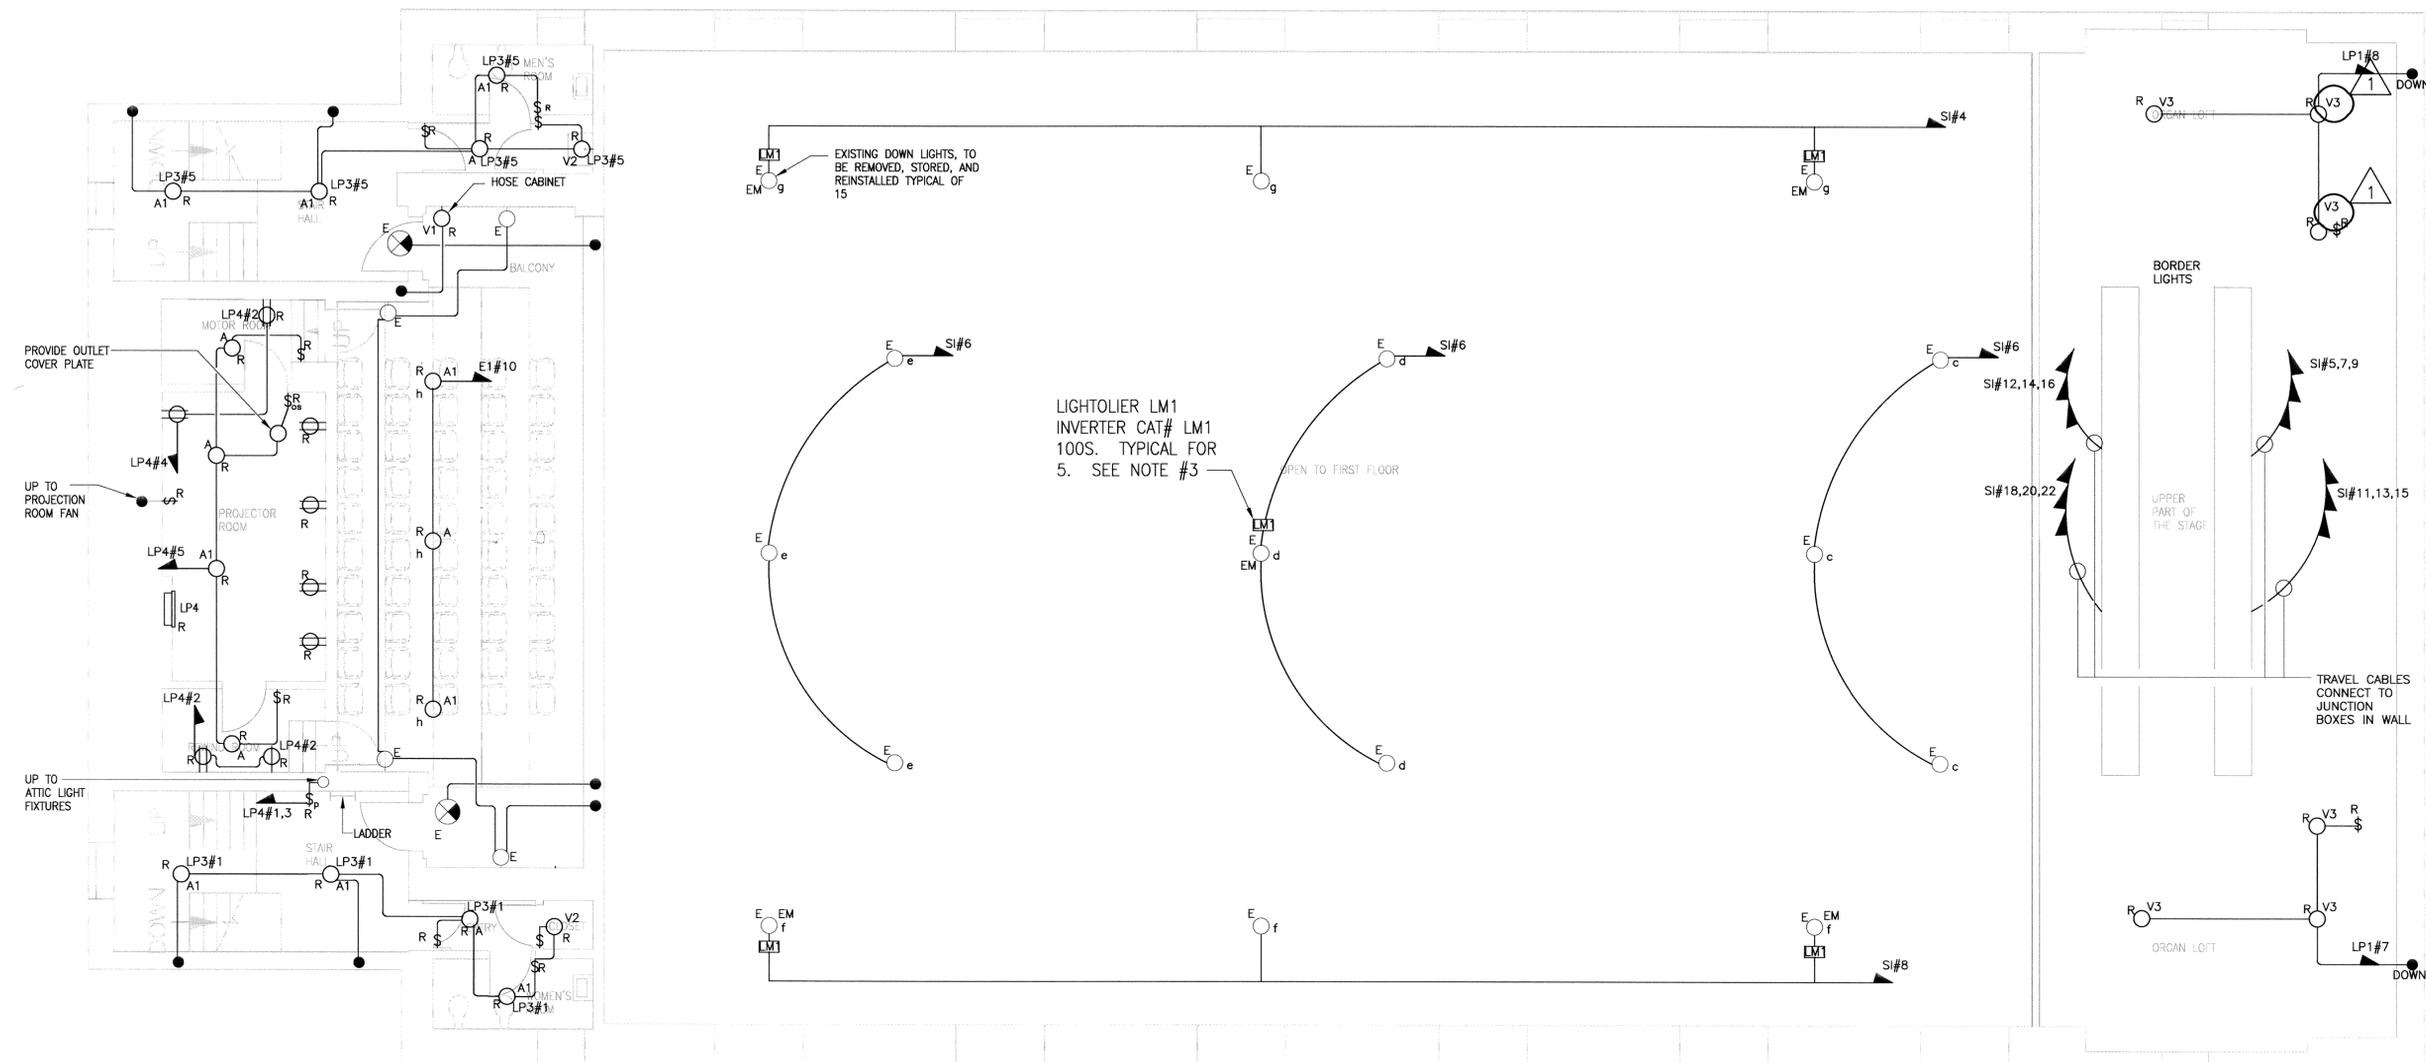

**BUILDING 18 - SECOND FLOOR**  
 SCALE 3/16"=1'-0"

- EXISTING EXIT LIGHTS TO REMAIN.
- EXISTING ASSEMBLY HALL LIGHTS TO REMAIN.
- CONTRACTOR SHALL INSTALL LM1 INVERTERS AS INDICATED TO SERVICE EXISTING LIGHT FIXTURES WHILE INSTALLING NEW WIRING.
- PROVIDE NEW FIXTURE WHIPS FOR ASSEMBLY HALL LIGHTS.
- REMOVE AND REPLACE 12 EXISTING ATTIC LIGHT FIXTURES WITH 12 NEW TYPE V3 COMPACT FLUORESCENT LIGHT FIXTURES.

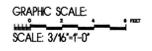

CONSULTANT

**Lilker Associates**  
 Mechanical and Electrical Engineers

1001 Avenue of the Americas  
 New York, NY 10018  
 tel 212.695.1000  
 fax 212.695.1299  
 www.lilker.com



**WARNING:**

THE ALTERATION OF THIS MATERIAL IN ANY WAY, UNLESS DONE UNDER THE DIRECTION OF A COMPARABLE PROFESSIONAL, I.E. ARCHITECT FOR AN ARCHITECT, ENGINEER FOR AN ENGINEER OR LANDSCAPE ARCHITECT FOR A LANDSCAPE ARCHITECT, IS A VIOLATION OF THE NEW YORK STATE EDUCATION LAW AND/OR REGULATIONS AND IS A CLASS 'A' MISDEMEANOR.




CONTRACT:

**ELECTRICAL**

TITLE:  
 REPLACE ELECTRICAL DISTRIBUTION SYSTEM - BUILDING No. 18

LOCATION:  
 CREEDMOOR PC  
 80-45 WINCHESTER BLVD  
 QUEENS VILLAGE, NY 11427

CLIENT:  
 OFFICE OF GENERAL SERVICES

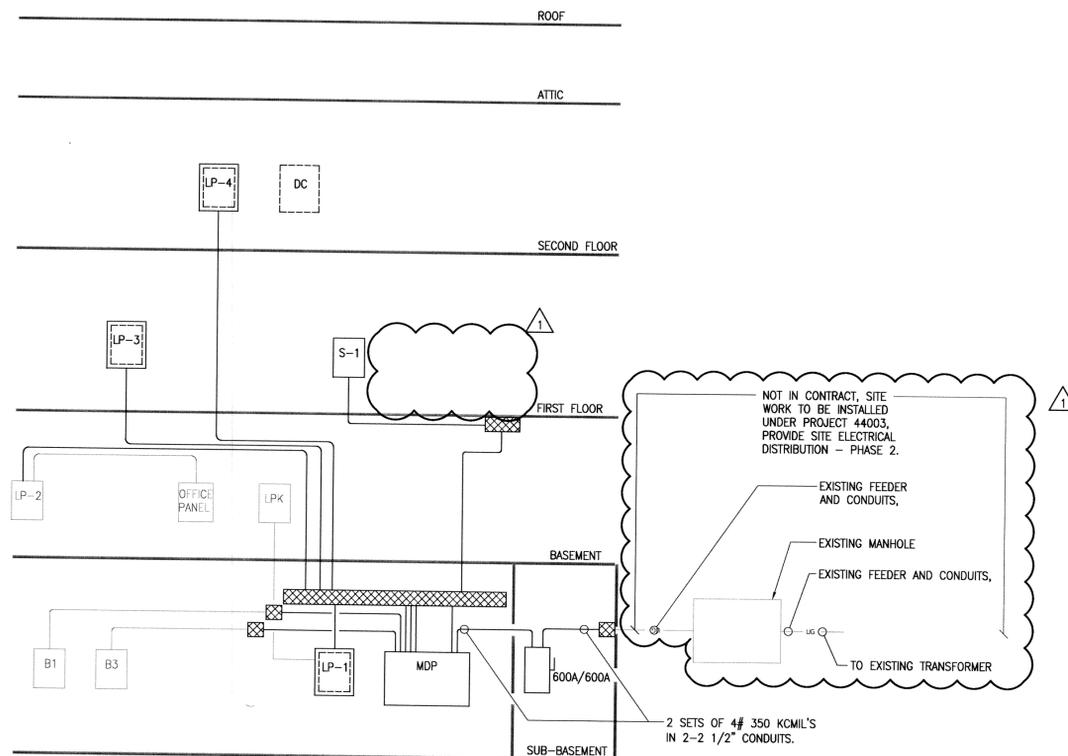

**LIGHT AND POWER RISER:**

SCALE: NONE

NOTES:

1. CONTRACTOR SHALL CONTACT ATLAS SWITCH COMPANY, PRECISION SWITCHBOARD OR EQUAL MANUFACTURERS TO MEASURE EXISTING ~~NAME BOARD BACK BOXES~~. IN ORDER TO CONSTRUCT NEW INTERIORS, STANDARD MANUFACTURED PANELBOARDS WILL NOT BE PERMISSIBLE TO BE INSTALLED IN EXISTING BACK BOXES.

2. REPLACE EXISTING 3/4 HP 208 VOLT OILET EXHAUST FAN WITH NEW ~~COLLECTIONS~~ STARTER/DISCONNECT SWITCH LOCATED IN ATTIC.

3. THE BIDDING, AWARD AND CONSTRUCTION SCHEDULE OF PROJECT 44003 IS UNKNOWN AT THIS TIME. THE BIDDERS SHALL INCLUDE IN THEIR BID A REMOBILIZATION TO COMPLETE THE CONTRACT CLOSEOUT REQUIREMENTS OF THIS CONTRACT ONCE THE NEW FEEDERS HAVE BEEN INSTALLED UNDER PROJECT 44003.

MARK	DATE	DESCRIPTION
△	11/03/2011	ADDENDUM #3
	9/21/2010	ISSUED FOR BID
PROJECT NUMBER:	M2891-E	
DESIGNED BY:	JG	
DRAWN BY:	NR	
FIELD CHECK:		
APPROVED:		
SHEET TITLE:		

**ELECTRICAL RISER DIAGRAM**

DRAWING NUMBER:

E-400