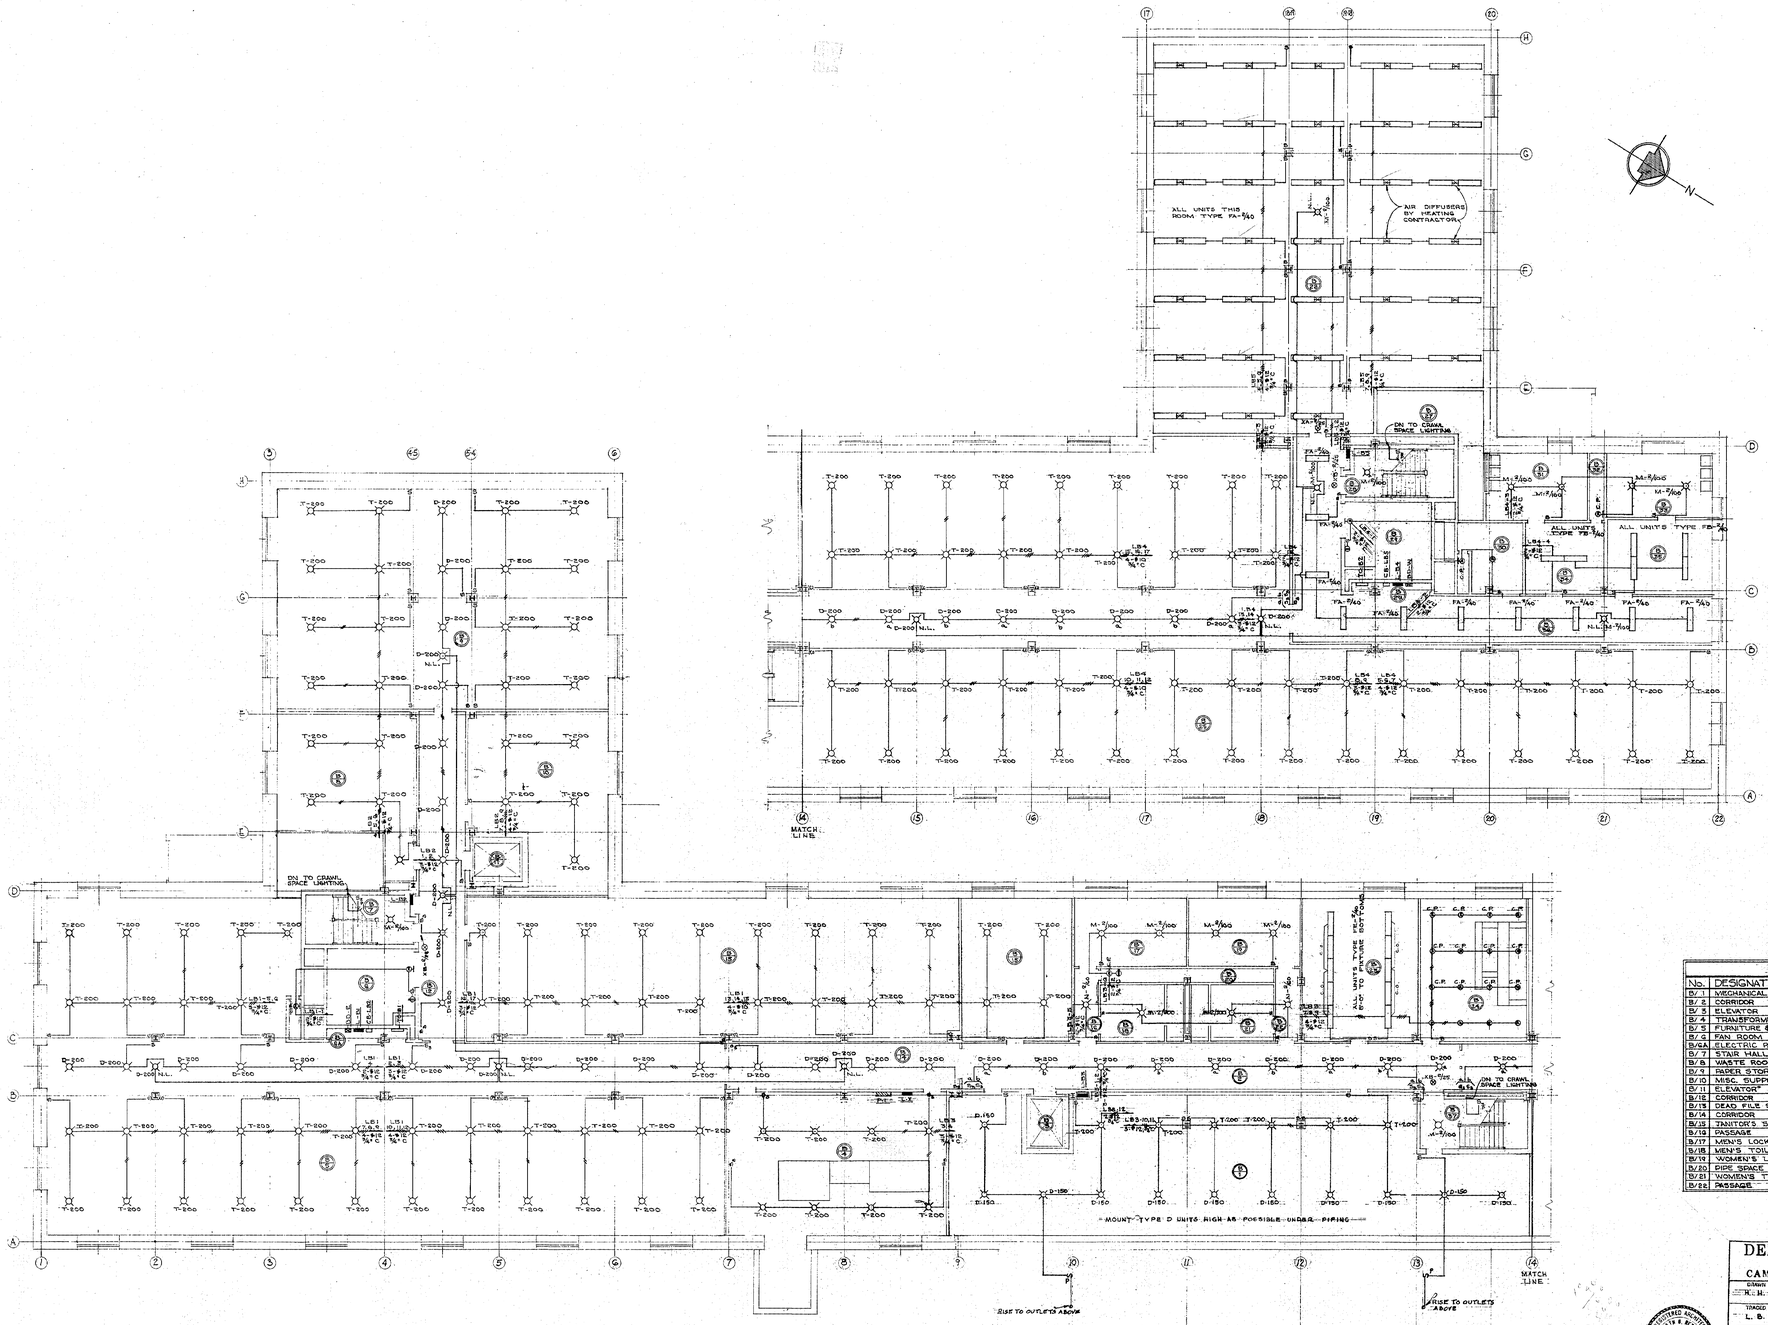

BASEMENT PLAN – LIGHTING

SCALE 1/8" = 1'-0"

NOTES:

1. EXIT LIGHTS, STAIR HALL LIGHTS & NIGHT LIGHTS TO BE CONNECTED FROM PANEL NO. L-X IN ELECTRIC ROOM IN BASEMENT. SEE RISER DIAGRAM DRAWING NO. 54/4011. MOUNT ALL TYPE D-200 UNITS AS HIGH AS POSSIBLE UNDER PIPING.

ROOM SCHEDULE

No.	DESIGNATION	No.	DESIGNATION
B/ 1	MECHANICAL EQUIPMENT	B/23	SUPT. OFFICE
B/ 2	CORRIDOR	B/24	TELEPHONE EQUIPMENT
B/ 3	ELEVATOR	B/25	GENERAL STORAGE
B/ 4	TRANSFORMER ROOM	B/26	STUDENTS & EMPLOYEES LOUNGE
B/ 5	FURNITURE & EQUIP. STORAGE	B/27	AIR PLENUM
B/ 6	FAN ROOM	B/28	STAIR HALL NO. 3
B/6A	ELECTRIC PANEL CLOSET	B/29	FAN ROOM
B/ 7	STAIR HALL NO. 1	B/29A	ELECTRIC PANEL CLOSET
B/ 8	WASTE ROOM	B/30	JANITOR'S CLOSET
B/ 9	PAPER STORAGE	B/31	MEN'S TOILET
B/10	MISC. SUPPLY STORAGE	B/32	PIPE SPACE
B/11	ELEVATOR	B/33	WOMEN'S TOILET
B/12	CORRIDOR	B/34	MEN'S REST ROOM
B/13	DEAD FILE STORAGE	B/35	WOMEN'S REST ROOM
B/14	CORRIDOR	B/36	CORRIDOR
B/15	JANITOR'S SUPPLIES	B/37	STAIR HALL NO. 2
B/16	PASSAGE		
B/17	MEN'S LOCKERS		
B/18	MEN'S TOILET		
B/19	WOMEN'S LOCKERS		
B/20	PIPE SPACE		
B/21	WOMEN'S TOILET		
B/22	PASSAGE		

SCANNED 2005

DEPARTMENT OF CIVIL SERVICE
STATE OFFICE BUILDING
CAMPUS SITE ALBANY NEW YORK

DRAWN BY R. H. P.	ELECTRIC	PROJECT NO. 12978
TRACED BY L. B. F.	BASEMENT PLAN LIGHTING	SPECIFICATION NO. 18884
STRUCTURAL DRAWING BY H. H. P.	KENNETH G. REYNOLDS & ASSOCIATES ARCHITECTS ALBANY, NEW YORK	DATE AUG. 9, 1954
STRUCTURAL CHECKED BY	J. L. OTTENHEIMER CONSULTING ENGINEER ALBANY, NEW YORK	SCALE AS NOTED
FIELD CHECK BY ARCHT.	JOHN A. MAC CORMACK COMMISSIONER OF STANDARDS & PURCHASE STATE OF NEW YORK	DRAWING NO. 54/4002
ENG.	DEPARTMENT OF PUBLIC WORKS DIVISION OF CONSTRUCTION BERTRAM D. TALLAMY SUPERINTENDENT CORNELIUS J. WHITE STATE ARCHITECT	
APPROVED BY		
APPROVED DATE	AUG 2.8 1954	BLDG. # 1

NOTE: DRAWING NOT TO SCALE

NYS OFFICE OF GENERAL SERVICES

Serving New York

ANDREW M. CUOMO
Governor
ROANN M. DESTITO
Commissioner

CONSULTANT

WARNING:

THE ALTERATION OF THIS MATERIAL IN ANY WAY, UNLESS DONE UNDER THE DIRECTION OF A COMPARABLE PROFESSIONAL, I.E. ARCHITECT FOR AN ARCHITECT, ENGINEER FOR AN ENGINEER OR LANDSCAPE ARCHITECT FOR A LANDSCAPE ARCHITECT, IS A VIOLATION OF THE NEW YORK STATE EDUCATION LAW AND/OR REGULATIONS AND IS A CLASS 'A' MISDEMEANOR.

CONTRACT:
CONSTRUCTION

TITLE:
DEMOLISH BUILDING
NOS. 1 & 1A

LOCATION:
STATE OFFICE BUILDING CAMPUS
1220 WASHINGTON AVENUE
ALBANY, N.Y. 12226

CLIENT:
NEW YORK STATE
OFFICE OF GENERAL SERVICES

MARK	DATE	DESCRIPTION
	8/26/13	BID DOCUMENTS

PROJECT NUMBER: 44845 – C

DESIGNED BY:
DRAWN BY:
FIELD CHECK:
APPROVED:

SHEET TITLE:
EXIST. ELECTRICAL REF. DWG.
BASEMENT PLAN
LIGHTING

DRAWING NUMBER:
54–4002

SHEET OF

Sep 12,2013 – 10:23am
V:\Designed\Consult\p44845\CadStrc\ELEC\54-4002.dwg
36x24 PLOT SHEET

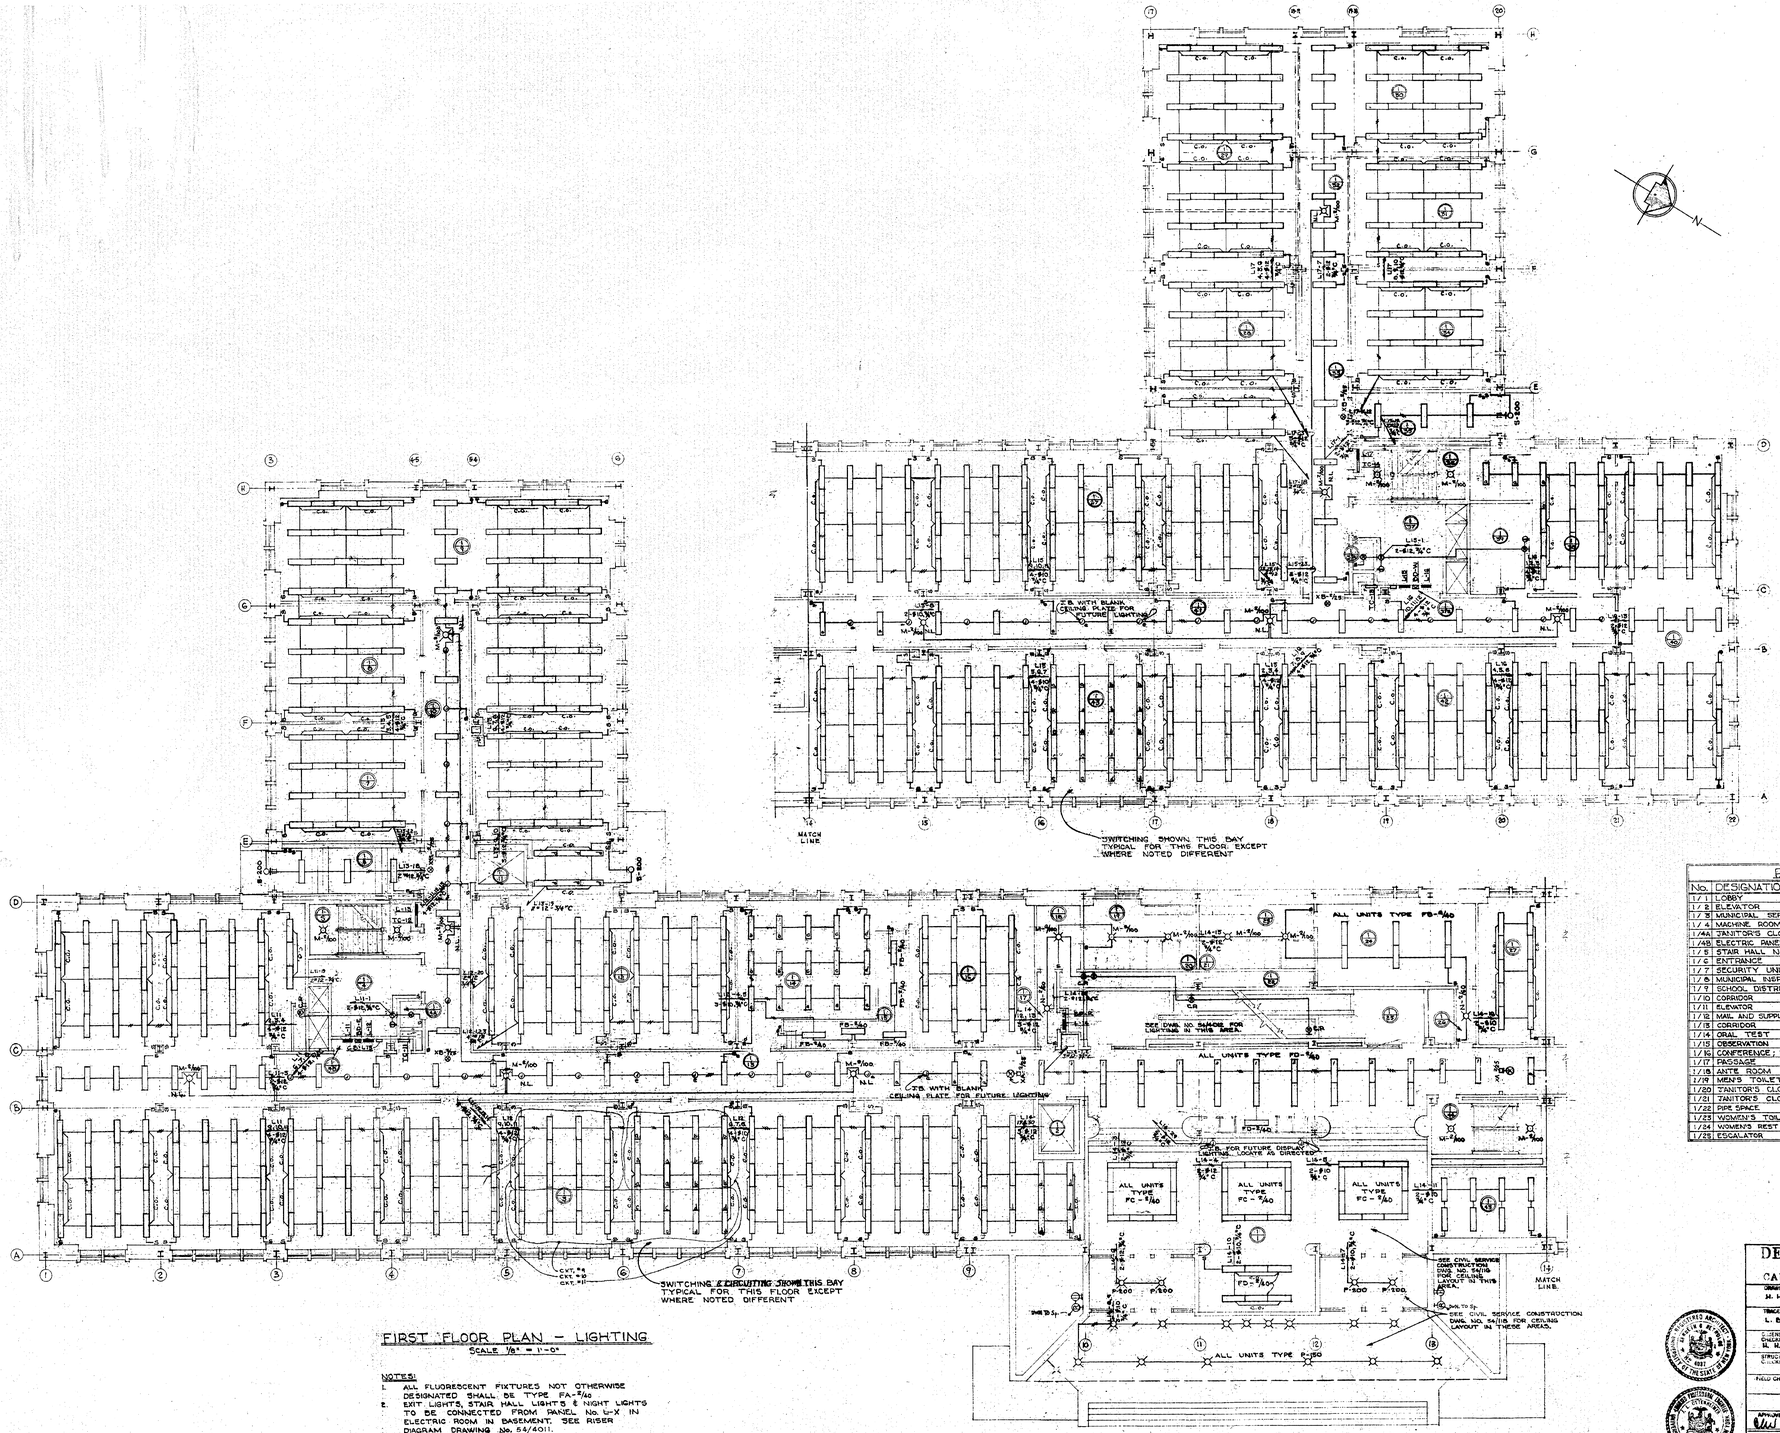

FIRST FLOOR PLAN – LIGHTING

SCALE 1/8" = 1'-0"

NOTES:

1. ALL FLUORESCENT FIXTURES NOT OTHERWISE DESIGNATED SHALL BE TYPE FA-5/40
2. EXIT LIGHTS, STAIR HALL LIGHTS & NIGHT LIGHTS TO BE CONNECTED FROM PANEL No. L-X IN ELECTRIC ROOM IN BASEMENT. SEE RISER DIAGRAM DRAWING No. 54/4011.
3. SEE DRAWING No. 54/4012 FOR TYPICAL BAY LIGHTING LAYOUT.

ROOM SCHEDULE

No.	DESIGNATION	No.	DESIGNATION
1/1	LOBBY	1/29	PASSAGE
1/2	ELEVATOR	1/27	TRAINING DIVISION
1/3	MUNICIPAL SERVICE DIVISION	1/28	CLASS ROOM
1/4	MACHINE ROOM	1/29	CLASS ROOM
1/4A	JANITOR'S CLOSET	1/30	CLASS ROOM
1/4B	ELECTRIC PANEL CLOSET	1/31	CLASS ROOM
1/5	STAIR HALL NO. 1	1/32	CORRIDOR
1/6	ENTRANCE	1/33	CORRIDOR
1/7	SECURITY UNIT	1/34	CLASS ROOM
1/8	MUNICIPAL INSPECTION	1/35	ENTRANCE
1/9	SCHOOL DISTRICT	1/36	STAIR HALL NO. 3
1/10	CORRIDOR	1/37	MACHINE ROOM
1/11	ELEVATOR	1/37A	JANITOR'S CLOSET
1/12	MAIL AND SUPPLY	1/37B	ELECTRIC PANEL CLOSET
1/13	CORRIDOR	1/38	LIBRARY WORK ROOM
1/14	ORAL TEST	1/39	MACHINE ROOM
1/15	OBSERVATION	1/40	LIBRARY
1/16	CONFERENCE; HEARINGS	1/41	CORRIDOR
1/17	PASSAGE	1/42	OFFICE ADM. BUREAU
1/18	ANTE ROOM	1/43	MISCELLANEOUS BOARDS
1/19	MEN'S TOILET	1/44A	STAIR HALL NO. 2
1/20	JANITOR'S CLOSET		
1/21	JANITOR'S CLOSET		
1/22	PIPE SPACE		
1/23	WOMEN'S TOILET		
1/24	WOMEN'S REST ROOM		
1/25	ESCALATOR		

SCANNED 2005

DEPARTMENT OF CIVIL SERVICE
STATE OFFICE BUILDING
CAMPUS SITE ALBANY NEW YORK

DRAWN BY H. H. F.	ELECTRIC	PROJECT NO. 12978
TRACED BY L. D. F.	FIRST FLOOR PLAN LIGHTING	SPECIFICATION NO. 18884
DIMENSIONS CHECKED BY H. H. F.	KENNETH G. REYNOLDS & ASSOCIATES ARCHITECTS ALBANY, NEW YORK	DATE AUG. 9, 1954
STRUCTURAL CHECKED BY	J.L. OTTENHEIMER CONSULTING ENGINEER ALBANY NEW YORK	SCALE AS NOTED
FIELD CHECK BY ARCHT.	JOHN A. MAC CORMACK COMMISSIONER OF STANDARDS & PURCHASE	DRAWING NO. 54/4004
ENG. APPROVED BY RWW	STATE OF NEW YORK DEPARTMENT OF PUBLIC WORKS DIVISION OF CONSTRUCTION BERTRAM D. TALLAMY SUPERINTENDENT CORNELIUS J. WHITE STATE ARCHITECT	

APPROVED
DATE AUG 2 2 1954 BLDG. # 1

NOTE: DRAWING NOT TO SCALE

NYS OFFICE OF GENERAL SERVICES
Serving New York

ANDREW M. CUOMO
Governor
ROANN M. DESTITO
Commissioner

CONSULTANT

WARNING:
THE ALTERATION OF THIS MATERIAL IN ANY WAY, UNLESS DONE UNDER THE DIRECTION OF A COMPARABLE PROFESSIONAL, I.E. ARCHITECT FOR AN ARCHITECT, ENGINEER FOR AN ENGINEER OR LANDSCAPE ARCHITECT FOR A LANDSCAPE ARCHITECT, IS A VIOLATION OF THE NEW YORK STATE EDUCATION LAW AND/OR REGULATIONS AND IS A CLASS 'A' MISDEMEANOR.

CONTRACT:
CONSTRUCTION

TITLE:
DEMOLISH BUILDING
NOS. 1 & 1A

LOCATION:
STATE OFFICE BUILDING CAMPUS
1220 WASHINGTON AVENUE
ALBANY, N.Y. 12226

CLIENT:
NEW YORK STATE
OFFICE OF GENERAL SERVICES

MARK	DATE	DESCRIPTION
	8/26/13	BID DOCUMENTS

PROJECT NUMBER: 44845 – C

DESIGNED BY:
DRAWN BY:
FIELD CHECK:
APPROVED:

SHEET TITLE:
EXIST. ELECTRICAL REF. DWG.
FIRST FLOOR PLAN
LIGHTING

DRAWING NUMBER:
54–4004

SHEET OF

Sep 12,2013 – 10:21am
V:\Designed\Consch\p44845\CadStru\ELEC\54-4004.dwg
36x24 PLOT SHEET

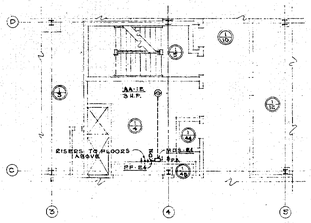

PART FIRST FLOOR PLAN - EAST

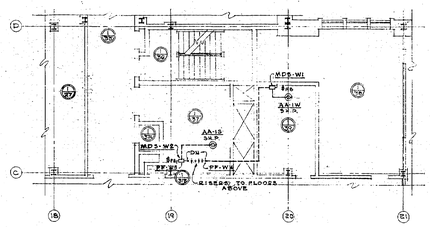

PART FIRST FLOOR PLAN - WEST

PLANS OF AIR CONDITIONING ROOMS

SCALE 1/8"=1'-0"

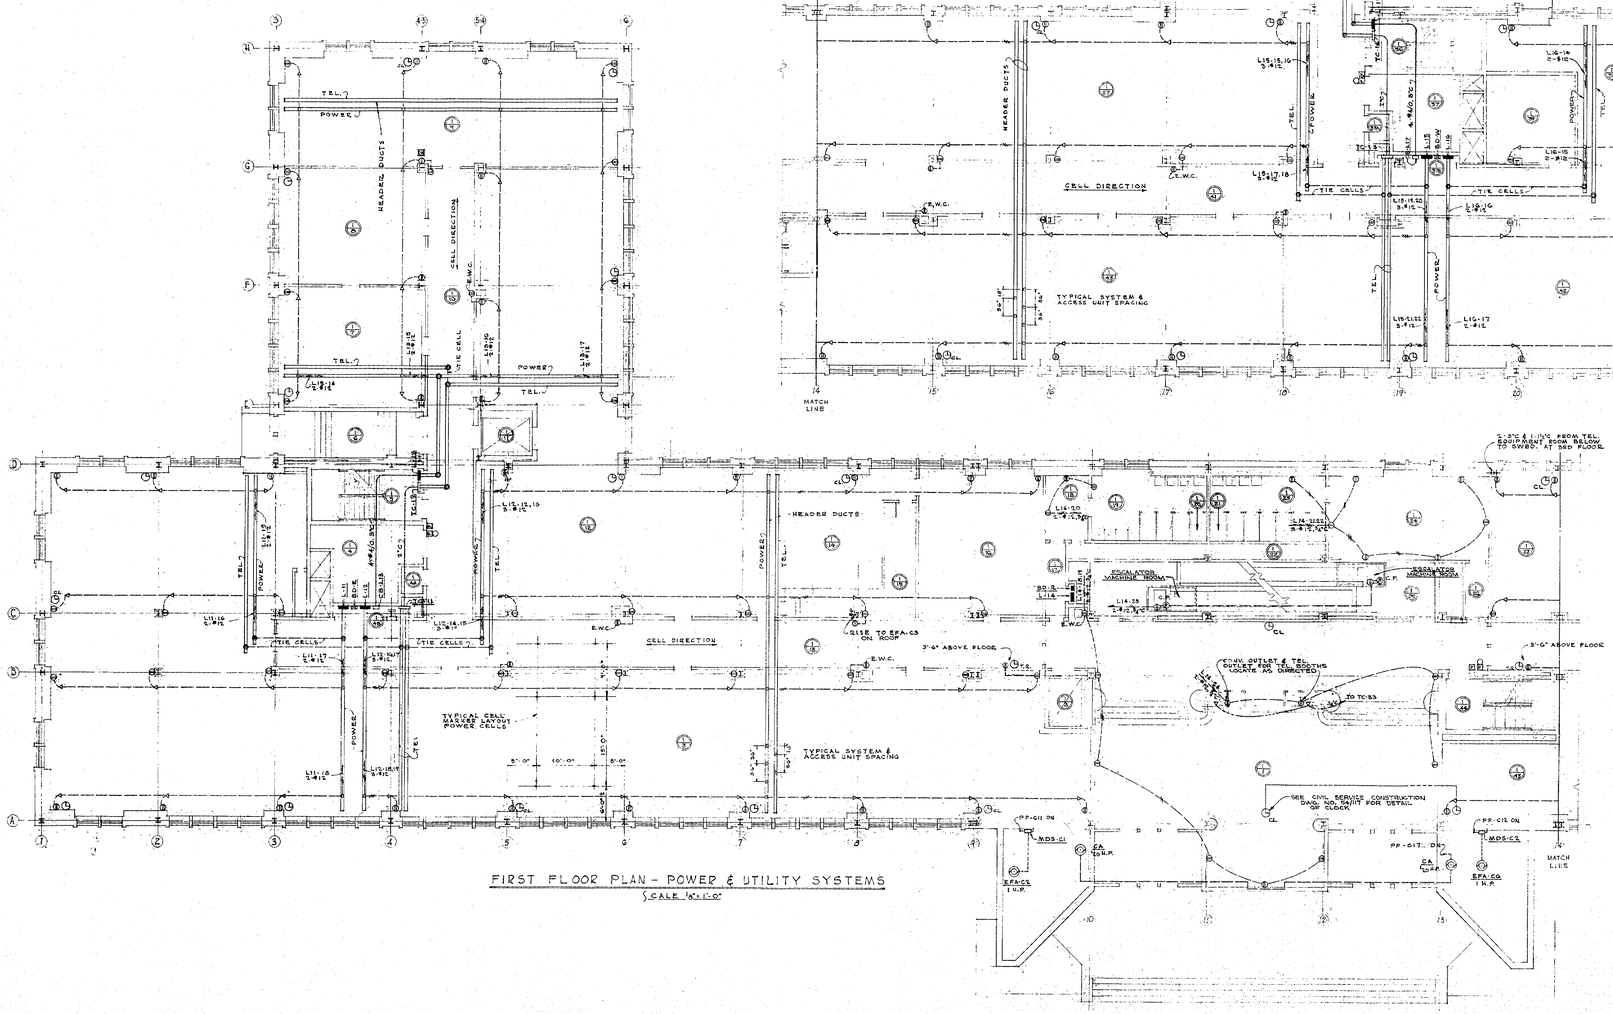

FIRST FLOOR PLAN - POWER & UTILITY SYSTEMS

SCALE 1/8"=1'-0"

ROOM SCHEDULE			
No.	DESIGNATION	No.	DESIGNATION
1/1	LOBBY	1/26	PASSAGE
1/2	ELEVATOR	1/27	TRAINING DIVISION
1/3	MUNICIPAL SERVICE DIVISION	1/28	CLASS ROOM
1/4	MACHINE ROOM	1/29	CLASS ROOM
1/4A	JANITOR'S CLOSET	1/30	CLASS ROOM
1/4B	ELECTRIC PANEL CLOSET	1/31	CLASS ROOM
1/5	STAIR HALL NO. 1	1/32	CORRIDOR
1/6	ENTRANCE	1/33	CORRIDOR
1/7	SECURITY UNIT	1/34	CLASS ROOM
1/8	MINERAL INSPECTION	1/35	ENTRANCE
1/9	SCHOOL DISTRICT	1/36	STAIR HALL NO. 3
1/10	CORRIDOR	1/37	MACHINE ROOM
1/11	ELEVATOR	1/38A	JANITOR'S CLOSET
1/12	MAIL AND SUPPLY	1/37B	ELECTRIC PANEL CLOSET
1/13	CORRIDOR	1/38	LIBRARY WORK ROOM
1/14	ORAL TEST	1/39	MACHINE ROOM
1/15	OBSERVATION	1/40	LIBRARY
1/16	CONFERENCE	HEARINGS	1/41	CORRIDOR
1/17	PASSAGE	1/42	OFFICE ADM. BUREAU
1/18	ANTE ROOM	1/43	MISCELLANEOUS BOARDS
1/19	MEN'S TOILET	1/44	STAIR HALL NO. 2
1/20	JANITOR'S CLOSET		
1/21	JANITOR'S CLOSET		
1/22	PIPE SPACE		
1/23	WOMEN'S TOILET		
1/24	WOMEN'S REST ROOM		
1/25	ESCALATOR		

SCANNED 2005

DEPARTMENT OF CIVIL SERVICE
STATE OFFICE BUILDING
CAMPUS SITE ALBANY NEW YORK

DRAWN BY H. H. F.	ELECTRIC	PROJECT NO. 12978
TRACED BY L. B. F.	FIRST FLOOR PLAN POWER & UTILITIES SYSTEMS	SPECIFICATION NO. 18884
CHECKED BY H. H. F.	KENNETH G. REYNOLDS & ASSOCIATES ARCHITECTS ALBANY, NEW YORK	DATE AUG. 9, 1954
DIRECTION	J. L. OTTENHEIMER, CONSULTING ENGINEER ALBANY, NEW YORK	SCALE AS NOTED
FIELD REVIEW BY ARCHITECT	JOHN A. MAC CORMACK COMMISSIONER OF STANDARDS & PURCHASE STATE OF NEW YORK	DRAWING NO. 54/4005
APPROVED BY	DEPARTMENT OF PUBLIC WORKS DIVISION OF CONSTRUCTION BERTRAM D. TALLAMY, SUPERINTENDENT; CORNELIUS J. WHITE, STATE ARCHITECT	

APPROVED
DATE AUG 2 2 1954 BLDG# 1

NOTE: DRAWING NOT TO SCALE

NYS OFFICE OF GENERAL SERVICES
Serving New York
ANDREW M. CUOMO
Governor
ROANN M. DESTITO
Commissioner

CONSULTANT

WARNING:
THE ALTERATION OF THIS MATERIAL IN ANY WAY, UNLESS DONE UNDER THE DIRECTION OF A COMPARABLE PROFESSIONAL, I.E. ARCHITECT FOR AN ARCHITECT, ENGINEER FOR AN ENGINEER OR LANDSCAPE ARCHITECT FOR A LANDSCAPE ARCHITECT, IS A VIOLATION OF THE NEW YORK STATE EDUCATION LAW AND/OR REGULATIONS AND IS A CLASS 'A' MISDEMEANOR.

CONTRACT:
CONSTRUCTION

TITLE:
DEMOLISH BUILDING
NOS. 1 & 1A

LOCATION:
STATE OFFICE BUILDING CAMPUS
1220 WASHINGTON AVENUE
ALBANY, N.Y. 12226

CLIENT:
NEW YORK STATE
OFFICE OF GENERAL SERVICES

MARK	DATE	DESCRIPTION
	8/26/13	BID DOCUMENTS

PROJECT NUMBER: 44845 – C

DESIGNED BY:
DRAWN BY:
FIELD CHECK:
APPROVED:

SHEET TITLE:
EXIST. ELECTRICAL REF. DWG.
1ST FLOOR PLAN –
POWER & UTILITIES SYSTEMS

DRAWING NUMBER:
54–4005

SHEET OF

Sep 12,2013 – 10:21am
V:\Designs\Const\p44845\CadStd\LELEC\54-4005.dwg
36x24 PLOT SHEET

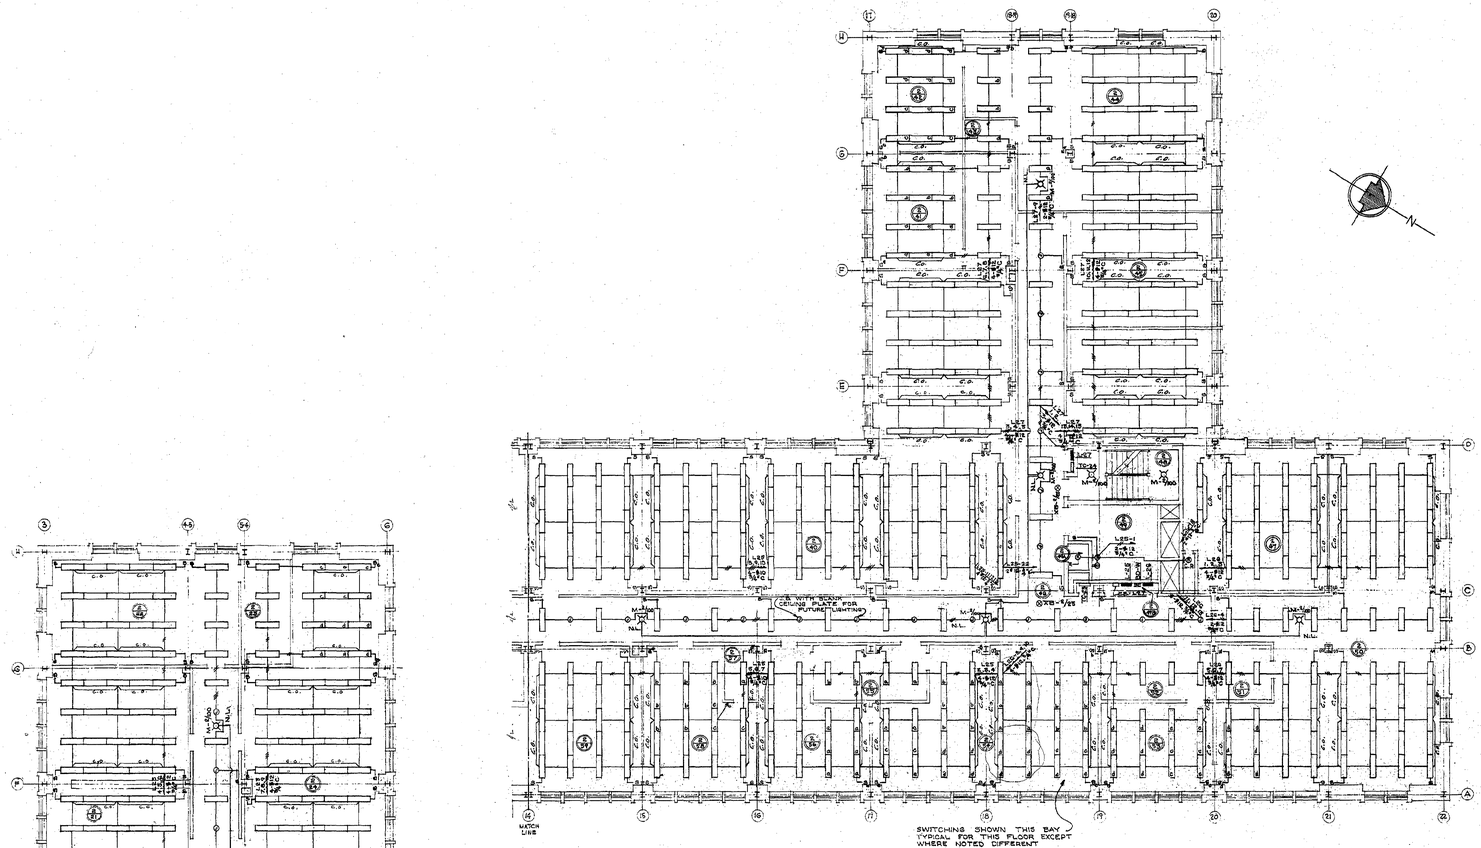

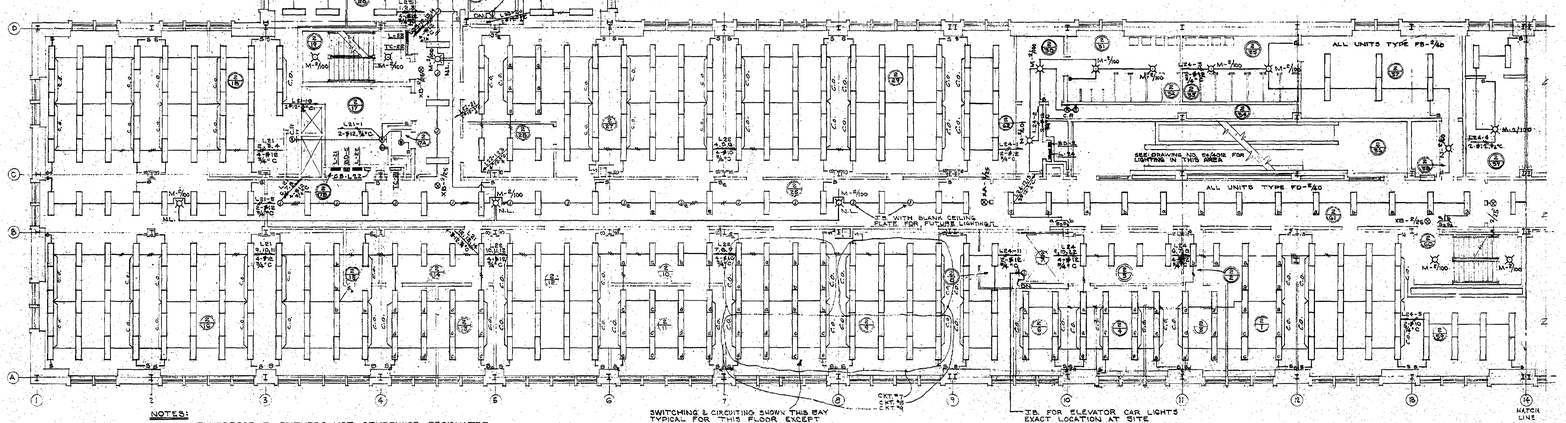

NOTES:

1. ALL FLUORESCENT FIXTURES NOT OTHERWISE DESIGNATED SHALL BE TYPE FA-2/40
2. EXIT LIGHTS, STAIR HALL LIGHTS & NIGHT LIGHTS TO BE CONNECTED FROM PANEL No. L-X IN ELECTRIC ROOM IN BASEMENT. SEE RISER DIAGRAM DRAWING NO. 54/4011
3. SEE DRAWING NO. 54/4012 FOR TYPICAL BAY LIGHTING LAYOUT.

SECOND FLOOR PLAN – LIGHTING

SCALE: 1/8" = 1'-0"

ROOM SCHEDULE

No.	DESIGNATION	No.	DESIGNATION
2/1	ARTIST	2/35	WOMEN'S TOILET
2/2	ASS'T. DIRECTOR	2/36	ESCALATOR
2/3	ASS'T. DIRECTOR	2/37	WOMEN'S REST ROOM
2/4	SECRETARY	2/38	PASSAGE
2/5	CONFERENCE ROOM	2/39	DARK ROOM
2/6	DIRECTOR'S OFFICE	2/40	GENERAL FILES
2/7	ELEVATOR	2/41	CONFERENCE ROOM
2/8	SECURITY ROOM	2/42	SECTION NO.4 OFFICE
2/9	ENG.-AG. UNIT (XD-8)	2/43	SECURITY ROOM
2/10	CONFERENCE ROOM	2/44	LAW ENF. UNIT (XD-6)
2/11	SECTION NO. 2 OFFICE	2/45	PHYS.-MED. UNIT
2/12	SECTION NO. 6 OFFICE	2/46	CORRIDOR
2/13	SECTION NO. 1 OFFICE	2/47	INVESTIGATING UNIT
2/14	CONFERENCE ROOM	2/48	STAIR HALL NO. 3
2/15	SECURITY ROOM	2/49	MACHINE ROOM
2/16	AD.-CL.-FIS. UNIT (XD-1)	2/49A	JANITOR'S CLOSET
2/17	MACHINE ROOM	2/49B	ELECTRIC PANEL CLOSET
2/17A	JANITOR'S CLOSET	2/50	HEALTH-WEL. UNIT (XD-9)
2/17B	ELECTRIC PANEL CLOSET	2/51	SECURITY ROOM
2/18	PLATE MAKING UNIT	2/52	CONFERENCE ROOM
2/19	STAIR HALL NO. 1	2/53	SECTION NO. 5 OFFICE
2/20	SECURITY ROOM	2/54	TEST. DEVELOPMENT UNIT
2/21	DUPLICATING & COLLATING UNIT	2/55	CONFERENCE ROOM
2/22	SHIPPING UNIT	2/56	SECTION NO. 7 OFFICE
2/23	SECURITY ROOM	2/57	SECURITY ROOM
2/24	CLERICAL UNIT	2/58	TEST EDITING UNIT
2/25	CORRIDOR	2/59	TEST REFERENCE FILE
2/26	ELEVATOR	2/60	STAIR HALL NO. 2
2/27	APPLICATIONS & ARRANGEMENTS	2/61	CORRIDOR
2/28	BUSINESS MACHINE ROOM	2/62	PASSAGE
2/29	STENOGRAPHIC POOL		
2/30	ANTE ROOM		
2/31	MEN'S TOILET		
2/32	JANITOR'S CLOSET		
2/33	JANITOR'S CLOSET		
2/34	PIPE SPACE		

SCANNED 2005

DEPARTMENT OF CIVIL SERVICE
STATE OFFICE BUILDING
CAMPUS SITE ALBANY NEW YORK

DRAWN BY H.H.M.	ELECTRIC	PROJECT NO. 12976
TRACED BY L.B.F.	SECOND FLOOR PLAN LIGHTING	SPECIFICATION NO. 18864
DESIGNED BY H.H.F.	KENNETH G. REYNOLDS & ASSOCIATES ARCHITECTS ALBANY, NEW YORK	DATE AUG. 9, 1954
STRUCTURAL DESIGNED BY	J. LOTTENHEIMER CONSULTING ENGINEER ALBANY, NEW YORK	SCALE AS NOTED
FIELD CHECK BY ARCHT.	JOHN A. MAC CORMACK COMMISSIONER OF STANDARDS & PURCHASE	DRAWING NO. 54/4006
ENG.	STATE OF NEW YORK DEPARTMENT OF PUBLIC WORKS DIVISION OF CONSTRUCTION	
APPROVED BY	BERTRAM D. TALLAMY SUPERINTENDENT CORNELIUS J. WHITE STATE ARCHITECT	

APPROVED
DATE AUG 2 1954 BLDG. # 1

NOTE: DRAWING NOT TO SCALE

NYS OFFICE OF GENERAL SERVICES
Serving New York

ANDREW M. CUOMO
Governor
ROANN M. DESTITO
Commissioner

CONSULTANT

WARNING:
THE ALTERATION OF THIS MATERIAL IN ANY WAY, UNLESS DONE UNDER THE DIRECTION OF A COMPARABLE PROFESSIONAL, I.E. ARCHITECT FOR AN ARCHITECT, ENGINEER FOR AN ENGINEER OR LANDSCAPE ARCHITECT FOR A LANDSCAPE ARCHITECT, IS A VIOLATION OF THE NEW YORK STATE EDUCATION LAW AND/OR REGULATIONS AND IS A CLASS 'A' MISDEMEANOR.

CONTRACT:
CONSTRUCTION

TITLE:
DEMOLISH BUILDING
NOS. 1 & 1A

LOCATION:
STATE OFFICE BUILDING CAMPUS
1220 WASHINGTON AVENUE
ALBANY, N.Y. 12226

CLIENT:
NEW YORK STATE
OFFICE OF GENERAL SERVICES

MARK	DATE	DESCRIPTION
	8/26/13	BID DOCUMENTS

PROJECT NUMBER: 44845 – C

DESIGNED BY:
DRAWN BY:
FIELD CHECK:
APPROVED:

SHEET TITLE:
EXIST. ELECTRICAL REF. DWG.
2ND FLOOR PLAN –
LIGHTING

DRAWING NUMBER:
54–4006

SHEET OF

Sep 12,2013 – 10:20am
V:\Designs\Constr\p48xx\44845\CadStd\LELEC\54-4006.dwg
36x24 PLOT SHEET

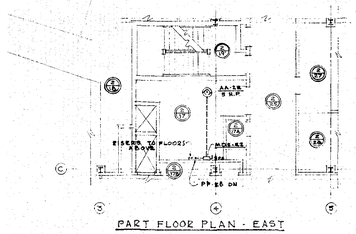

PART FLOOR PLAN - EAST

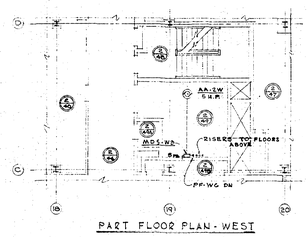

PART FLOOR PLAN - WEST

PLANS OF AIR CONDITIONING ROOMS

SCALE 1/8"=1'-0"

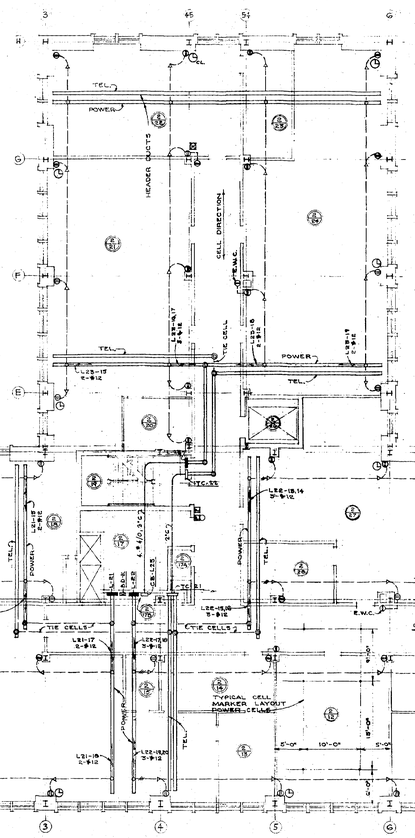

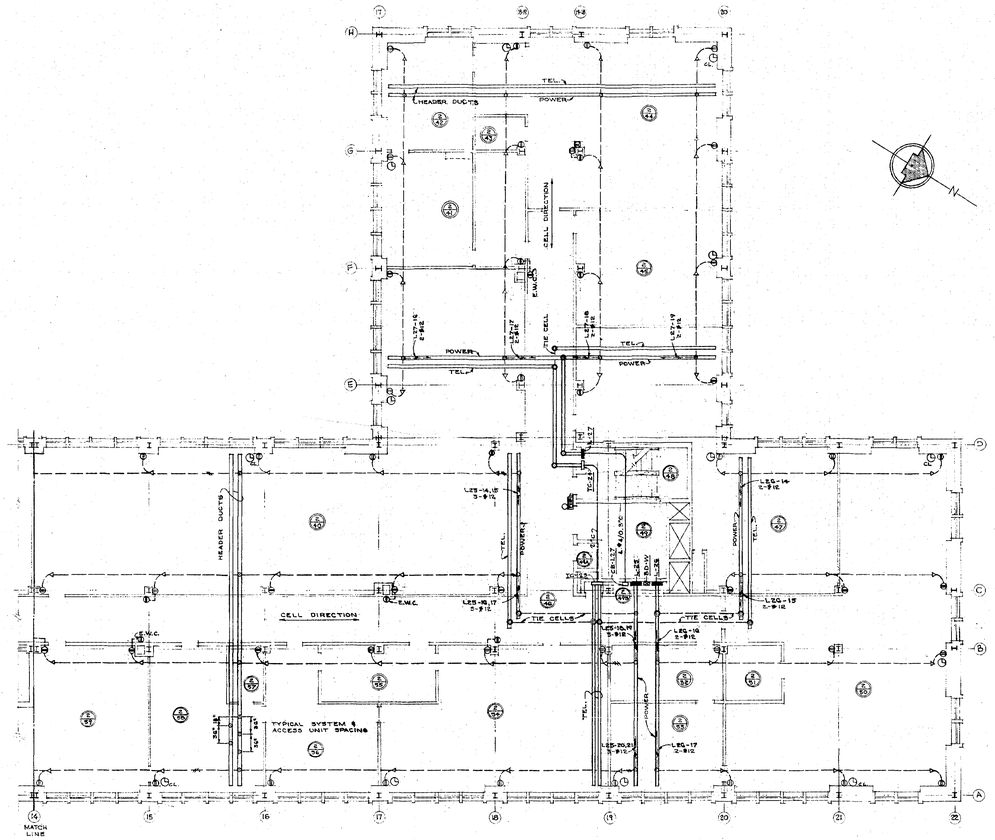

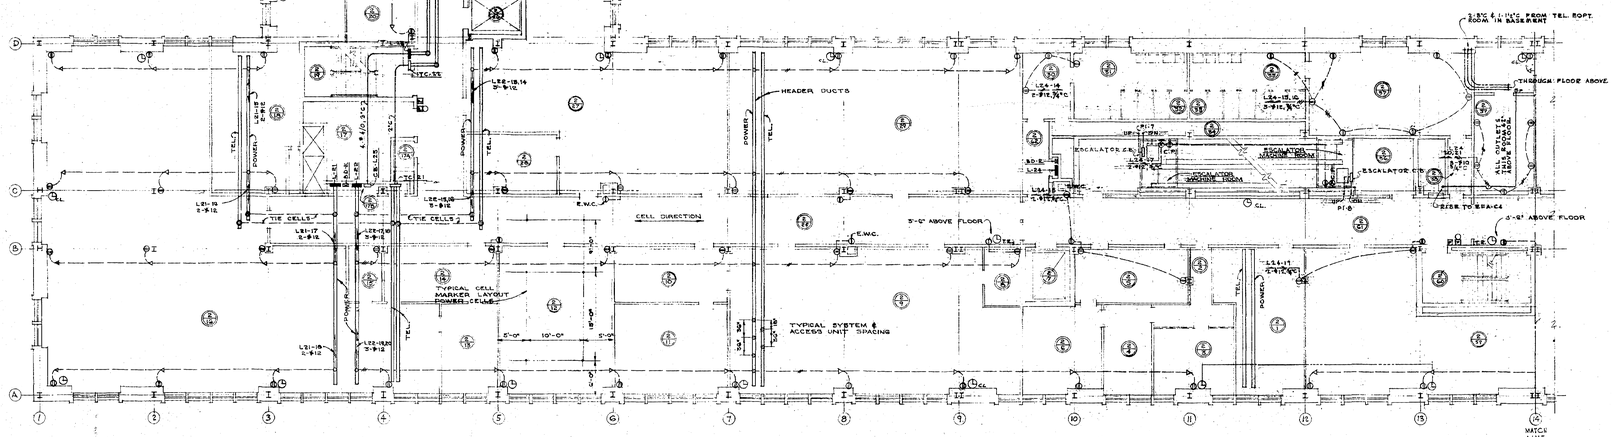

SECOND FLOOR PLAN – POWER & UTILITY SYSTEMS

SCALE 1/8"=1'-0"

ROOM SCHEDULE			
No.	DESIGNATION	No.	DESIGNATION
2/1	ARTIST	2/35	WOMEN'S TOILET
2/2	PASSAGE	2/36	ESCALATOR
2/3	ASS'T. DIRECTOR	2/37	WOMEN'S REST ROOM
2/4	SECRETARY	2/38	PASSAGE
2/5	CONFERENCE ROOM	2/39	DARK ROOM
2/6	DIRECTOR'S OFFICE	2/40	GENERAL FILES
2/7	ELEVATOR	2/41	CONFERENCE ROOM
2/8	SECURITY ROOM	2/42	SECTION NO. 4 OFFICE
2/9	ENG.-AG. UNIT (XD-2)	2/43	SECURITY ROOM
2/10	CONFERENCE ROOM	2/44	LAW ENF. UNIT (XD-4)
2/11	SECTION NO. 6 OFFICE	2/45	PHYS.-MED. UNIT
2/12	SECTION NO. 8 OFFICE	2/46	CORRIDOR
2/13	SECTION NO. 1 OFFICE	2/47	INVESTIGATIONS UNIT
2/14	CONFERENCE ROOM	2/48	STAIR HALL NO. 3
2/15	SECURITY ROOM	2/49	MACHINE ROOM
2/16	AG.-CL.-FIS. UNIT (XD-1)	2/49A	JANITOR'S CLOSET
2/17	MACHINE ROOM	2/49B	ELECTRC PANEL CLOSET
2/17A	JANITOR'S CLOSET	2/50	HEALTH-WEL. UNIT (XD-3)
2/17B	ELECTRIC PANEL CLOSET	2/51	SECURITY ROOM
2/18	PLATE MAKING UNIT	2/52	CONFERENCE ROOM
2/19	STAIR HALL NO. 1	2/53	SECTION NO. 3 OFFICE
2/20	SECURITY ROOM	2/54	TEST DEVELOPMENT UNIT
2/21	DUPLICATING & COLLATING UNITS	2/55	CONFERENCE ROOM
2/22	SHIPPING UNIT	2/56	SECTION NO. 7 OFFICE
2/23	SECURITY ROOM	2/57	SECURITY ROOM
2/24	CLERICAL UNIT	2/58	TEST EDITING UNIT
2/25	CORRIDOR	2/59	TEST REFERENCE FILE
2/26	ELEVATOR	2/60	STAIR HALL NO. 2
2/27	APPLICATIONS & ARRANGEMENTS	2/61	CORRIDOR
2/28	BUSINESS MACHINE ROOM	2/62	PASSAGE
2/29	STENOGRAPHIC POOL		
2/30	ANTE ROOM		
2/31	MEN'S TOILET		
2/32	JANITOR'S CLOSE		
2/33	JANITOR'S CLOSET		
2/34	PIPE SPACE		

SCANNED 2005

DEPARTMENT OF CIVIL SERVICE
STATE OFFICE BUILDING
CAMPUS SITE ALBANY NEW YORK

DRAWN BY H.H.F.	ELECTRIC	PROJECT NO. 12978
TRACED BY L.B.F.	SECOND FLOOR PLAN POWER & UTILITIES SYSTEMS	SUPERVISION NO. 18884
DESIGNED BY CHECKED BY M.H.F.	KENNETH G. REYNOLDS & ASSOCIATES ARCHITECTS	DATE AUG. 9, 1954
STRUCTURAL DESIGN BY	ALBANY, NEW YORK J.L. OTTENHEIMER, CONSULTING ENGINEER ALBANY, NEW YORK	SCALE AS NOTED
FIELD CHECK BY ARCHT.	JOHN A. MACCORMACK COMMISSIONER OF STANDARDS & PURCHASE	DRAWING NO. 54/4007
ENG. APPROVED BY	STATE OF NEW YORK DEPARTMENT OF PUBLIC WORKS DIVISION OF CONSTRUCTION BERTRAM D. TALLAMY COMMISSIONER ESTABROOK G. WHITE SECRETARY-ENGINEER CHIEF ENGINEER	
APPROVED DATE	AUG 2 1954	BLDG. # 1

NOTE: DRAWING NOT TO SCALE

NYS OFFICE OF GENERAL SERVICES

Serving New York

ANDREW M. CUOMO
Governor
ROANN M. DESTITO
Commissioner

CONSULTANT

WARNING:

THE ALTERATION OF THIS MATERIAL IN ANY WAY, UNLESS DONE UNDER THE DIRECTION OF A COMPARABLE PROFESSIONAL, I.E. ARCHITECT FOR AN ARCHITECT, ENGINEER FOR AN ENGINEER OR LANDSCAPE ARCHITECT FOR A LANDSCAPE ARCHITECT, IS A VIOLATION OF THE NEW YORK STATE EDUCATION LAW AND/OR REGULATIONS AND IS A CLASS 'A' MISDEMEANOR.

MARK	DATE	DESCRIPTION
	8/26/13	BID DOCUMENTS

CONTRACT:
CONSTRUCTION

TITLE:
DEMOLISH BUILDING
NOS. 1 & 1A

LOCATION:
STATE OFFICE BUILDING CAMPUS
1220 WASHINGTON AVENUE
ALBANY, N.Y. 12226

CLIENT:
NEW YORK STATE
OFFICE OF GENERAL SERVICES

PROJECT NUMBER: 44845 – C

DESIGNED BY:

DRAWN BY:

FIELD CHECK:

APPROVED:

SHEET TITLE:
EXIST. ELECTRICAL REF. DWG.
2ND FLOOR PLAN –
POWER & UTILITIES SYSTEMS

DRAWING NUMBER:
54–4007

SHEET OF

Sep 12,2013 – 10:20am
V:\Designed\Constr\pHBax\44845\CadSrc\ELEC\54-4007.dwg

36x24 PLOT SHEET

EAST PENTHOUSE PLAN - LIGHTING

SCALE 1/8"=1'-0"

CENTER PENTHOUSE PLAN - LIGHTING

SCALE 1/8"=1'-0"

WEST PENTHOUSE PLAN - LIGHTING

SCALE 1/8"=1'-0"

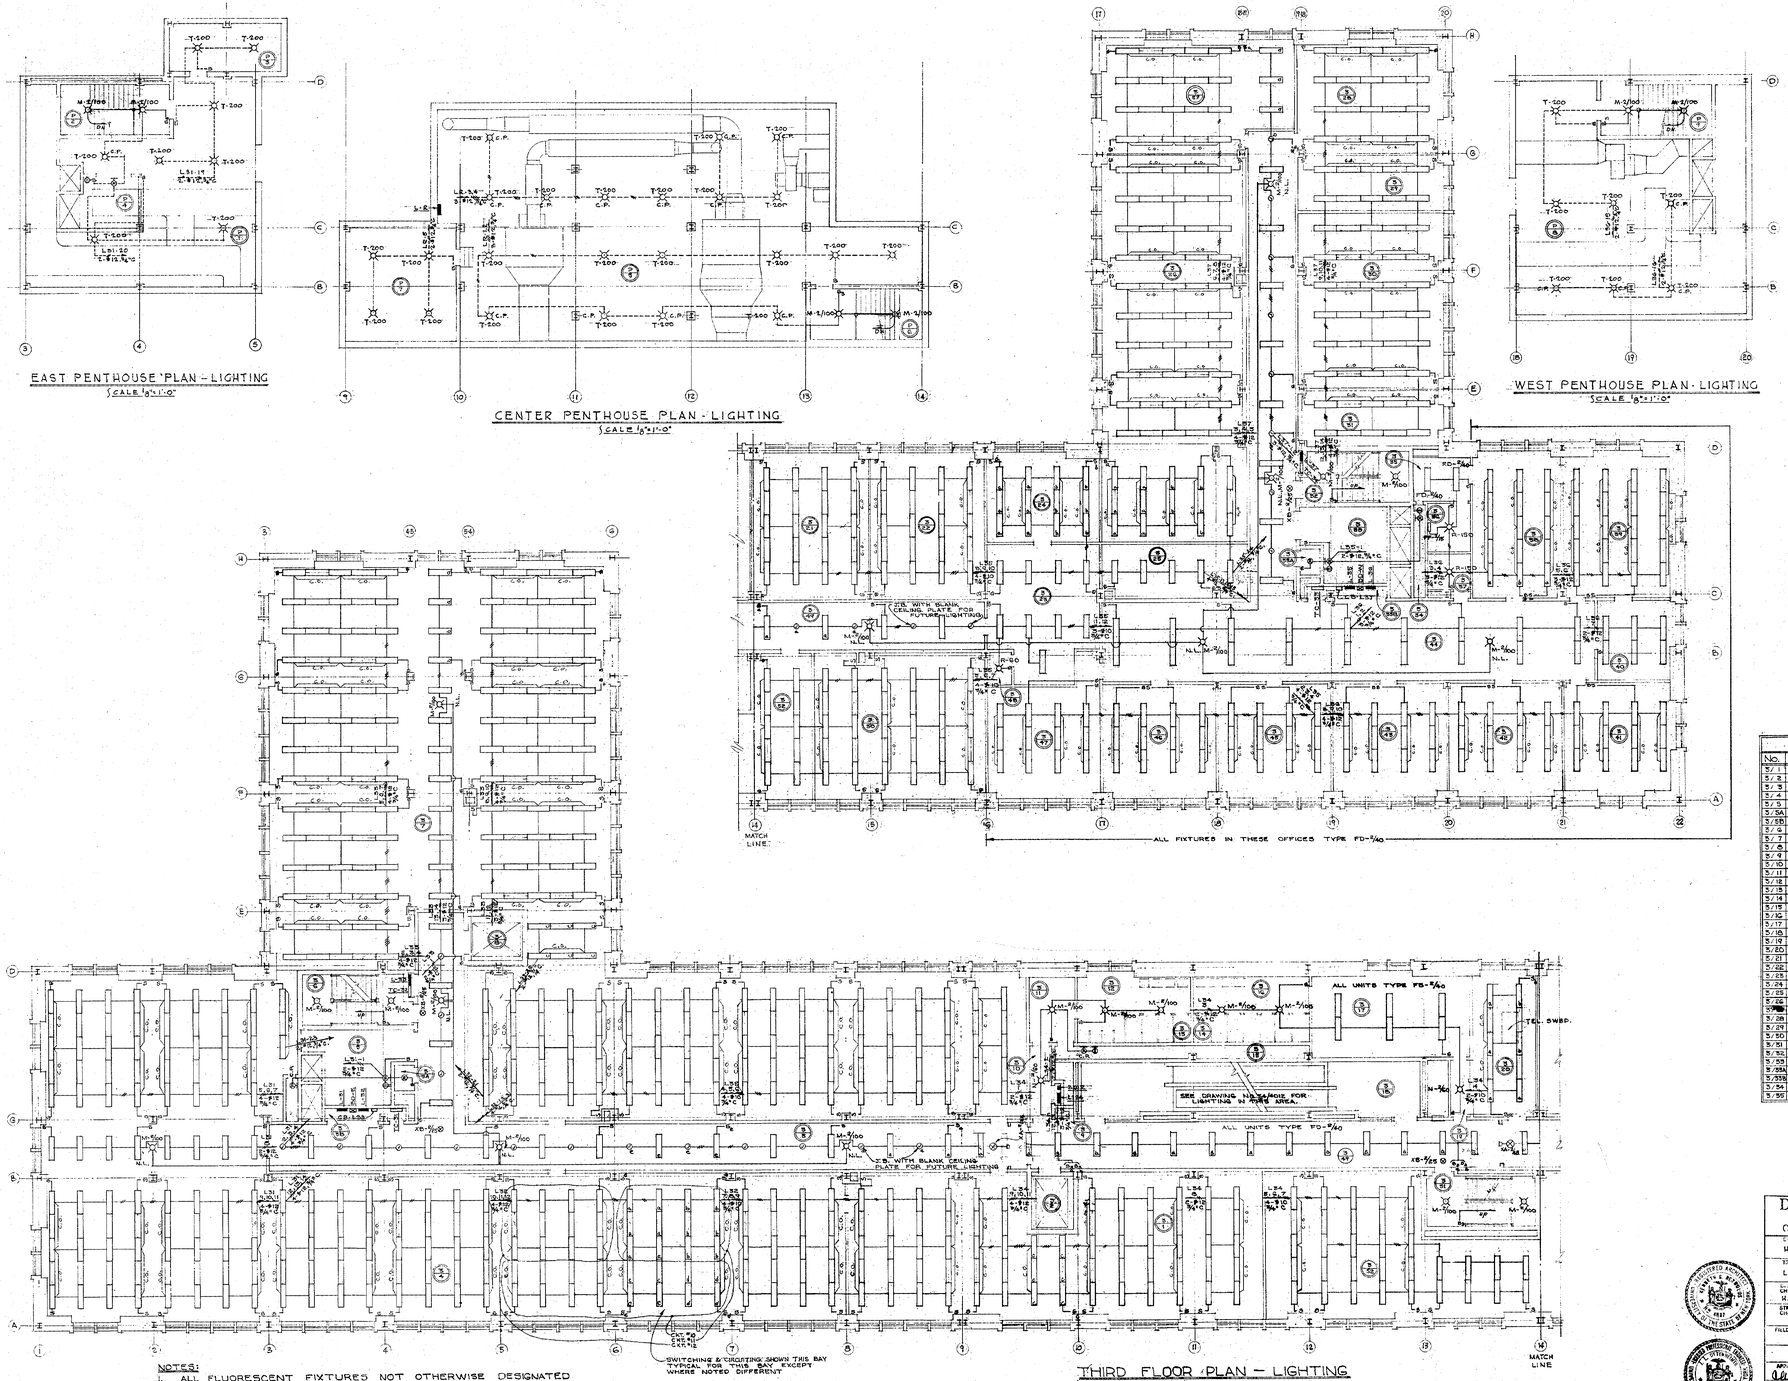

NOTES:

1. ALL FLUORESCENT FIXTURES NOT OTHERWISE DESIGNATED SHALL BE TYPE FA-2/40.
2. EXIT LIGHTS, STAIR HALL LIGHTS & NIGHT LIGHTS TO BE CONNECTED FROM PANEL No. L-X IN ELECTRIC ROOM IN BASEMENT. SEE RISER DIAGRAM DRAWING No. 54/4011.
3. SEE DRAWING No. 54/4012 FOR TYPICAL BAY LIGHTING LAYOUT.

SWITCHING & CIRCUITING SHOWN THIS BAY TYPICAL FOR THIS BAY EXCEPT WHERE NOTED DIFFERENT

THIRD FLOOR PLAN - LIGHTING

SCALE: 1/8" = 1'-0"

ROOM SCHEDULE

No.	DESIGNATION	No.	DESIGNATION
5/1	CERTIFICATION	5/36	PRESIDENT'S TOILET
5/2	ELEVATOR	5/37	PUBLIC TOILET
5/3	CORRIDOR	5/38	CONFERENCE
5/4	PERSONNEL TRANSACTIONS BUREAU	5/39	PRESIDENT
5/5	MACHINE ROOM	5/40	PRESIDENT'S SECY
5/5A	JANITOR'S CLOSET	5/41	COMM. "C"
5/5B	ELECTRIC PANEL CLOSET	5/42	SEC'YS
5/6	STAIR HALL NO. 1	5/43	COMM. "B"
5/7	CLASS & COMP. DIVISION	5/44	WAITING CORRIDOR
5/8	ELEVATOR	5/45	ADMINISTATION DIRECTOR
5/9	ELECTRIC WATER COOLER	5/46	SEC'YS
5/10	PASSAGE	5/47	ASS'T ADMIN. DIRECTOR
5/11	ANTE ROOM	5/48	TELEPHONE
5/12	MEN'S TOILET	5/49	CORRIDOR
5/13	JANITOR'S CLOSET	5/50	STATISTICS
5/14	JANITOR'S CLOSET	5/51	STAIR HALL NO. 2
5/15	PIPE SPACE	5/52	TABULATIONS
5/16	WOMEN'S TOILET		
5/17	WOMEN'S REST ROOM		
5/18	ESCALATOR		
5/19	PASSAGE		
5/20	TELEPHONE ROOM		
5/21	CONFERENCE		
5/22	PUBLIC RELATIONS	P/1	MACHINE ROOM - EAST
5/23	RECEPTION ROOM	P/2	STAIR HALL NO. 1
5/24	SECY TO DEPARTMENT	P/3	ELEVATOR - EAST
5/25	EXEC. FILES	P/4	PLENUM - EAST
5/26	RESEARCH BUREAU	P/5	MACHINE ROOM - CENTER
5/27	METHODS UNIT	P/6	STAIR HALL NO. 2
5/28	EXEC. STENO. POOL	P/7	ELEVATOR - CENTER
5/29	CONSULTANT	P/8	MACHINE ROOM - WEST
5/30	LEGAL BUREAU	P/9	STAIR HALL NO. 3
5/31	COUNSEL		
5/32	STAIR HALL NO. 3		
5/33	MACHINE ROOM		
5/33A	JANITOR'S CLOSET		
5/33B	ELECTRIC PANEL CLOSET		
5/34	PIPE SPACE		
5/35	PRESIDENT'S DRESSING RM.		

SCANNED 2005

DEPARTMENT OF CIVIL SERVICE STATE OFFICE BUILDING CAMPUS SITE ALBANY NEW YORK		
DRAWN BY M. H. F.	ELECTRIC	PROJECT NO. 12978
TRACED BY L. B. F.	THIRD FLOOR & PENT HOUSE PLANS LIGHTING	SPECIFICATION NO. 18884
CHECKED BY M. H. F.	KENNETH G. REYNOLDS & ASSOCIATES ARCHITECTS ALBANY, NEW YORK	DATE AUG. 9, 1954
STRUCTURAL CHECKED BY	J. L. OTTENHEIMER CONSULTING ENGINEER ALBANY NEW YORK	SCALE AS NOTED
FIELD CHECK OF	JOHN A. MAC CORMACK	DRAWING NO.
ARCHT.	COMMISSIONER OF STANDARDS & PURCHASE STATE OF NEW YORK	54/4008
ENG.	DEPARTMENT OF PUBLIC WORKS DIVISION OF CONSTRUCTION	
APPROVED BY	BERTRAM D. TALLAMY PRESIDENT CORNELIUS J. WHITE STATE ARCHITECT	
APPROVED DATE	AUG. 1954	BLDG # 1

NOTE: DRAWING NOT TO SCALE

NYS OFFICE OF GENERAL SERVICES

Serving New York

ANDREW M. CUOMO
Governor
ROANN M. DESTITO
Commissioner

CONSULTANT

WARNING:

THE ALTERATION OF THIS MATERIAL IN ANY WAY, UNLESS DONE UNDER THE DIRECTION OF A COMPARABLE PROFESSIONAL, I.E. ARCHITECT FOR AN ARCHITECT, ENGINEER FOR AN ENGINEER OR LANDSCAPE ARCHITECT FOR A LANDSCAPE ARCHITECT, IS A VIOLATION OF THE NEW YORK STATE EDUCATION LAW AND/OR REGULATIONS AND IS A CLASS 'A' MISDEMEANOR.

CONTRACT:

CONSTRUCTION

TITLE:

DEMOLISH BUILDING NOS. 1 & 1A

LOCATION:

STATE OFFICE BUILDING CAMPUS
1220 WASHINGTON AVENUE
ALBANY, N.Y. 12226

CLIENT:

NEW YORK STATE OFFICE OF GENERAL SERVICES

MARK	DATE	DESCRIPTION
	8/26/13	BID DOCUMENTS

PROJECT NUMBER: 44845 – C

DESIGNED BY:

DRAWN BY:

FIELD CHECK:

APPROVED:

SHEET TITLE:

EXIST. ELECTRICAL REF. DWG. 3RD FLR. & PENTHOUSE PLANS – LIGHTING

DRAWING NUMBER:

54–4008

SHEET OF

Sep. 12,2013 – 10:19am
V:\Designs\Consult\cp44845\CadStrc\ELEC\54-4008.dwg

36x24 PLOT SHEET

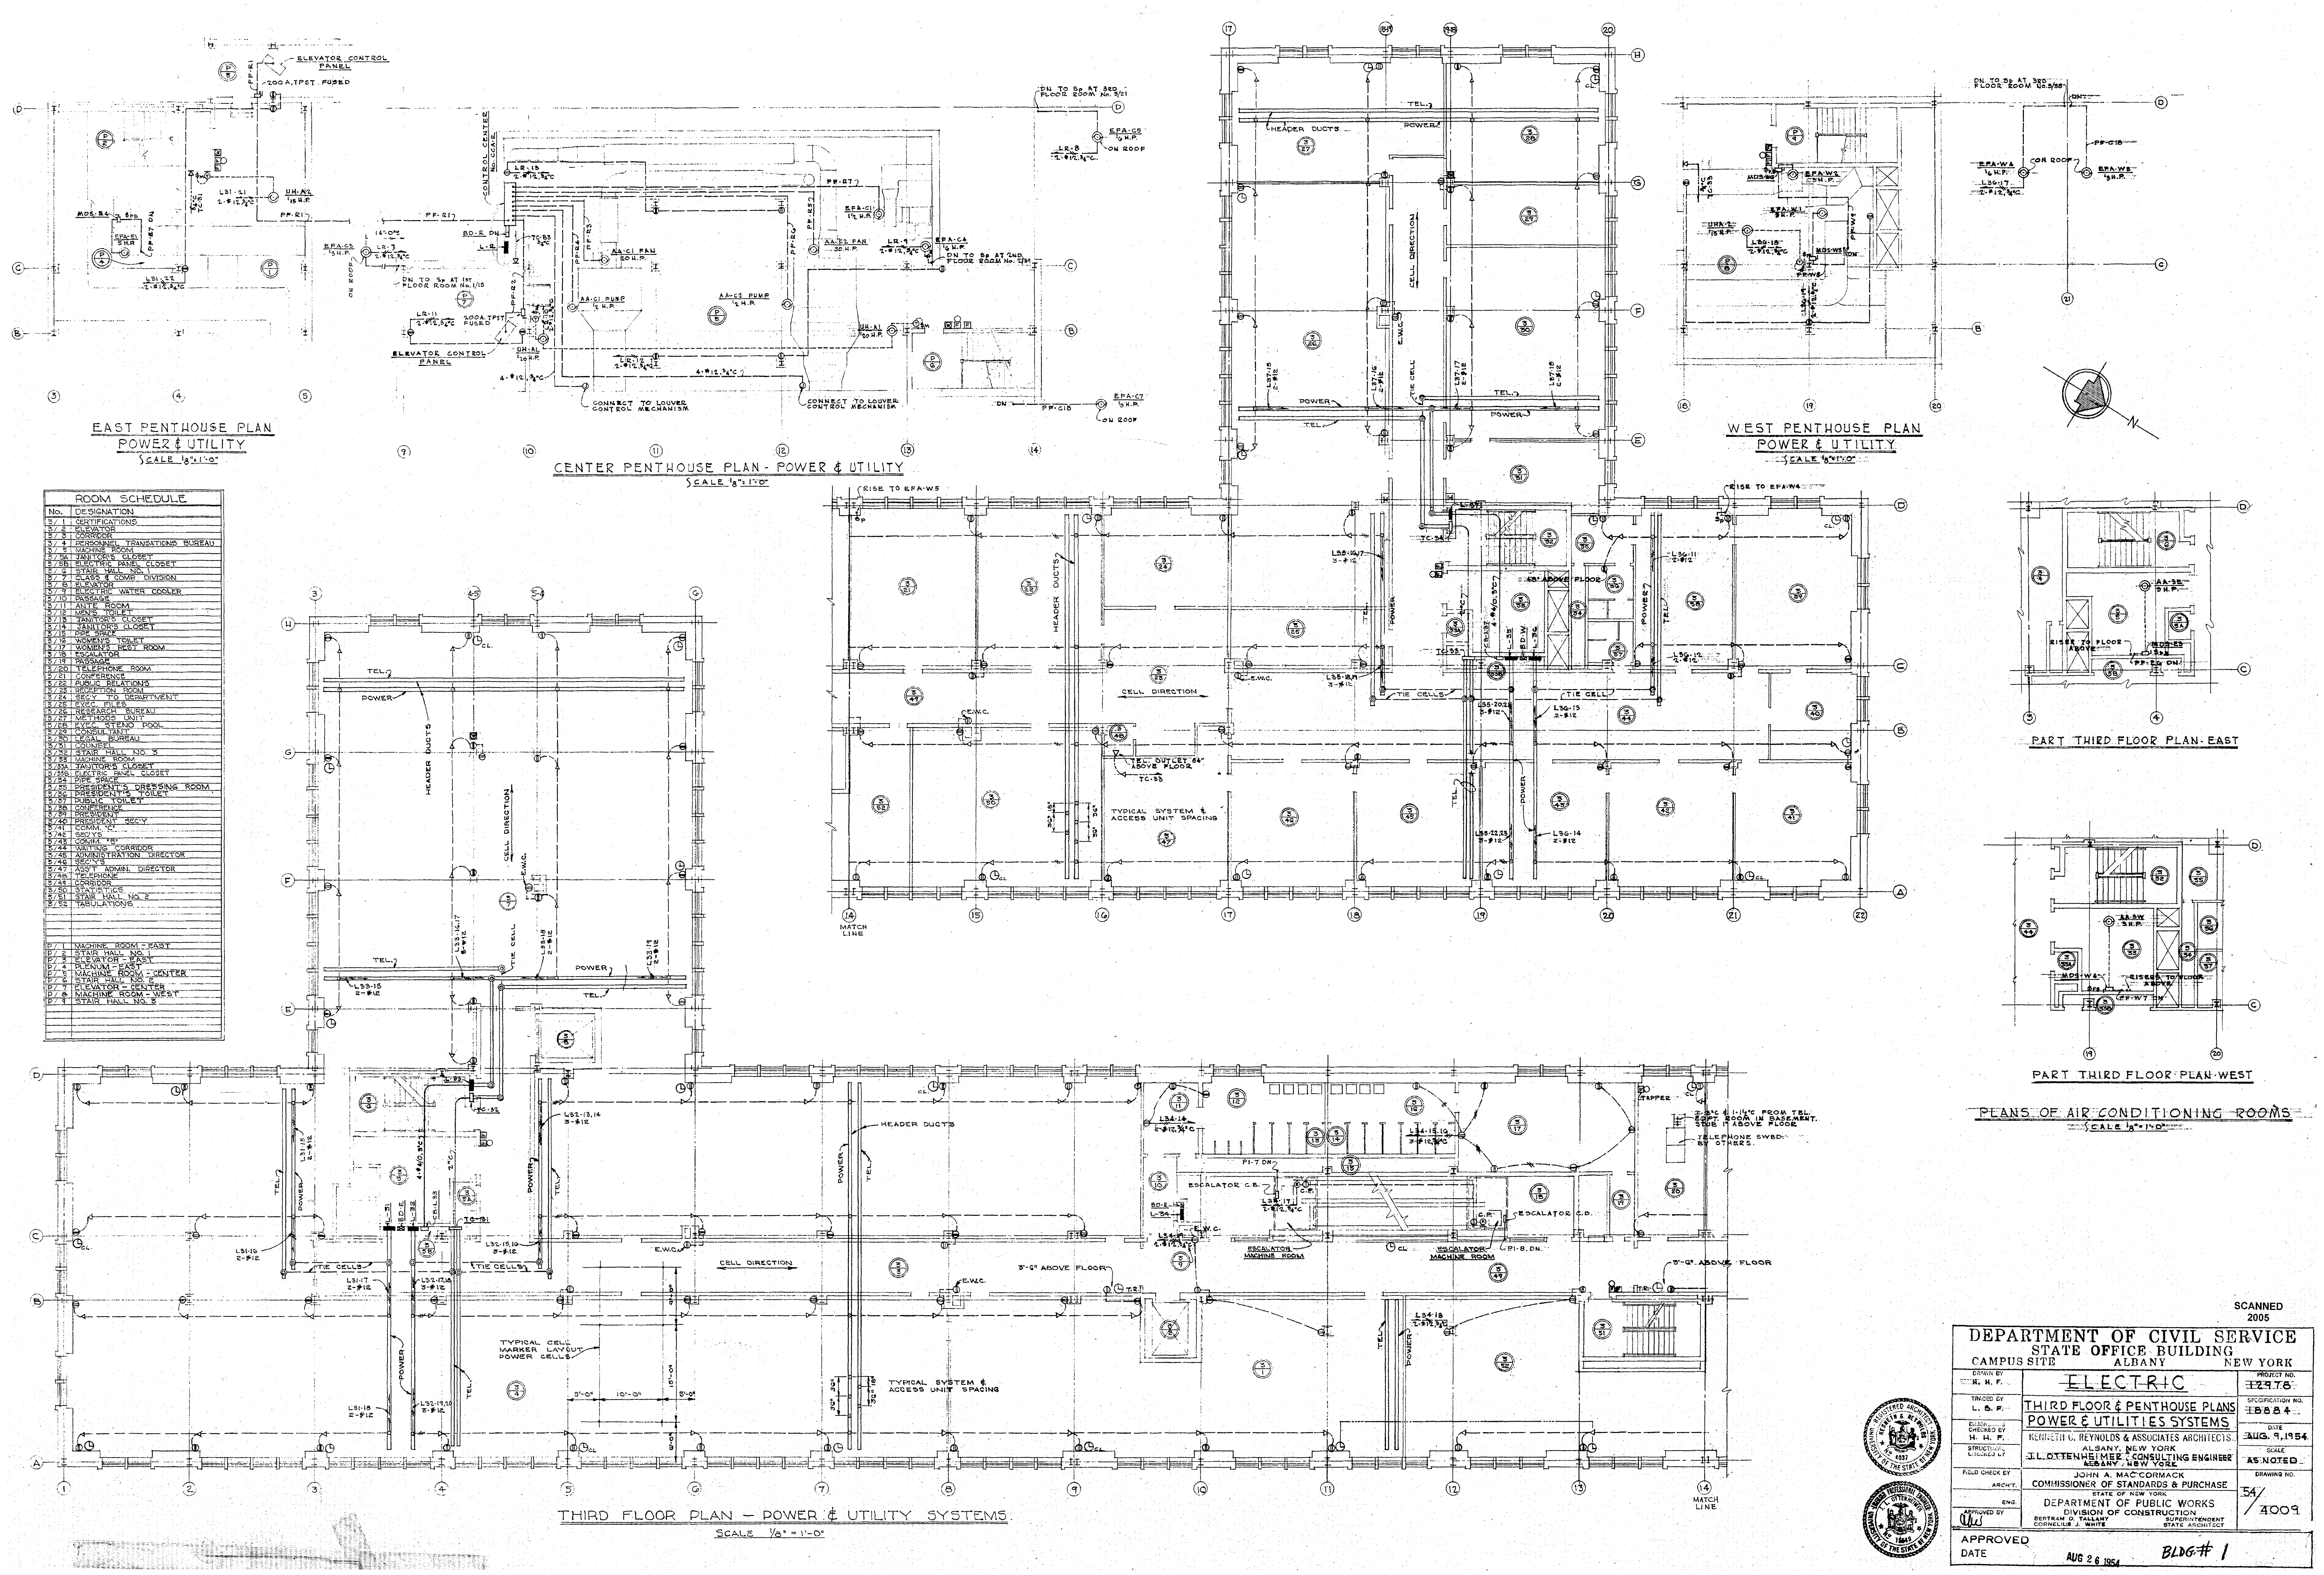

ROOM SCHEDULE

No.	DESIGNATION
3/1	CERTIFICATIONS
3/2	ELEVATOR
3/3	CORRIDOR
3/4	PERSONNEL TRANSATIONS BUREAU
3/5	MACHINE ROOM
3/5A	JANITOR'S CLOSET
3/5B	ELECTRIC PANEL CLOSET
3/6	STAIR HALL NO. 1
3/7	CLASS & COMP. DIVISION
3/8	ELEVATOR
3/9	ELECTRIC WATER COOLER
3/10	PASSAGE
3/11	ANTE ROOM
3/12	MEN'S TOILET
3/13	JANITOR'S CLOSET
3/14	JANITOR'S CLOSET
3/15	PIPE SPACE
3/16	WOMEN'S TOILET
3/17	WOMEN'S REST ROOM
3/18	ESCALATOR
3/19	PASSAGE
3/20	TELEPHONE ROOM
3/21	CONFERENCE
3/22	PUBLIC RELATIONS
3/23	RECEPTION ROOM
3/24	SEC'Y TO DEPARTMENT
3/25	EXEC. FILES
3/26	RESEARCH BUREAU
3/27	METHODS UNIT
3/28	EXEC. STENO POOL
3/29	CONSULTANT
3/30	LEGAL BUREAU
3/31	COUNSEL
3/32	STAIR HALL NO. 3
3/33	MACHINE ROOM
3/33A	JANITOR'S CLOSET
3/33B	ELECTRIC PANEL CLOSET
3/34	PIPE SPACE
3/35	PRESIDENT'S DRESSING ROOM
3/36	PRESIDENT'S TOILET
3/37	PUBLIC TOILET
3/38	CONFERENCE
3/39	PRESIDENT
3/40	PRESIDENT SEC'Y
3/41	COMM. "C"
3/42	SEC'YS
3/43	COMM. "B"
3/44	WAITING CORRIDOR
3/45	ADMINISTRATION DIRECTOR
3/46	SEC'YS
3/47	ASS'T ADMIN. DIRECTOR
3/48	TELEPHONE
3/49	CORRIDOR
3/50	STATISTICS
3/51	STAIR HALL NO. 2
3/52	TABULATIONS
P/1	MACHINE ROOM - EAST
P/2	STAIR HALL NO. 1
P/3	ELEVATOR - EAST
P/4	PLENUM - EAST
P/5	MACHINE ROOM - CENTER
P/6	STAIR HALL NO. 2
P/7	ELEVATOR - CENTER
P/8	MACHINE ROOM - WEST
P/9	STAIR HALL NO. 3

SCANNED 2005

DEPARTMENT OF CIVIL SERVICE
STATE OFFICE BUILDING
CAMPUS SITE ALBANY NEW YORK

ELECTRIC

THIRD FLOOR & PENTHOUSE PLANS
POWER & UTILITIES SYSTEMS

KENNETH C. REYNOLDS & ASSOCIATES ARCHITECTS, ALBANY, NEW YORK
J.L. OTTENHEIMER CONSULTING ENGINEER, ALBANY, NEW YORK
JOHN A. MAC CORMACK, COMMISSIONER OF STANDARDS & PURCHASE
STATE OF NEW YORK DEPARTMENT OF PUBLIC WORKS DIVISION OF CONSTRUCTION
BERTRAM D. TALLAMY, SUPERINTENDENT; CORNELIUS J. WHITE, STATE ARCHITECT

DRAWN BY	H. H. F.
TRACED BY	L. B. F.
DIMENSIONS CHECKED BY	H. H. F.
STRUCTURAL CHECKED BY	
FIELD CHECK BY ARCH'T. / ENG.	
APPROVED BY	[signature]
PROJECT NO.	12978
SPECIFICATION NO.	18884
DATE	AUG. 9, 1954
SCALE	AS NOTED
DRAWING NO.	54/4009

APPROVED DATE AUG 26 1954 BLDG # 1

NOTE: DRAWING NOT TO SCALE

NYS OFFICE OF GENERAL SERVICES
Serving New York
ANDREW M. CUOMO, Governor
ROANN M. DESTITO, Commissioner

CONSULTANT

WARNING:
THE ALTERATION OF THIS MATERIAL IN ANY WAY, UNLESS DONE UNDER THE DIRECTION OF A COMPARABLE PROFESSIONAL, I.E. ARCHITECT FOR AN ARCHITECT, ENGINEER FOR AN ENGINEER OR LANDSCAPE ARCHITECT FOR A LANDSCAPE ARCHITECT, IS A VIOLATION OF THE NEW YORK STATE EDUCATION LAW AND/OR REGULATIONS AND IS A CLASS 'A' MISDEMEANOR.

CONTRACT: CONSTRUCTION
TITLE: DEMOLISH BUILDING NOS. 1 & 1A
LOCATION: STATE OFFICE BUILDING CAMPUS, 1220 WASHINGTON AVENUE, ALBANY, N.Y. 12226
CLIENT: NEW YORK STATE OFFICE OF GENERAL SERVICES

MARK	DATE	DESCRIPTION
	8/26/13	BID DOCUMENTS

PROJECT NUMBER: 44845 - C
DESIGNED BY:
DRAWN BY:
FIELD CHECK:
APPROVED:
SHEET TITLE: EXIST. ELECTRICAL REF. DWG. 3RD FLR. & P.H. PLANS POWER & UTILITIES SYSTEMS
DRAWING NUMBER: 54-4009
SHEET OF

Sep 12,2013 – 10:19am
V:\DesignAndConstr\p448xx\44845\CadStru\ELEC\54-4009.dwg
36x24 PLOT SHEET

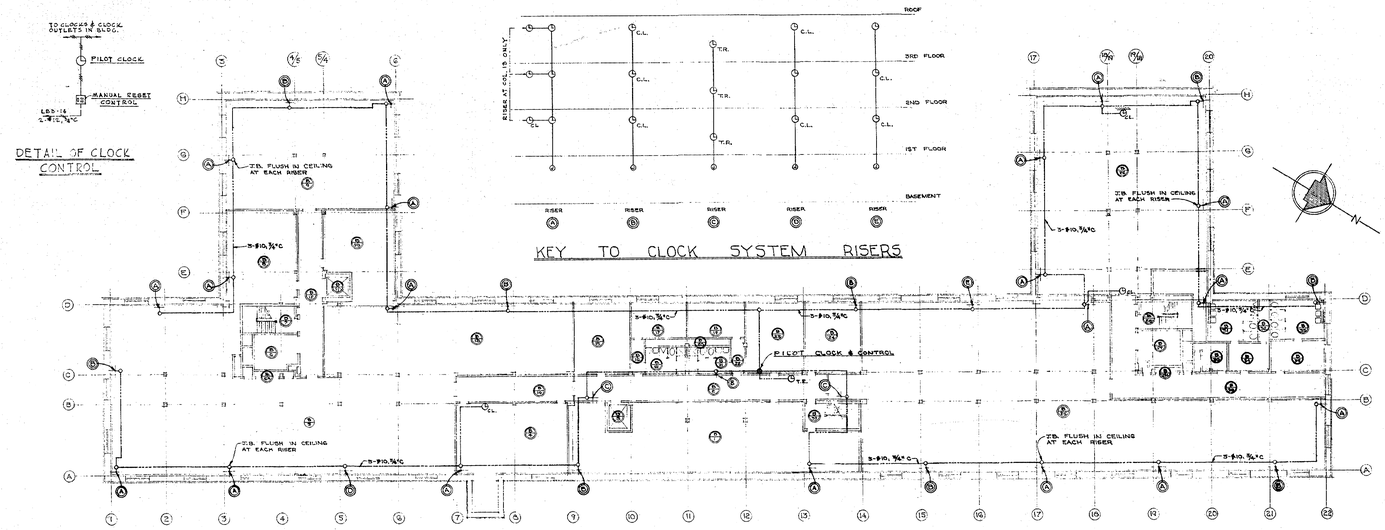

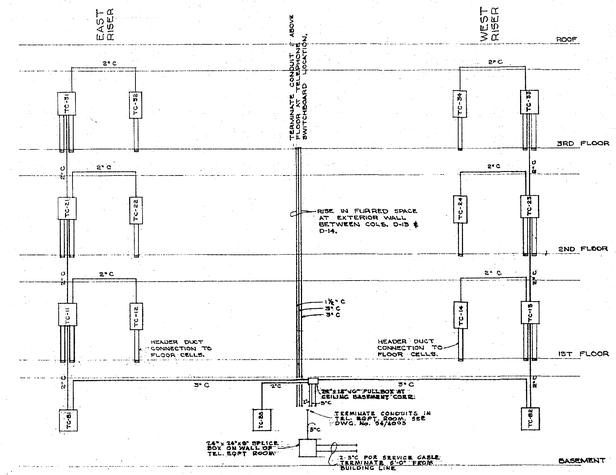

RISER DIAGRAM OF TELEPHONE CONDUIT SYSTEM

NO SCALE

1. BOXES NOS. TC-B1, TC-B2, TC-B3, TC-11, TC-12, TC-21, TC-23, TC-31 & TC-33 SHALL BE 30"H x 24"W x 4"D.
2. BOXES NOS. TC-13, TC-14, TC-22, TC-24, TC-32 & TC-34 SHALL BE 36"H x 18"W x 4"D.

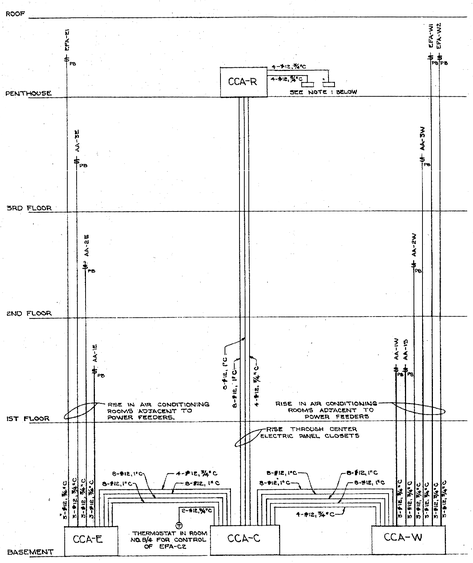

RISER DIAGRAM SHOWING CONTROL WIRING INTERCONNECTION BETWEEN CONTROL CENTERS

NO SCALE

NOTE:
1. FAN MOTORS FOR AA-C1 AND AA-C2 TO BE INTERLOCKED WITH INTAKE AIR LOUVERS SUCH THAT STARTING FAN WILL CAUSE THE LOUVERS TO OPEN AND FAN MOTORS CANNOT START UNTIL LOUVERS ARE IN FULL OPEN. POSITION.

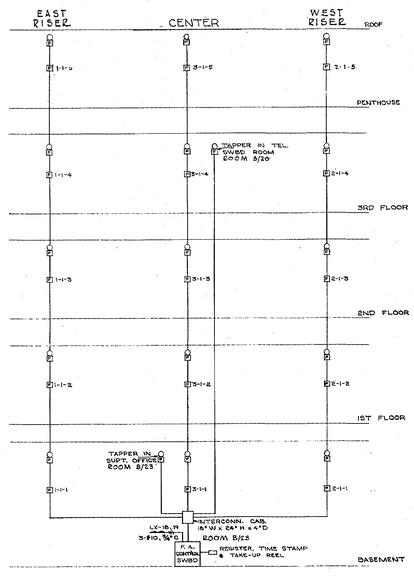

RISER DIAGRAM OF FIRE ALARM SYSTEM

NO SCALE

MINIMUM CONDUIT SIZE ¾"

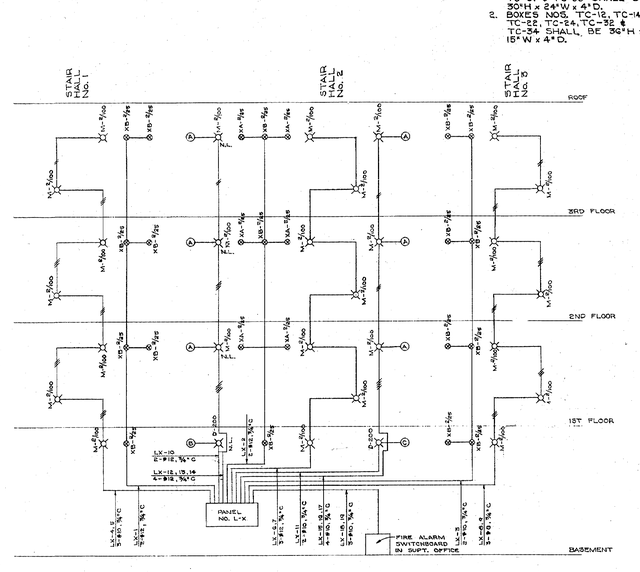

RISER DIAGRAM OF EXIT LIGHTS, STAIR HALL LIGHTS AND NIGHT LIGHTS

NO SCALE

Ⓐ CONNECT TO 4 TYPE M-8/100 NIGHT LIGHTS.
Ⓑ CONNECT TO 4 TYPE D-200 NIGHT LIGHTS.
Ⓒ CONNECT TO 1 TYPE D-200 & 3 TYPE M-8/100 NIGHT LIGHTS.

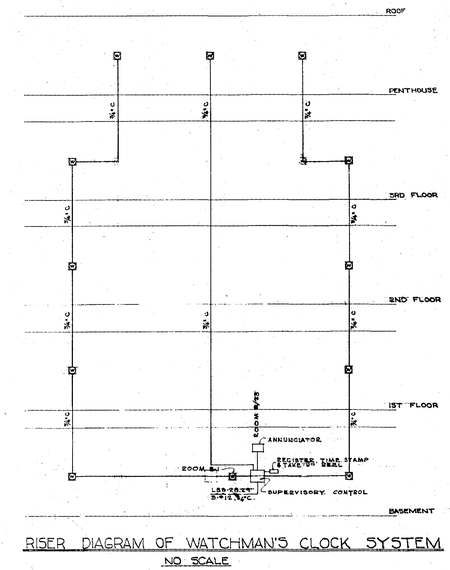

RISER DIAGRAM OF WATCHMAN'S CLOCK SYSTEM

NO SCALE

SCANNED 2005

DEPARTMENT OF CIVIL SERVICE STATE OFFICE BUILDING CAMPUS SITE ALBANY NEW YORK		
DRAWN BY H. H. F.	ELECTRIC	PROJECT NO. 32978
TRACED BY H. H. F.	RISER DIAGRAM & DETAILS	SPECIFICATION NO. 3884
CHECKED BY H. H. F.	KENNETH G. REYNOLDS & ASSOCIATES ARCHITECTS ALBANY, NEW YORK	DATE AUG. 9, 1954
STRUCTURAL CHECKED BY	J. L. OTTENHEIMER CONSULTING ENGINEER ALBANY, NEW YORK	SCALE AS NOTED
F. CLD CHECK BY ARCHT.	JOHN A. MAC CORMACK COMMISSIONER OF STANDARDS & PURCHASE	DRAWING NO. 54/3010
APPROVED BY ENG.	STATE OF NEW YORK DEPARTMENT OF PUBLIC WORKS DIVISION OF CONSTRUCTION BERTRAM D. FALLANY SUPERINTENDENT CORNELIUS J. WHITE STATE ARCHITECT	
APPROVED DATE AUG 26 1954	BLDG # 1	

NOTE: DRAWING NOT TO SCALE

NYS OFFICE OF GENERAL SERVICES

Serving New York

ANDREW M. CUOMO
Governor
ROANN M. DESTITO
Commissioner

CONSULTANT

WARNING:
THE ALTERATION OF THIS MATERIAL IN ANY WAY, UNLESS DONE UNDER THE DIRECTION OF A COMPARABLE PROFESSIONAL, I.E. ARCHITECT FOR AN ARCHITECT, ENGINEER FOR AN ENGINEER OR LANDSCAPE ARCHITECT FOR A LANDSCAPE ARCHITECT, IS A VIOLATION OF THE NEW YORK STATE EDUCATION LAW AND/OR REGULATIONS AND IS A CLASS 'A' MISDEMEANOR.

CONTRACT:
CONSTRUCTION

TITLE:
DEMOLISH BUILDING NOS. 1 & 1A

LOCATION:
STATE OFFICE BUILDING CAMPUS
1220 WASHINGTON AVENUE
ALBANY, N.Y. 12226

CLIENT:
NEW YORK STATE OFFICE OF GENERAL SERVICES

MARK	DATE	DESCRIPTION
	8/26/13	BID DOCUMENTS

PROJECT NUMBER: 44845 – C

DESIGNED BY:
DRAWN BY:
FIELD CHECK:
APPROVED:

SHEET TITLE:
EXIST. ELECTRICAL REF. DWG. RISER DIAGRAM AND DETAILS

DRAWING NUMBER:
54–4010

SHEET OF

Sep 12,2013 – 10:22am
V:\Designs\Construct\ga48sx\44845\CadStd\LELEC\54-4010.dwg
36x24 PLOT SHEET

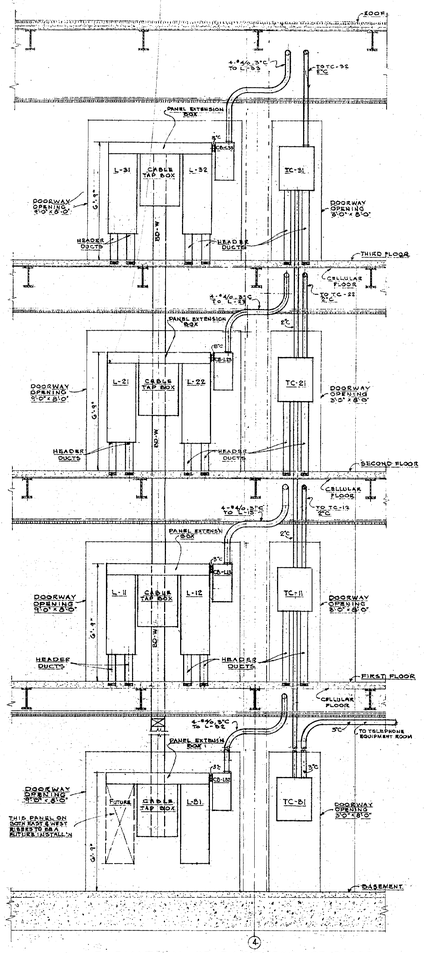

ELEVATION OF EAST SERVICE RISER
WEST SERVICE RISER SIMILAR BUT OPPOSITE HAND
SCALE 3/8" = 1'-0"

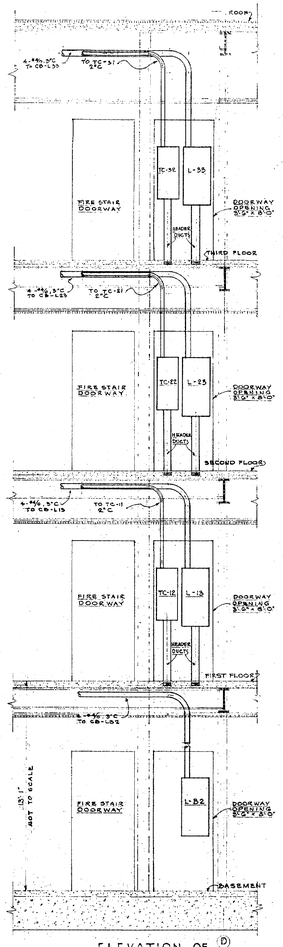

ELEVATION OF SOUTH-EAST SERVICE RISER
SOUTH-WEST SERVICE RISER SIMILAR BUT OPPOSITE HAND
SCALE 3/8" = 1'-0"

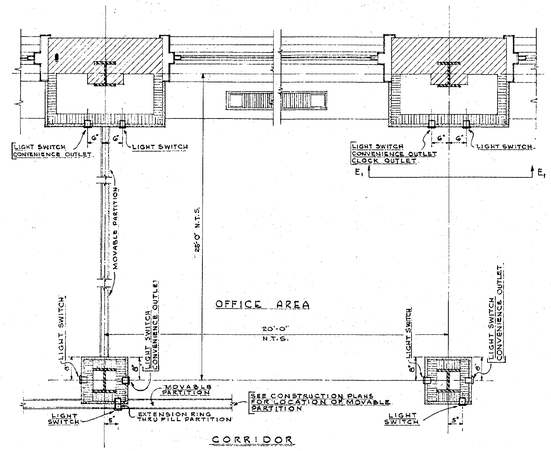

PLAN LAYOUT
TYPICAL BUILDING BAY
SHOWING UNIFORM LIGHT SWITCH CONVENIENCE OUTLET AND CLOCK OUTLET LOCATIONS
SCALE 3/8" = 1'-0"

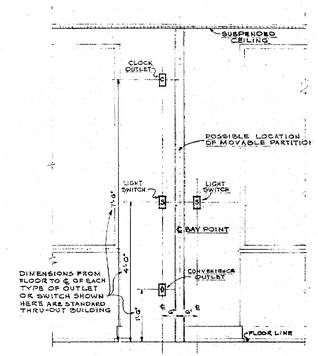

DETAIL SECTION E1-E1
SCALE 3/8" = 1'-0"

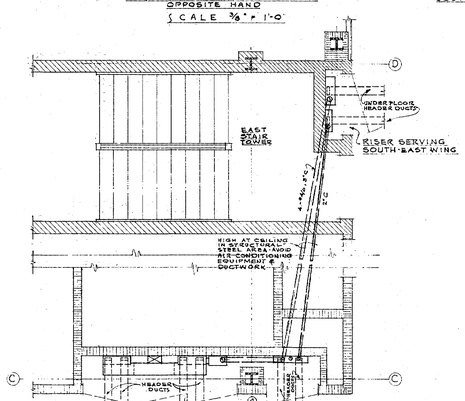

TYPICAL PLAN-FIRST, SECOND & THIRD FLOORS - EAST & SOUTH-EAST SERVICE RISERS
WEST AND SOUTH-WEST RISERS SIMILAR BUT OPPOSITE HAND
SCALE 3/8" = 1'-0"

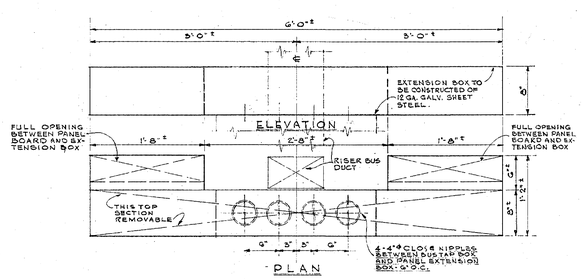

TYPICAL DETAIL
PANEL EXTENSION BOX
ALL DIMENSIONS TO BE VERIFIED ON FINAL SELECTION OF EQUIPMENT BY CONTRACTOR
SCALE 3/8" = 1'-0"

SCANNED 2005

DEPARTMENT OF CIVIL SERVICE
STATE OFFICE BUILDING
CAMPUS SITE ALBANY NEW YORK

DRAWN BY H.M.R.	ELECTRIC	PROJECT NO. 12978
TRACED BY P.E.N.	MISCELLANEOUS DETAILS	SPECIFICATION NO. 18884
MECHANICAL CONSULTING ENGINEER R.H.P.	KENNETH L. REYNOLDS & ASSOCIATES ARCHITECTS ALBANY, NEW YORK	DATE AUG. 9, 1954
STRUCTURAL CONSULTING ENGINEER	J.L. OTTENHEIMER, CONSULTING ENGINEER ALBANY, NEW YORK	SCALE AS NOTED
FIELD CHECK BY ARCH't.	JOHN A. MAC CORMACK COMMISSIONER OF STANDARDS & PURCHASE STATE OF NEW YORK	DRAWING NO. 54/4011
ENG. APPROVED BY	DEPARTMENT OF PUBLIC WORKS DIVISION OF CONSTRUCTION BERTRAM D. TALLAMY COMMISSIONER — CORNELIUS J. WHITE ASSISTANT STATE ARCHITECT	

APPROVED
DATE AUG 26 1954
BLDG# 1

NOTE: DRAWING NOT TO SCALE

NYS OFFICE OF GENERAL SERVICES
Serving New York
ANDREW M. CUOMO
Governor
ROANN M. DESTITO
Commissioner

CONSULTANT

WARNING:
THE ALTERATION OF THIS MATERIAL IN ANY WAY, UNLESS DONE UNDER THE DIRECTION OF A COMPARABLE PROFESSIONAL, I.E. ARCHITECT FOR AN ARCHITECT, ENGINEER FOR AN ENGINEER OR LANDSCAPE ARCHITECT FOR A LANDSCAPE ARCHITECT, IS A VIOLATION OF THE NEW YORK STATE EDUCATION LAW AND/OR REGULATIONS AND IS A CLASS 'A' MISDEMEANOR.

CONTRACT:
CONSTRUCTION

TITLE:
DEMOLISH BUILDING
NOS. 1 & 1A

LOCATION:
STATE OFFICE BUILDING CAMPUS
1220 WASHINGTON AVENUE
ALBANY, N.Y. 12226

CLIENT:
NEW YORK STATE
OFFICE OF GENERAL SERVICES

MARK	DATE	DESCRIPTION
	8/26/13	BID DOCUMENTS

PROJECT NUMBER:	44845 – C
DESIGNED BY:	
DRAWN BY:	
FIELD CHECK:	
APPROVED:	

SHEET TITLE:
EXIST. ELECTRICAL REF. DWG.
MISCELLANEOUS DETAILS

DRAWING NUMBER:
54–4011

SHEET OF

Sep 12,2013 – 10:27am
V:\Design\ndcomp\44845\CadStd\ELEC\54-4011.dwg
36x24 PLOT SHEET

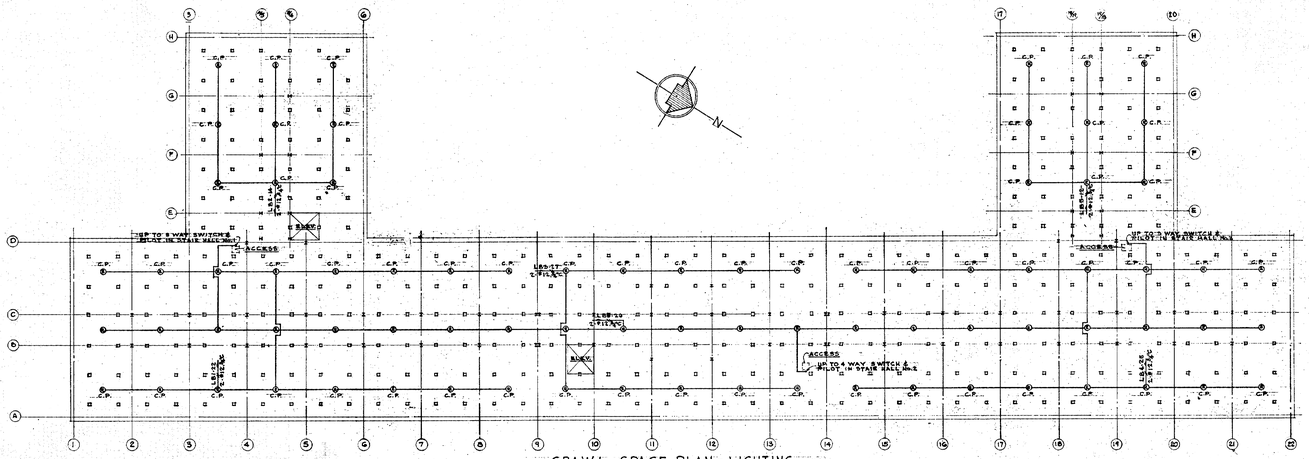

CRAWL SPACE PLAN - LIGHTING

SCALE 1/8"=1'-0"

60 WATT LAMPS IN ALL FIXTURES.

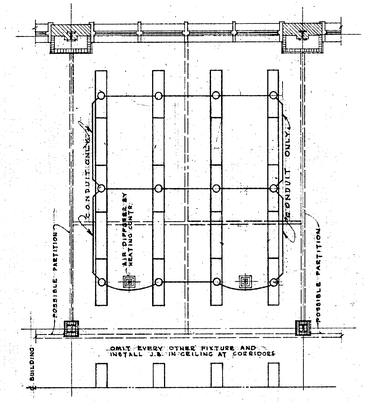

TYPICAL BAY LIGHTING

SHOWING LIGHTING LAYOUT, CONDUIT LAYOUT AND PARTITION MODULES

SCALE 1/4"=1'-0"

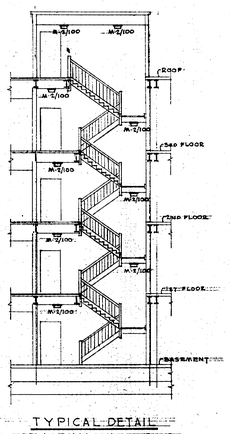

TYPICAL DETAIL
STAIRHALL LIGHTING

SCALE 1/8"=1'-0"

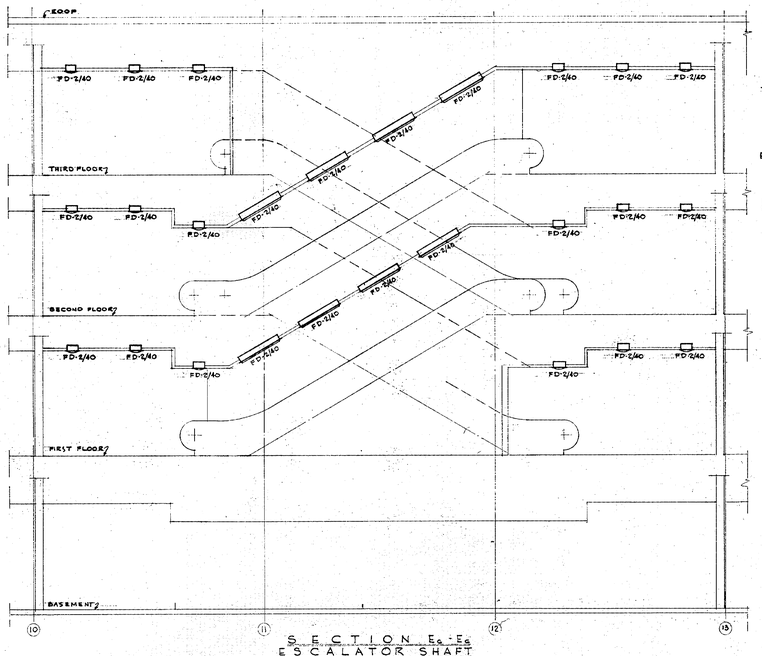

SECTION E₁-E₂
ESCALATOR SHAFT

SCALE 1/4"=1'-0"

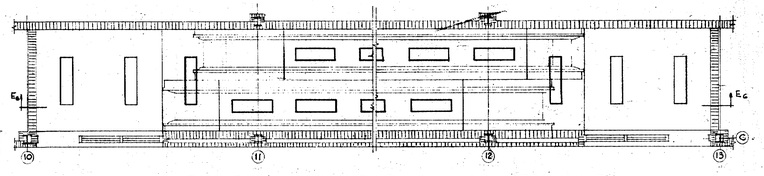

TYPICAL LIGHTING PLAN - ESCALATOR SHAFT

SCALE 1/4"=1'-0"

NOTE:
1. ALL FIXTURES SIMILAR TO TYPE FD-2/40, MAXIMUM RECESS 6".

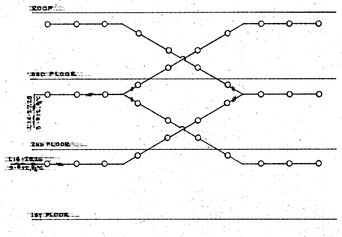

RISER DIAGRAM OF ESCALATOR LIGHTING

NO SCALE

SCANNED
2005

DEPARTMENT OF CIVIL SERVICE STATE OFFICE BUILDING CAMPUS SITE ALBANY NEW YORK		
DRAWN BY H.M.F.	ELECTRIC	PROJECT NO. 12976
TRACED BY F.E.M.	MISCELLANEOUS DETAILS & CRAWL SPACE LIGHTING PLAN	SPECIFICATION NO. 15654
CHECKED BY H.M.F.	KENNETH G. REYNOLDS & ASSOCIATES ARCHITECTS ALBANY, NEW YORK	DATE AUG. 9, 1954
STRUCTURAL CHECKED BY	J.L. OTTENHEIMER CONSULTING ENGINEER ALBANY, NEW YORK	SCALE AS NOTED
FIELD CHECK BY ARCHT.	JOHN A. MAC CORMACK COMMISSIONER OF STANDARDS & PURCHASE STATE OF NEW YORK	DRAWING NO. 54/4012
ENG.	DEPARTMENT OF PUBLIC WORKS DIVISION OF CONSTRUCTION	
APPROVED BY	NATHAN G. TALLMAN STATE ARCHITECT; CORNELIUS J. WHITE SUPERINTENDING STATE ARCHITECT	
APPROVED DATE	AUG 26 1954	BLDG. # 1

NOTE: DRAWING NOT TO SCALE

NYS OFFICE OF GENERAL SERVICES

Serving New York

ANDREW M. CUOMO
Governor
ROANN M. DESTITO
Commissioner

CONSULTANT

WARNING:

THE ALTERATION OF THIS MATERIAL IN ANY WAY, UNLESS DONE UNDER THE DIRECTION OF A COMPARABLE PROFESSIONAL, I.E. ARCHITECT FOR AN ARCHITECT, ENGINEER FOR AN ENGINEER OR LANDSCAPE ARCHITECT FOR A LANDSCAPE ARCHITECT, IS A VIOLATION OF THE NEW YORK STATE EDUCATION LAW AND/OR REGULATIONS AND IS A CLASS 'A' MISDEMEANOR.

CONTRACT:
CONSTRUCTION

TITLE:
DEMOLISH BUILDING
NOS. 1 & 1A

LOCATION:
STATE OFFICE BUILDING CAMPUS
1220 WASHINGTON AVENUE
ALBANY, N.Y. 12226

CLIENT:
NEW YORK STATE
OFFICE OF GENERAL SERVICES

MARK	DATE	DESCRIPTION
	8/26/13	BID DOCUMENTS

PROJECT NUMBER: 44845 – C

DESIGNED BY:
DRAWN BY:
FIELD CHECK:
APPROVED:

SHEET TITLE:
EXIST. ELECTRICAL REF. DWG. MISCELLANEOUS DETAILS & CRAWL SPACE LGHT'G. PLAN

DRAWING NUMBER:
54–4012

SHEET OF

Sep 12,2013 – 10:26am
V:\Designs\Constr\ga48sx\(44845)\ConStru\ELEC\54-4012.dwg
36x24 PLOT SHEET

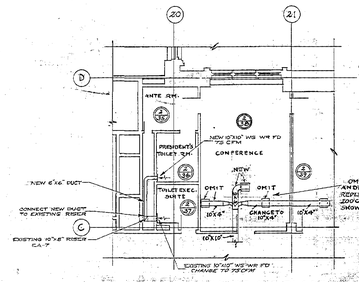

PART PLAN OF 2ND FLOOR
SCALE 1/8" = 1'-0"

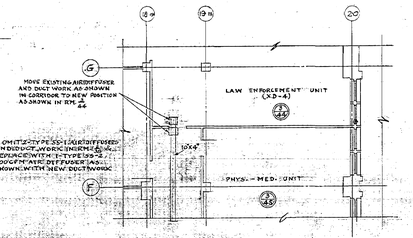

PART PLAN OF 3RD FLOOR
SCALE 1/8" = 1'-0"

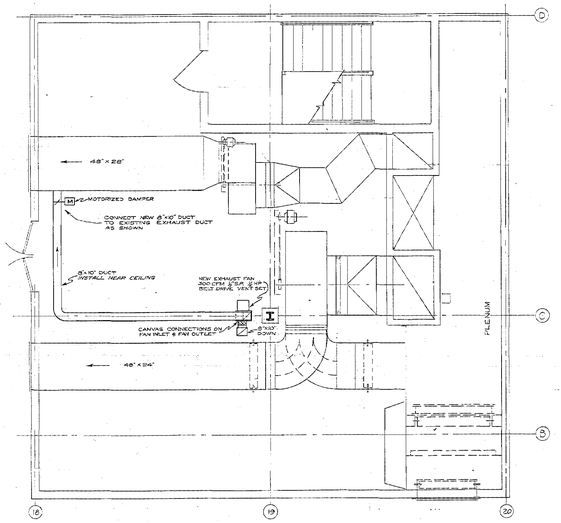

PLAN OF WEST PENTHOUSE
SCALE 1/4" = 1'-0"

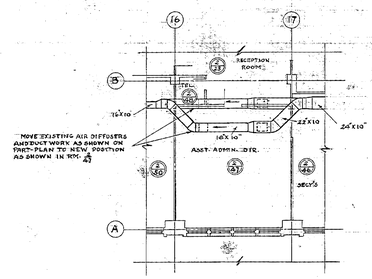

PART PLAN OF 2ND FLOOR
SCALE 1/8" = 1'-0"

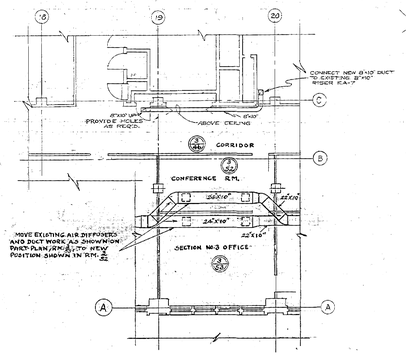

PART PLAN OF 3RD FLOOR
SCALE 1/8" = 1'-0"

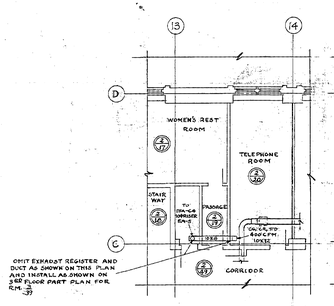

PART PLAN OF 2ND FLOOR
SCALE 1/8" = 1'-0"

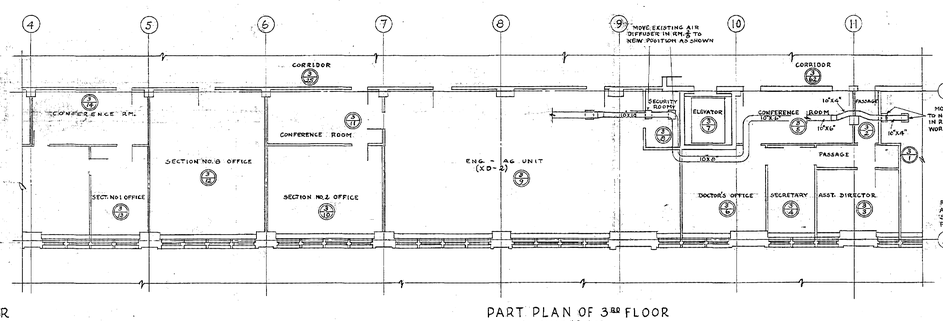

PART PLAN OF 3RD FLOOR
SCALE 1/8" = 1'-0"

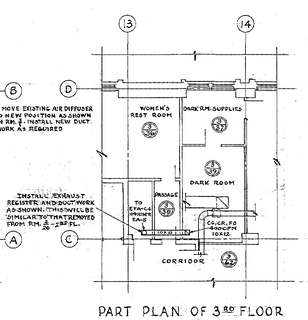

PART PLAN OF 3RD FLOOR
SCALE 1/8" = 1'-0"

NOTE:
FOLLOW THE CONTRACT DRAWINGS EXCEPT AS INDICATED ON THIS DRAWING. THE INTERCHANGE OF THE SECOND AND THIRD FLOOR PLANS DOES NOT AFFECT THE HEATING WORK EXCEPT FOR THIS DRAWING. SEE CONSTRUCTION DRAWINGS 56/154 AND 1/155 FOR ADDITIONAL INFORMATION.

SCANNED 2005

DEPARTMENT OF CIVIL SERVICE STATE OFFICE BUILDING CAMPUS SITE ALBANY NEW YORK		
DRAWN BY W.F.R.	HEATING	PROJECT NO. 12978
TRACED BY W.F.R.	INTERCHANGE OF SECOND & THIRD FLOOR PLANS (REDRAWN FROM BASE DRAWINGS ORIGINAL CONTRACT DRAWINGS)	SPECIFICATION NO. 16682
CHECKED BY G.J.M.	PART SECOND AND THIRD FLOOR PLANS	DATE MAY 10, 1956
X-CHECKED BY G.J.M.		SCALE AS SHOWN
FIELD CHECK BY	STATE OF NEW YORK	DRAWING NO.
ARCH'T.	DEPARTMENT OF PUBLIC WORKS	56
CHECK	DIVISION OF ARCHITECTURE	/2015
APPROVED	CARL W. LARSON ACTING STATE ARCHITECT	
APPROVED DATE	BLDG # 1	

NOTE: DRAWING NOT TO SCALE

Sep 12,2013 - 9:56am
W:\Designs\Consult\ph48xx\44845\ConStruc\HVAC\56-2015.dwg
36x24 PLOT SHEET

NYS OFFICE OF GENERAL SERVICES
Serving New York
ANDREW M. CUOMO
Governor
ROANN M. DESTITO
Commissioner

CONSULTANT

WARNING:
THE ALTERATION OF THIS MATERIAL IN ANY WAY, UNLESS DONE UNDER THE DIRECTION OF A COMPARABLE PROFESSIONAL, I.E. ARCHITECT FOR AN ARCHITECT, ENGINEER FOR AN ENGINEER OR LANDSCAPE ARCHITECT FOR A LANDSCAPE ARCHITECT, IS A VIOLATION OF THE NEW YORK STATE EDUCATION LAW AND/OR REGULATIONS AND IS A CLASS 'A' MISDEMEANOR.

MARK	DATE	DESCRIPTION
	8/26/13	BID DOCUMENTS

CONTRACT:
CONSTRUCTION

TITLE:
DEMOLISH BUILDING NOS. 1 & 1A

LOCATION:
STATE OFFICE BUILDING CAMPUS
1220 WASHINGTON AVENUE
ALBANY, N.Y. 12226

CLIENT:
NEW YORK STATE OFFICE OF GENERAL SERVICES

PROJECT NUMBER: 44845 – C
DESIGNED BY:
DRAWN BY:
FIELD CHECK:
APPROVED:

SHEET TITLE:
EXIST. HVAC REF. DWG. PART 2ND & 3RD FLOOR PLANS

DRAWING NUMBER:
56–2015

SHEET OF

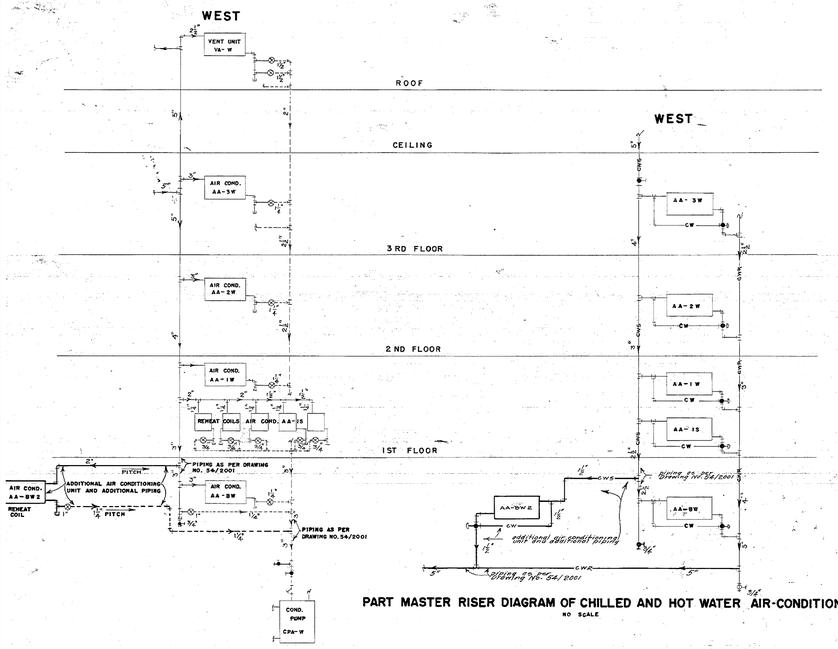

PART MASTER RISER DIAGRAM OF STEAM AND CONDENSATE RETURN PIPING

NO SCALE

PART MASTER RISER DIAGRAM OF CHILLED AND HOT WATER AIR-CONDITIONING PIPING

NO SCALE

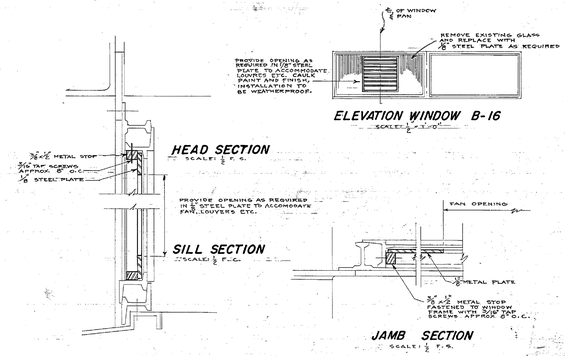

DETAILS OF EXISTING WINDOW B-16
SHOWING REPLACEMENT OF GLASS WITH 1/8" STEEL PLATE

NOTES

TR – TOP REGISTER. RETURN AIR REGISTER TO BE SIMILAR AND EQUAL TO TUTTLE & BAILEY NO. T88 OR APPROVED EQUAL. SUPPLY AIR REGISTERS TO BE SIMILAR AND EQUAL TO TUTTLE & BAILEY NO. T647 OR APPROVED EQUAL.

ALL GALVANIZED IRON DUCTS, WHERE EXPOSED AND UNCOVERED, SHALL BE PAINTED WITH ONE PRIME COAT OF GALVANUM AND TWO COATS OF LEAD AND OIL PAINT, COLOR AS DIRECTED.

PIPING CONNECTIONS TO COOLING COIL AND HEATING COIL FOR ADDITIONAL AIR CONDITIONING UNIT AA – BW2 SHALL BE AS SHOWN ON DRAWING 54/2011, PART MASTER RISER DIAGRAMS ON THIS DRAWING, AND AS SPECIFIED.

SUPPLY AIR DIFFUSERS (SS-1) SHALL BE OF TYPE NOTED ON THIS DRAWING, AS DESCRIBED ON DRAWING NO. 54/2011 AND AS SPECIFIED.

ALL ITEMS OF THE SPECIFICATION APPLYING TO THE SUPPLY DIFFUSERS AND DUCTWORK ON THE FIRST FLOOR ALSO APPLY TO THE ADDITIONAL DUCTWORK TO THE DARK ROOM ON THE FIRST FLOOR.

ADDITIONAL AIR CONDITIONING UNIT AA-BW2 SHALL BE CONTROLLED THE SAME AS SPECIFIED AND AS SHOWN ON DRAWING 54/2013 FOR AIR CONDITIONING UNIT AA-1W EXCEPT THAT THE ADDITIONAL EXHAUST FAN WITH INTEGRAL MOTORIZED DAMPERS AS INDICATED ON THIS SHEET SHALL BE STARTED IN LIEU OF EXHAUST FAN EFA-W1 WHEN A.C. UNIT AA-BW2 IS STARTED.

ADDITIONAL EXHAUST FAN INDICATED ON THIS DRAWING SHALL HAVE A CAPACITY OF 1068 CFM AT A STATIC PRESSURE OF 1/2 INCH OF WATER AT A SPEED OF 1725 R.P.M. FAN SHALL BE PROPELLER TYPE WITH INTEGRAL MOTORIZED SHUTTERS. MOTOR TO BE TWO SPEED, 1/3 H.P., 208 V, SINGLE PHASE TYPE. FAN SHALL BE SIMILAR AND EQUAL TO BUFFALO FORGE CO., "N.V." DESIGN "A", SIZE 12" PROPELLER FAN, DIRECT CONNECTED, WITH WIRE FAN GUARD AND INTEGRAL MOTORIZED SHUTTERS, OR APPROVED EQUAL. FURNISH MOTOR STARTER G.E. 10GCR OR APPROVED EQUAL.

V.C.D. – VOLUME DAMPER AND DISTRIBUTION CONTROL DEVICE TO BE SIMILAR AND EQUAL TO TUTTLE AND BAILEY NO 970 OR APPROVED EQUAL.

CONTRACTOR SHALL VERIFY ALL DIMENSIONS AND CONDITIONS AT SITE.

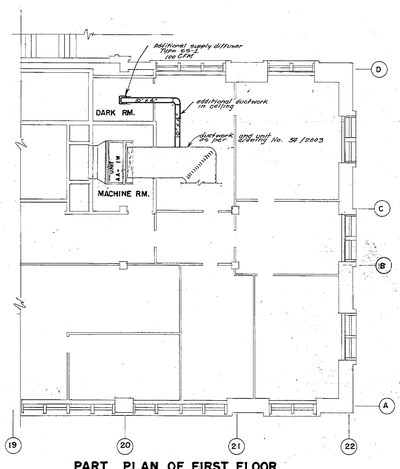

PART PLAN OF FIRST FLOOR

SCALE: 1/8" = 1'-0"

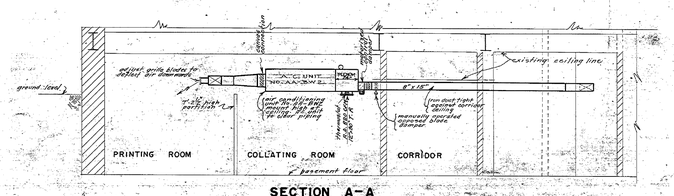

SECTION A–A

SCALE: 1/4" = 1'-0"

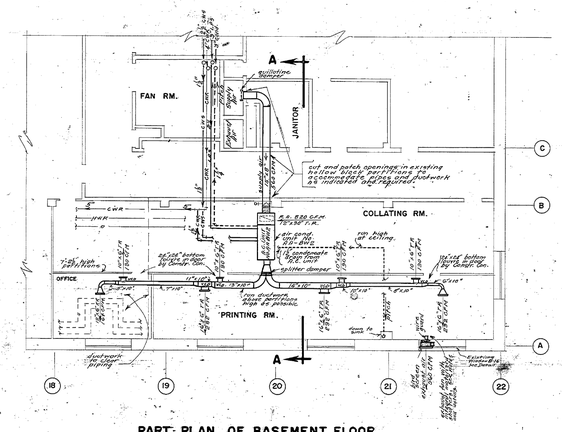

PART PLAN OF BASEMENT FLOOR

SCALE: 1/8" = 1'-0"

SCHEDULE FOR INTERIOR AIR-CONDITIONING UNIT AA-BW2

FAN		REHEAT COIL		BLANK COIL SECTION	COOLING COIL		FILTER		MANUFACTURER & NO. OR APPROVED EQUAL
CFM	1380	ENT. TEMP.	67° F		ENT. D.B. TEMP.	82° F	TYPE	PERM.	BUFFALO FORGE CO.
EXTERNAL DUCT-RES.	0.6	AVG. TEMP.	90°F	YES	ENT. W.B. TEMP.	69° F	FACE VEL.	400	NO. P.C.-6-121
OUTLET VEL.	1180 FPM	STEAM	5 PSIG		LVG. D.B. TEMP.	61° F		CLEAN	
WHEEL DIA.	12"	TYPE	NF 21		LVG. W.B. TEMP.	59° F	%	0-12	
MOTOR H.P.	1/3				FACE VEL. FPM	525		DIRTY	
MOTOR SER. ELIMINATOR	YES				ENT. WATER TEMP.	42° F	RES.	0.25	
MOTOR STR. CONTROL CTR.	CCA-W				WATER FLOW GPM	20			
					WATER RES.	2 FT.			

SCANNED 2005

DEPARTMENT OF CIVIL SERVICE
STATE OFFICE BUILDING

CAMPUS SITE — ALBANY, NEW YORK

DRAWN BY J. CHURAN	HEATING	PROJECT NO. 12978
CHECKED BY J. CHURAN	BUILDING NO. 1	SPECIFICATION NO. 18882
TRACED BY H. KLIME	PART BASEMENT PLAN AIR CONDITIONING OF PRINTING ROOM COLLATING ROOM AND OFFICE	DATE JUNE 25, 1957
X-CHECKED BY		SCALE AS NOTED
FIELD CHECK BY MPH	STATE OF NEW YORK DEPARTMENT OF PUBLIC WORKS DIVISION OF ARCHITECTURE	DRAWING NO. 57/2016
APPROVED BY	CARL W. LARSON STATE ARCHITECT	
APPROVED BY		
DATE	BLDG. # 1	

NOTE: DRAWING NOT TO SCALE

Sep 12,2013 – 9:56am
V:\Designed\Const\p44845x\44845\CadStrc\HVAC\56-2016.dwg
36x24 PLOT SHEET

NYS OFFICE OF GENERAL SERVICES
Serving New York

ANDREW M. CUOMO
Governor
ROANN M. DESTITO
Commissioner

CONSULTANT

WARNING:
THE ALTERATION OF THIS MATERIAL IN ANY WAY, UNLESS DONE UNDER THE DIRECTION OF A COMPARABLE PROFESSIONAL, I.E. ARCHITECT FOR AN ARCHITECT, ENGINEER FOR AN ENGINEER OR LANDSCAPE ARCHITECT FOR A LANDSCAPE ARCHITECT, IS A VIOLATION OF THE NEW YORK STATE EDUCATION LAW AND/OR REGULATIONS AND IS A CLASS 'A' MISDEMEANOR.

CONTRACT: CONSTRUCTION

TITLE: DEMOLISH BUILDING NOS. 1 & 1A

LOCATION: STATE OFFICE BUILDING CAMPUS
1220 WASHINGTON AVENUE
ALBANY, N.Y. 12226

CLIENT: NEW YORK STATE OFFICE OF GENERAL SERVICES

MARK	DATE	DESCRIPTION
	8/26/13	BID DOCUMENTS

PROJECT NUMBER: 44845 – C

DESIGNED BY:
DRAWN BY:
FIELD CHECK:
APPROVED:

SHEET TITLE: EXIST. HVAC REF. DWG. PART BSMT. PLAN – AIR CONDITION'G – PRINT ETC. RM.

DRAWING NUMBER: 56–2016

SHEET OF

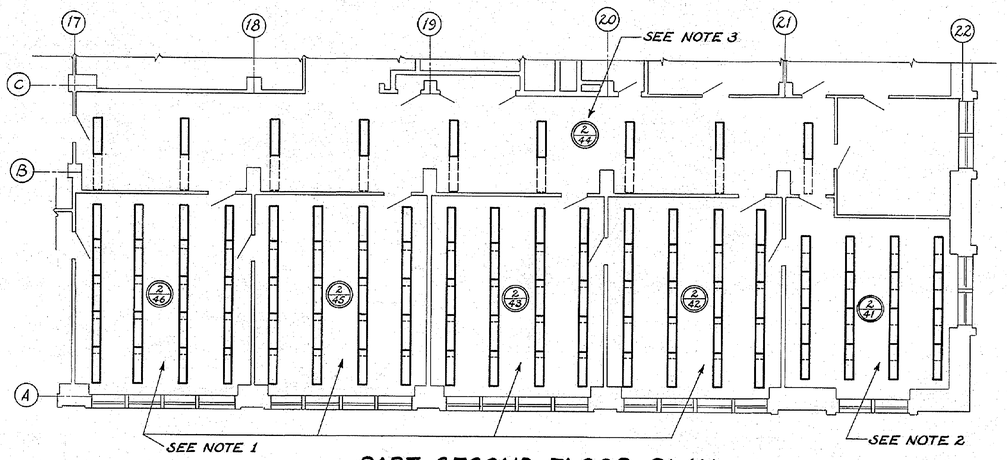

PART SECOND FLOOR PLAN
(ORIGINAL 3RD FLOOR)

NOTES

1. FLUORESCENT FIXTURES IN ROOMS 2/42, 2/43, 2/45 & 2/46 SHALL BE MOUNTED IN 4 CONTINUOUS ROWS OF 5 FIXTURES EACH INSTEAD OF 4 CONTINUOUS ROWS OF 3 FIXTURES EACH AS SHOWN ON ORIGINAL CONTRACT DRAWING.
2. FLUORESCENT FIXTURES IN ROOM 2/41 SHALL BE MOUNTED IN 4 CONTINUOUS ROWS OF 4 FIXTURES EACH INSTEAD OF 4 CONTINUOUS ROWS OF 3 EACH AS SHOWN ON ORIGINAL CONTRACT DRAWING.
3. CORRIDOR 2/44 SHALL HAVE 9 SINGLE FLUORESCENT FIXTURES INSTEAD OF 9 ROWS OF 2 FIXTURES EACH AS SHOWN ON ORIGINAL CONTRACT DRAWING.
4. FLUORESCENT FIXTURES IN ROOM 3/3 & PASSAGE BETWEEN ROOMS 3/3 & 3/2 SHALL BE MOUNTED & SWITCHED AS SHOWN ON THIS DRAWING INSTEAD OF AS SHOWN ON ORIGINAL CONTRACT DRAWING.

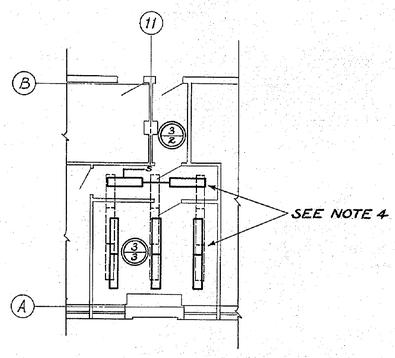

PART THIRD FLOOR PLAN
(ORIGINAL 2ND FLOOR)

SYMBOLS

FLUORESCENT FIXTURE AS SHOWN ON ORIGINAL CONTRACT DRAWINGS

FLUORESCENT FIXTURE AS REQUIRED

REVISIONS

SCANNED 2005

DEPARTMENT OF CIVIL SERVICE STATE OFFICE BUILDING CAMPUS SITE ALBANY NEW YORK		
DRAWN BY HM	ELECTRIC	PROJECT NO. 12978
TRACED BY HM	INTERCHANGE OF 2ND & 3RD FLOOR PLANS (REVISION IN LAYOUT FROM ORIGINAL CONTRACT DWGS.)	SPECIFICATION NO. 18884
CHECKED BY		DATE MAY 23, 1956
CROSS CHECK BY	REVISED PART 2ND & 3RD FL. PLANS	SCALE 1/8" = 1'-0"
FIELD CHECK BY ARCH'T. ENGR.	STATE OF NEW YORK DEPARTMENT OF PUBLIC WORKS DIVISION OF ARCHITECTURE CARL W. LARSON - ACTING STATE ARCHITECT	DRAWING NO. 56/4013
APPROVED BY CWL		
BLDG. # 1		

NOTE: DRAWING NOT TO SCALE

NYS OFFICE OF GENERAL SERVICES
Serving New York

ANDREW M. CUOMO
Governor
ROANN M. DESTITO
Commissioner

CONSULTANT

WARNING:
THE ALTERATION OF THIS MATERIAL IN ANY WAY, UNLESS DONE UNDER THE DIRECTION OF A COMPARABLE PROFESSIONAL, I.E. ARCHITECT FOR AN ARCHITECT, ENGINEER FOR AN ENGINEER OR LANDSCAPE ARCHITECT FOR A LANDSCAPE ARCHITECT, IS A VIOLATION OF THE NEW YORK STATE EDUCATION LAW AND/OR REGULATIONS AND IS A CLASS 'A' MISDEMEANOR.

CONTRACT: CONSTRUCTION

TITLE: DEMOLISH BUILDING NOS. 1 & 1A

LOCATION: STATE OFFICE BUILDING CAMPUS
1220 WASHINGTON AVENUE
ALBANY, N.Y. 12226

CLIENT: NEW YORK STATE OFFICE OF GENERAL SERVICES

MARK	DATE	DESCRIPTION
	8/26/13	BID DOCUMENTS

PROJECT NUMBER:	44845 - C
DESIGNED BY:	
DRAWN BY:	
FIELD CHECK:	
APPROVED:	

SHEET TITLE: EXIST. ELECTRICAL REF. DWG. REVISED PART 2ND & 3RD FLR. PLANS

DRAWING NUMBER: 54-4013

SHEET OF

Sep 12,2013 - 10:26am
V:\DesignAndConstr\p448xx\44845\CadStru\ELEC\56-4013.dwg
36x24 PLOT SHEET

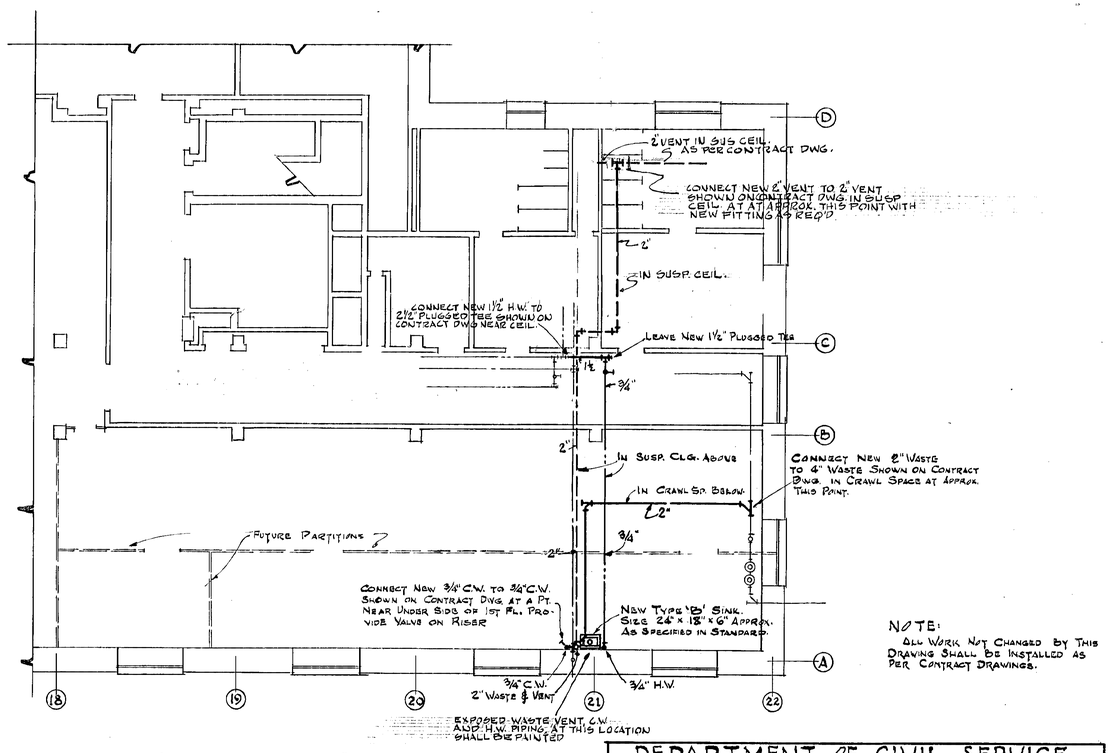

NOTE:
ALL WORK NOT CHANGED BY THIS DRAWING SHALL BE INSTALLED AS PER CONTRACT DRAWINGS.

PART BASEMENT PLAN
SCALE: 1/8" = 1'-0"

DEPARTMENT OF CIVIL SERVICE STATE OFFICE BUILDING CAMPUS SITE, ALBANY, NEW YORK		
DRAWN BY	SANITARY	PROJECT NO. 12978
TRACED BY	REVISION OF PIPING IN BASEMENT	SPECIFICATION NO. 18883
CHECKED BY		DATE MAY 13TH 1957 REVISED ~~APR. 24, 1957~~
X CHECK BY		SCALE As NOTED
F. CHECK BY	STATE OF NEW YORK DEPARTMENT OF PUBLIC WORKS DIVISION OF ARCHITECTURE CARL W. LARSON STATE ARCHITECT	DRAWING NO. 57 3011
APPROVED BY		

SCANNED
2005

NOTE: DRAWING NOT TO SCALE

NYS OFFICE OF GENERAL SERVICES
Serving New York

ANDREW M. CUOMO
Governor
ROANN M. DESTITO
Commissioner

CONSULTANT

WARNING:
THE ALTERATION OF THIS MATERIAL IN ANY WAY, UNLESS DONE UNDER THE DIRECTION OF A COMPARABLE PROFESSIONAL, I.E. ARCHITECT FOR AN ARCHITECT, ENGINEER FOR AN ENGINEER OR LANDSCAPE ARCHITECT FOR A LANDSCAPE ARCHITECT, IS A VIOLATION OF THE NEW YORK STATE EDUCATION LAW AND/OR REGULATIONS AND IS A CLASS 'A' MISDEMEANOR.

CONTRACT:
CONSTRUCTION

TITLE:
DEMOLISH BUILDING
NOS. 1 & 1A

LOCATION:
STATE OFFICE BUILDING CAMPUS
1220 WASHINGTON AVENUE
ALBANY, N.Y. 12226

CLIENT:
NEW YORK STATE
OFFICE OF GENERAL SERVICES

MARK	DATE	DESCRIPTION
	8/26/13	BID DOCUMENTS

PROJECT NUMBER: 44845 – C
DESIGNED BY:
DRAWN BY:
FIELD CHECK:
APPROVED:

SHEET TITLE:
EXIST. PLUMBING REF. DWG.
REVISION OF PIPING
IN BASEMENT

DRAWING NUMBER:
57–3011

SHEET OF

Sep 12,2013 – 10:17am
V:\DesignAndConstr\p448xx\44845\CadStru\PLUM\57-3011.dwg
36x24 PLOT SHEET

PARTITION SCHEDULE

SPACE DESIGNATION	SPACE NUMBER	PARTITION TYPES	SEE DET. DWG. NO.	REMARKS
COLLATING ROOM	B-1	CEC-1		
PRINTING ROOM	B-2	C-1		
OFFICE	B-3	CEC-1		
PAINT SHOP	B-4			
CARPENTRY SHOP	B-5		57-179	
PLUMBING SHOP	B-6	C		
ELECTRIC SHOP	B-7			
CORRIDOR	B-8			
PUBLIC WORKS STORAGE	B-9			

DOOR SCHEDULE

DOOR NUMBER	MATERIAL	TYPE	SIZE	CLASS	JAMB & TRIM TYPE	SADDLE MATERIAL	SADDLE TYPE	REMARKS
BD-1		3		OB.		—	—	
BD-2		3		OB.		—	—	
BD-3		3		OB.		—	—	
BD-4		4		OB.		—	—	
BD-5		2		—		—	—	
BD-6		2		—		—	—	
BD-7	HLM	2	3'-0" x 6'-10"	—	SEE DET. DWG. 57-179	—	—	
BD-8		2		—		—	—	
BD-9		2		—		—	—	
BD-10		2		—		—	—	
BD-11		2		—		—	—	
BD-12		5B		—		—	—	DUTCH DOOR

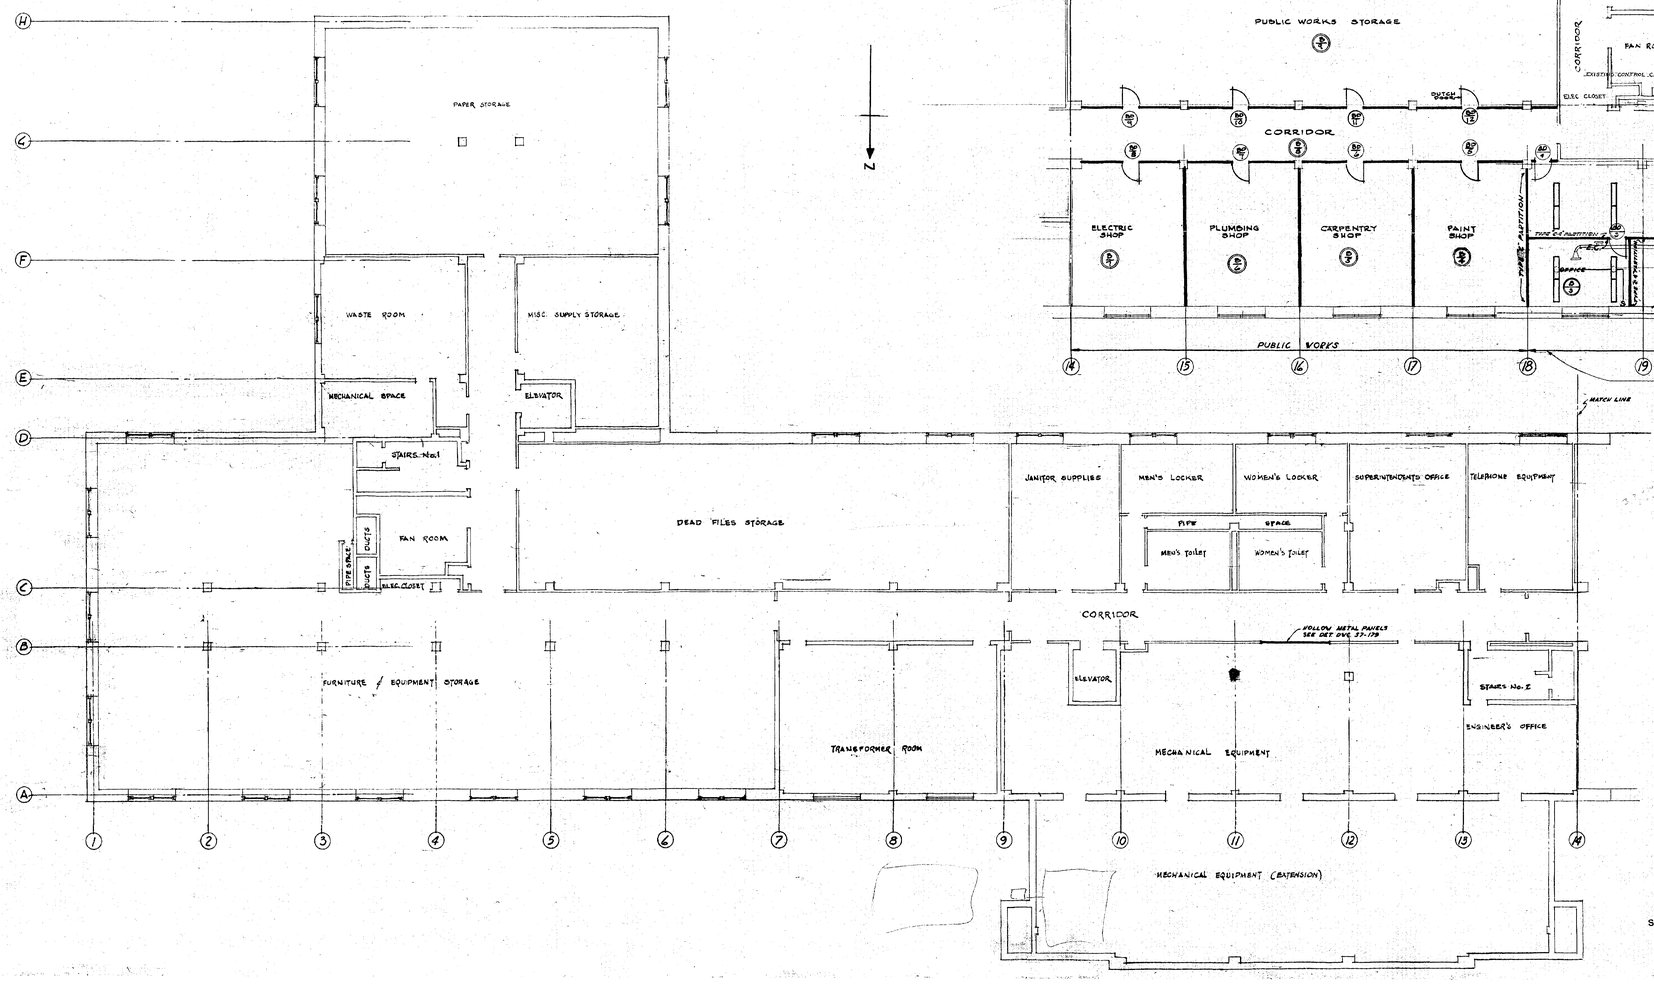

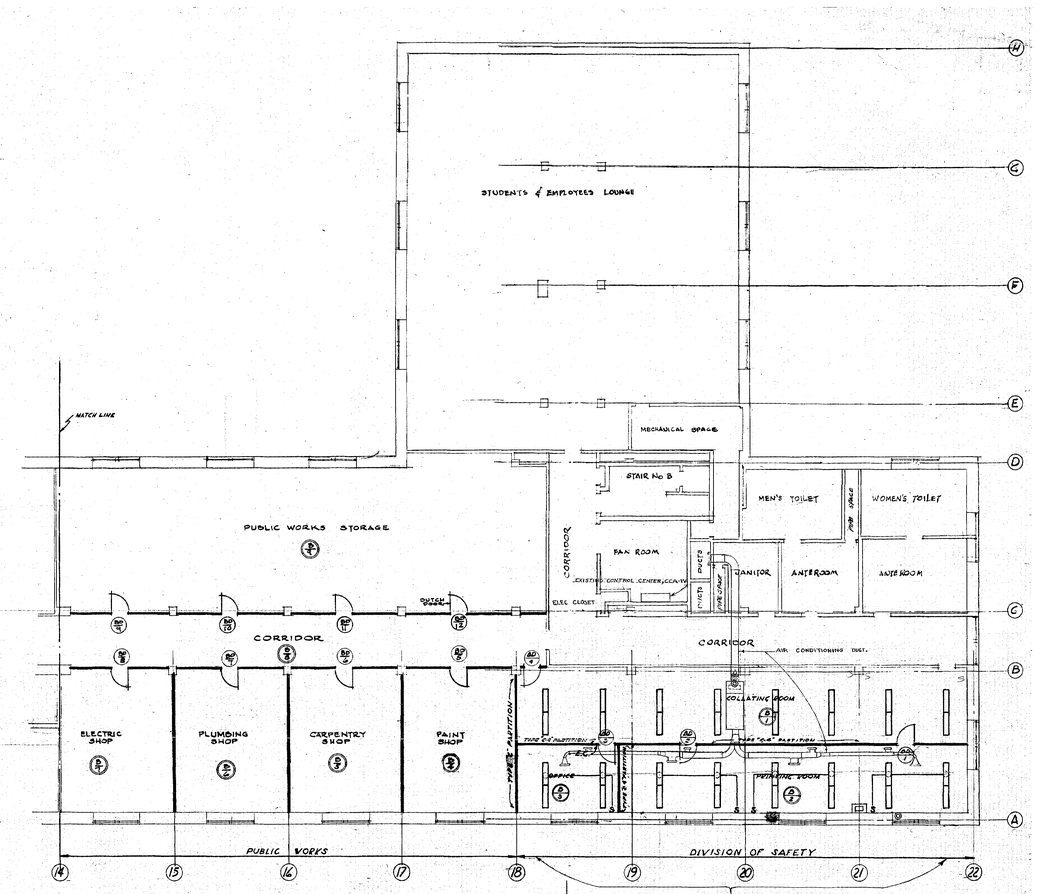

FOR SYMBOLS AND NOTES, SEE DEPT. OF COMMERCE BLDG. DWG. #57/4011

REVISIONS

MARK	DATE	DESCRIPTION
	8/26/13	BID DOCUMENTS

DEPARTMENT OF CIVIL SERVICE
STATE OFFICE BUILDING
CAMPUS SITE ALBANY NEW YORK

DRAWN BY	ELECTRIC	PROJECT NO. 12978
TRACED BY V.C.V.	ELECTRIC CHANGES AND ADDITIONS TO CONFORM WITH OFFICE PARTITIONING	SPECIFICATION NO. 18884
CHECKED BY N.A.	BASEMENT FLOOR PLAN	DATE
CROSS CHECKED BY N.A.		SCALE 1/8" = 1'-0"
FIELD CHECK BY ARCH'T		DRAWING NO. 57/4014
APPROVED BY ENG.	STATE OF NEW YORK DEPARTMENT OF PUBLIC WORKS DIVISION OF ARCHITECTURE CARL W. LARSON STATE ARCHITECT	
APPROVED BY DATE	BLDG. # 1	

SCANNED 2005 #1

NOTE: DRAWING NOT TO SCALE

NYS OFFICE OF GENERAL SERVICES
Serving New York
ANDREW M. CUOMO
Governor
ROANN M. DESTITO
Commissioner

CONSULTANT

WARNING:
THE ALTERATION OF THIS MATERIAL IN ANY WAY, UNLESS DONE UNDER THE DIRECTION OF A COMPARABLE PROFESSIONAL, I.E. ARCHITECT FOR AN ARCHITECT, ENGINEER FOR AN ENGINEER OR LANDSCAPE ARCHITECT FOR A LANDSCAPE ARCHITECT, IS A VIOLATION OF THE NEW YORK STATE EDUCATION LAW AND/OR REGULATIONS AND IS A CLASS 'A' MISDEMEANOR.

CONTRACT:
CONSTRUCTION

TITLE:
DEMOLISH BUILDING
NOS. 1 & 1A

LOCATION:
STATE OFFICE BUILDING CAMPUS
1220 WASHINGTON AVENUE
ALBANY, N.Y. 12226

CLIENT:
NEW YORK STATE
OFFICE OF GENERAL SERVICES

PROJECT NUMBER: 44845 – C
DESIGNED BY:
DRAWN BY:
FIELD CHECK:
APPROVED:

SHEET TITLE:
EXIST. ELECTRICAL REF. DWG.
BASEMENT FLOOR PLAN
ELEC. CHANGES & ADDITIONS

DRAWING NUMBER:
54–4014

SHEET OF

Sep 12,2013 10:25am
v:\Designs\Consst\g44845\CadSrc\ELEC\57-4014.dwg
36x24 PLOT SHEET

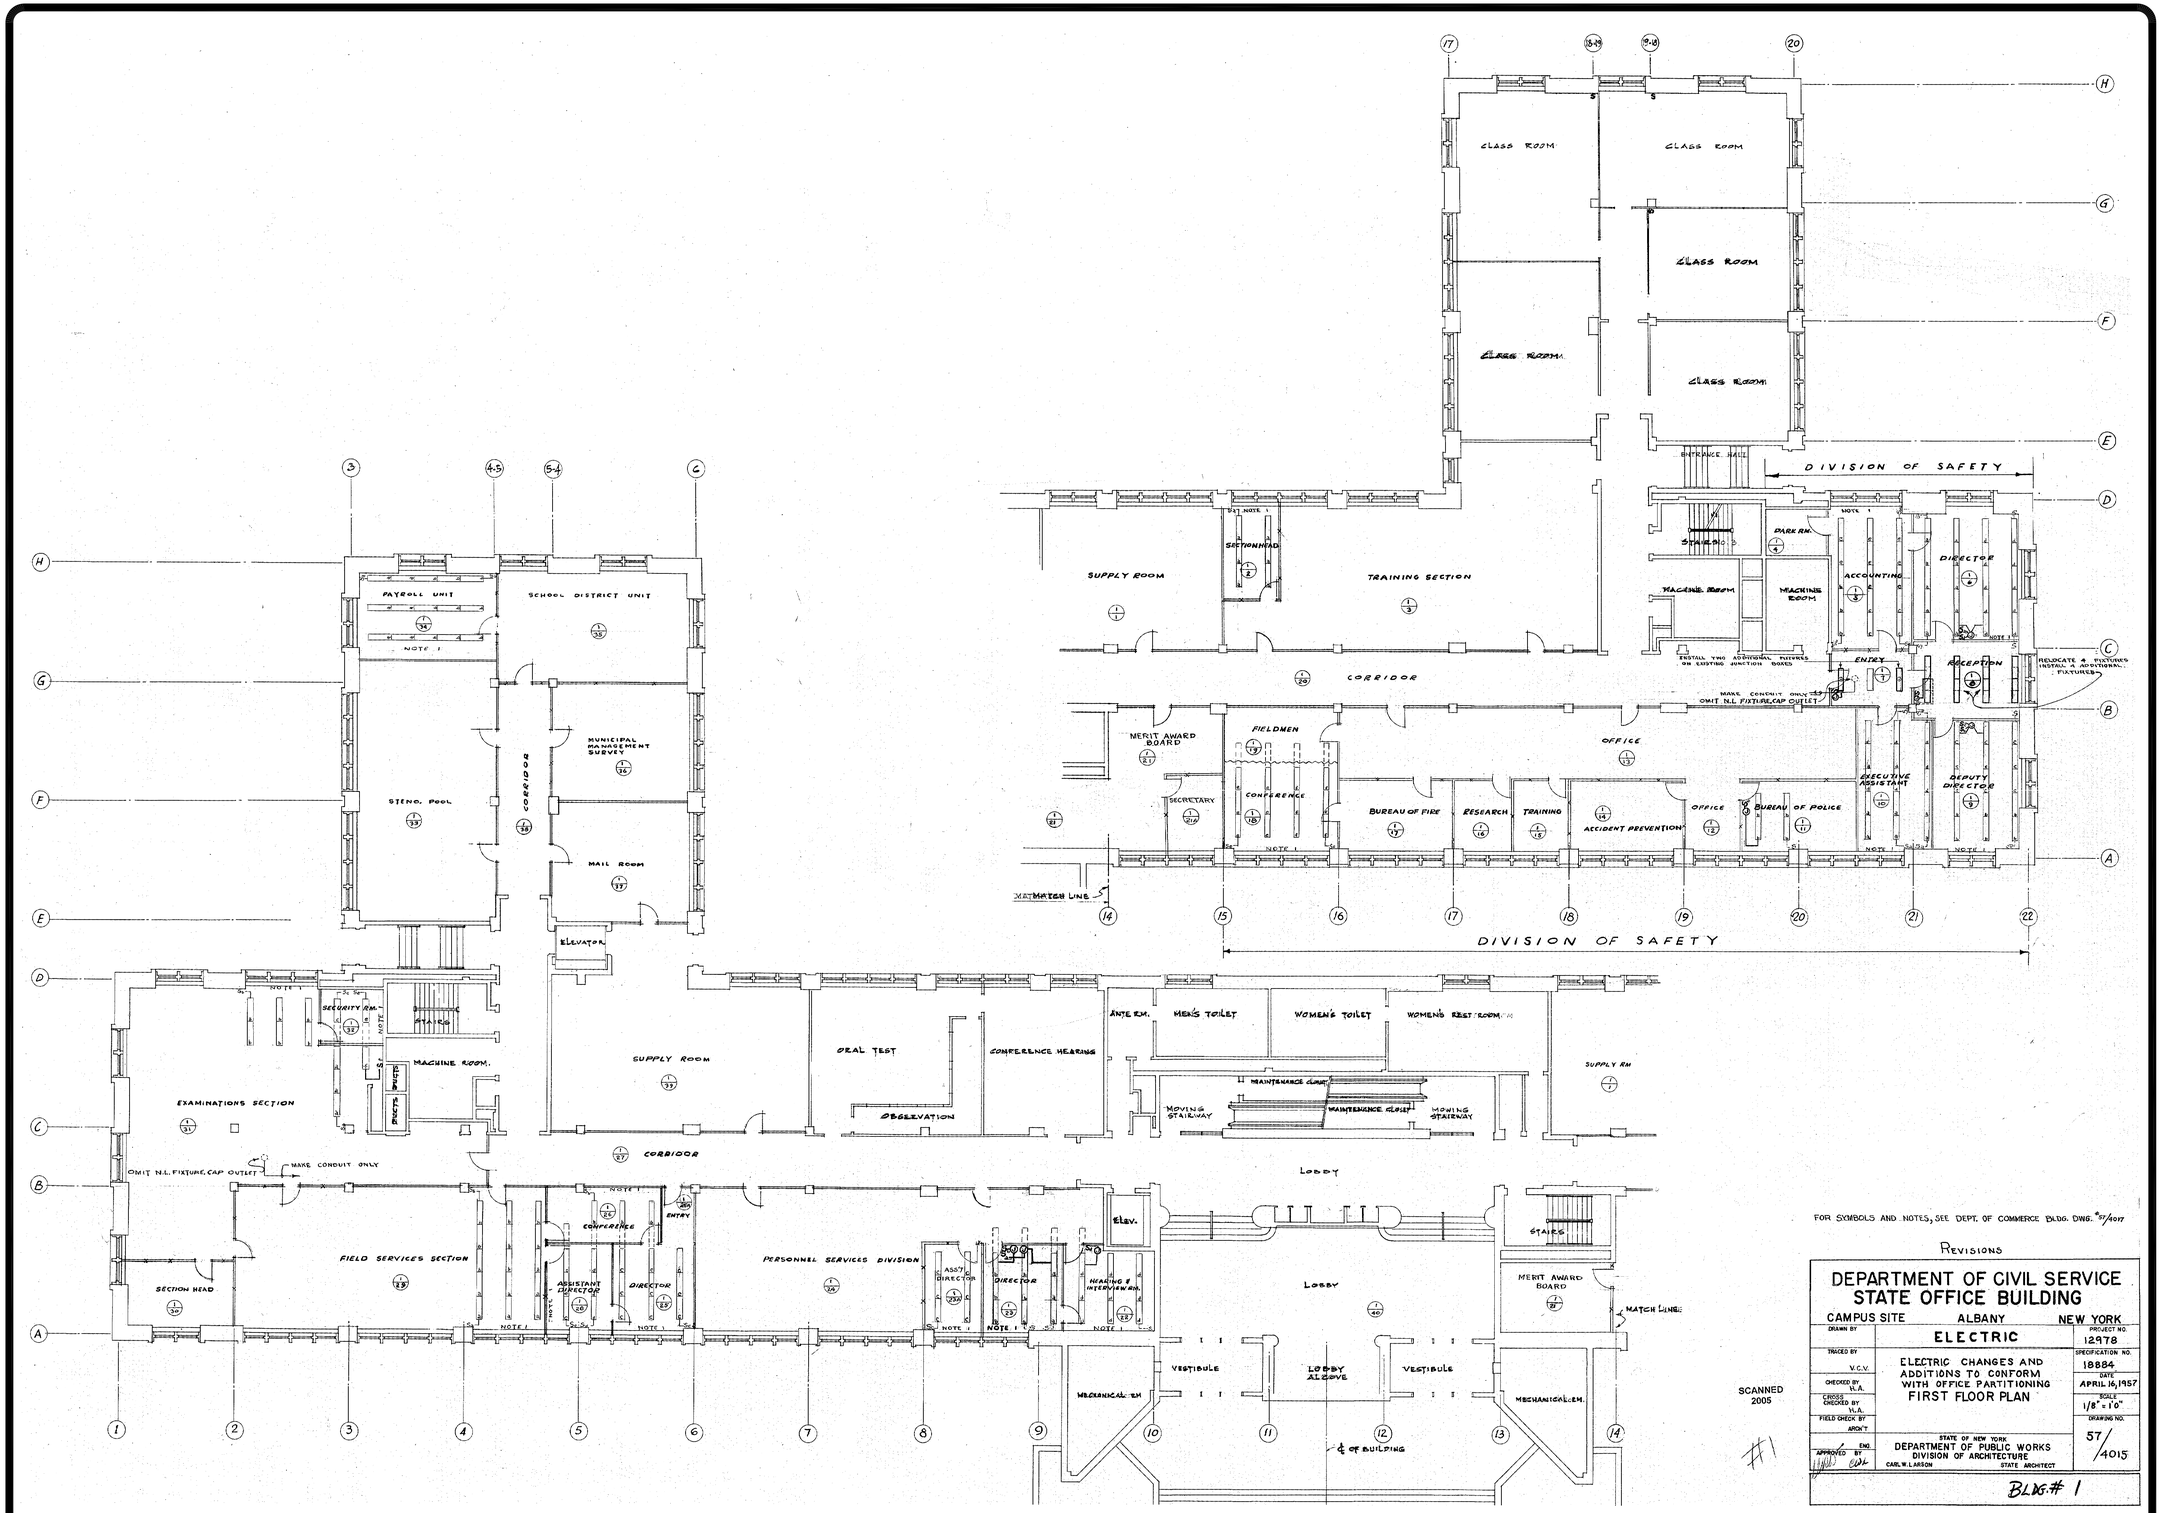

FOR SYMBOLS AND NOTES, SEE DEPT. OF COMMERCE BLDG. DWG. #57/4017

REVISIONS

	8/26/13	BID DOCUMENTS
MARK	DATE	DESCRIPTION

DEPARTMENT OF CIVIL SERVICE STATE OFFICE BUILDING

CAMPUS SITE — ALBANY — NEW YORK

DRAWN BY	ELECTRIC	PROJECT NO. 12978
TRACED BY V.C.V.	ELECTRIC CHANGES AND ADDITIONS TO CONFORM WITH OFFICE PARTITIONING FIRST FLOOR PLAN	SPECIFICATION NO. 18884
CHECKED BY V.L.A.		DATE APRIL 16, 1957
CROSS CHECKED BY V.L.A.		SCALE 1/8" = 1'0"
FIELD CHECK BY		DRAWING NO. 57/4015
ARCH'T	STATE OF NEW YORK DEPARTMENT OF PUBLIC WORKS DIVISION OF ARCHITECTURE	
APPROVED BY ENG.	CARL W. LARSON STATE ARCHITECT	

BLDG. # 1

SCANNED 2005

#1

NOTE: DRAWING NOT TO SCALE

NYS OFFICE OF GENERAL SERVICES

Serving New York

ANDREW M. CUOMO
Governor
ROANN M. DESTITO
Commissioner

CONSULTANT

WARNING:

THE ALTERATION OF THIS MATERIAL IN ANY WAY, UNLESS DONE UNDER THE DIRECTION OF A COMPARABLE PROFESSIONAL, I.E. ARCHITECT FOR AN ARCHITECT, ENGINEER FOR AN ENGINEER OR LANDSCAPE ARCHITECT FOR A LANDSCAPE ARCHITECT, IS A VIOLATION OF THE NEW YORK STATE EDUCATION LAW AND/OR REGULATIONS AND IS A CLASS 'A' MISDEMEANOR.

CONTRACT:

CONSTRUCTION

TITLE:

DEMOLISH BUILDING
NOS. 1 & 1A

LOCATION:

STATE OFFICE BUILDING CAMPUS
1220 WASHINGTON AVENUE
ALBANY, N.Y. 12226

CLIENT:

NEW YORK STATE
OFFICE OF GENERAL SERVICES

PROJECT NUMBER: 44845 – C

DESIGNED BY:

DRAWN BY:

FIELD CHECK:

APPROVED:

SHEET TITLE:

EXIST. ELECTRICAL REF. DWG.
FIRST FLOOR PLAN
ELEC. CHANGES & ADDITIONS

DRAWING NUMBER:

57–4015

SHEET OF

Sep 12,2013 – 10:25am
V:\Designed\Const\(p44845\44845\CadStrc\ELEC\57-4015.dwg

36x24 PLOT SHEET

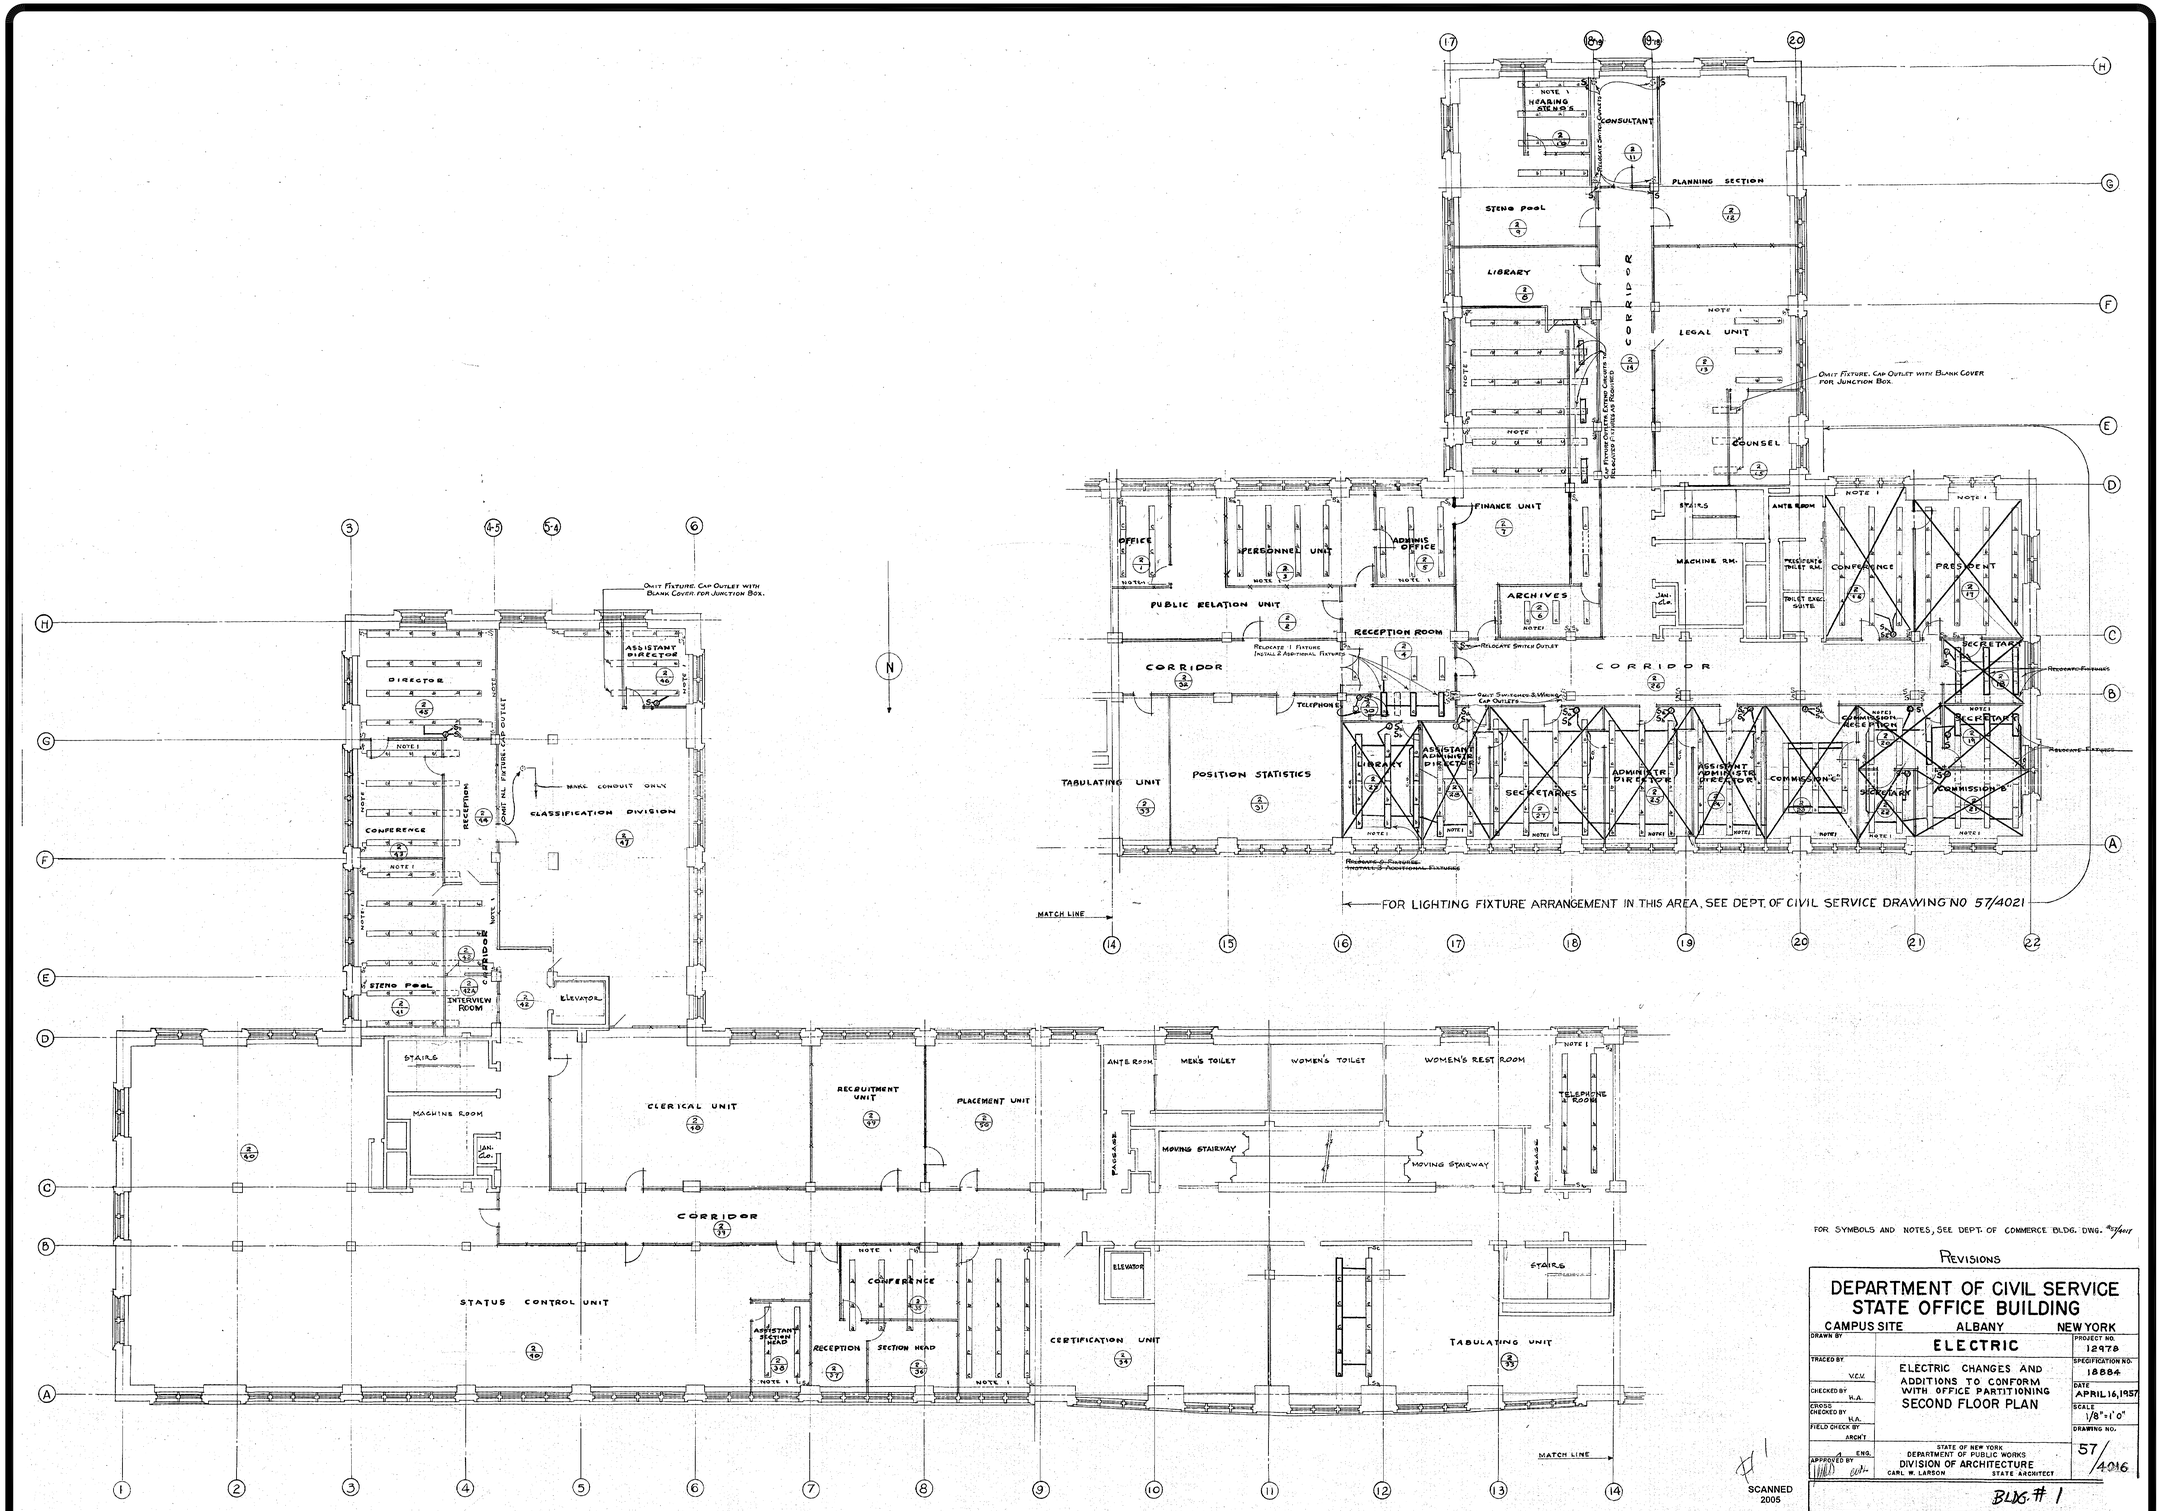

FOR SYMBOLS AND NOTES, SEE DEPT. OF COMMERCE BLDG. DWG. #57/4017

REVISIONS

DEPARTMENT OF CIVIL SERVICE
STATE OFFICE BUILDING
CAMPUS SITE ALBANY NEW YORK

DRAWN BY	ELECTRIC	PROJECT NO. 12978
TRACED BY V.C.V.	ELECTRIC CHANGES AND ADDITIONS TO CONFORM WITH OFFICE PARTITIONING SECOND FLOOR PLAN	SPECIFICATION NO. 18884
CHECKED BY H.A.		DATE APRIL 16, 1957
CROSS CHECKED BY H.A.		SCALE 1/8" = 1'0"
FIELD CHECK BY ARCH'T		DRAWING NO. 57/4016
APPROVED BY ENG.	STATE OF NEW YORK DEPARTMENT OF PUBLIC WORKS DIVISION OF ARCHITECTURE CARL W. LARSON STATE ARCHITECT	

BLDG. # 1

SCANNED 2005

NOTE: DRAWING NOT TO SCALE

NYS OFFICE OF GENERAL SERVICES
Serving New York
ANDREW M. CUOMO
Governor
ROANN M. DESTITO
Commissioner

CONSULTANT

WARNING:
THE ALTERATION OF THIS MATERIAL IN ANY WAY, UNLESS DONE UNDER THE DIRECTION OF A COMPARABLE PROFESSIONAL, I.E. ARCHITECT FOR AN ARCHITECT, ENGINEER FOR AN ENGINEER OR LANDSCAPE ARCHITECT FOR A LANDSCAPE ARCHITECT, IS A VIOLATION OF THE NEW YORK STATE EDUCATION LAW AND/OR REGULATIONS AND IS A CLASS 'A' MISDEMEANOR.

CONTRACT:
CONSTRUCTION

TITLE:
DEMOLISH BUILDING
NOS. 1 & 1A

LOCATION:
STATE OFFICE BUILDING CAMPUS
1220 WASHINGTON AVENUE
ALBANY, N.Y. 12226

CLIENT:
NEW YORK STATE
OFFICE OF GENERAL SERVICES

MARK	DATE	DESCRIPTION
	8/26/13	BID DOCUMENTS

PROJECT NUMBER:	44845 – C
DESIGNED BY:	
DRAWN BY:	
FIELD CHECK:	
APPROVED:	

SHEET TITLE:
EXIST. ELECTRICAL REF. DWG.
SECOND FLOOR PLAN
ELEC. CHANGES & ADDITIONS

DRAWING NUMBER:
57–4016

SHEET OF

Sep 12,2013 – 10:24am
V:\DesignAndConstr\p448xx\44845\CadStru\ELEC\57-4016.dwg
36x24 PLOT SHEET

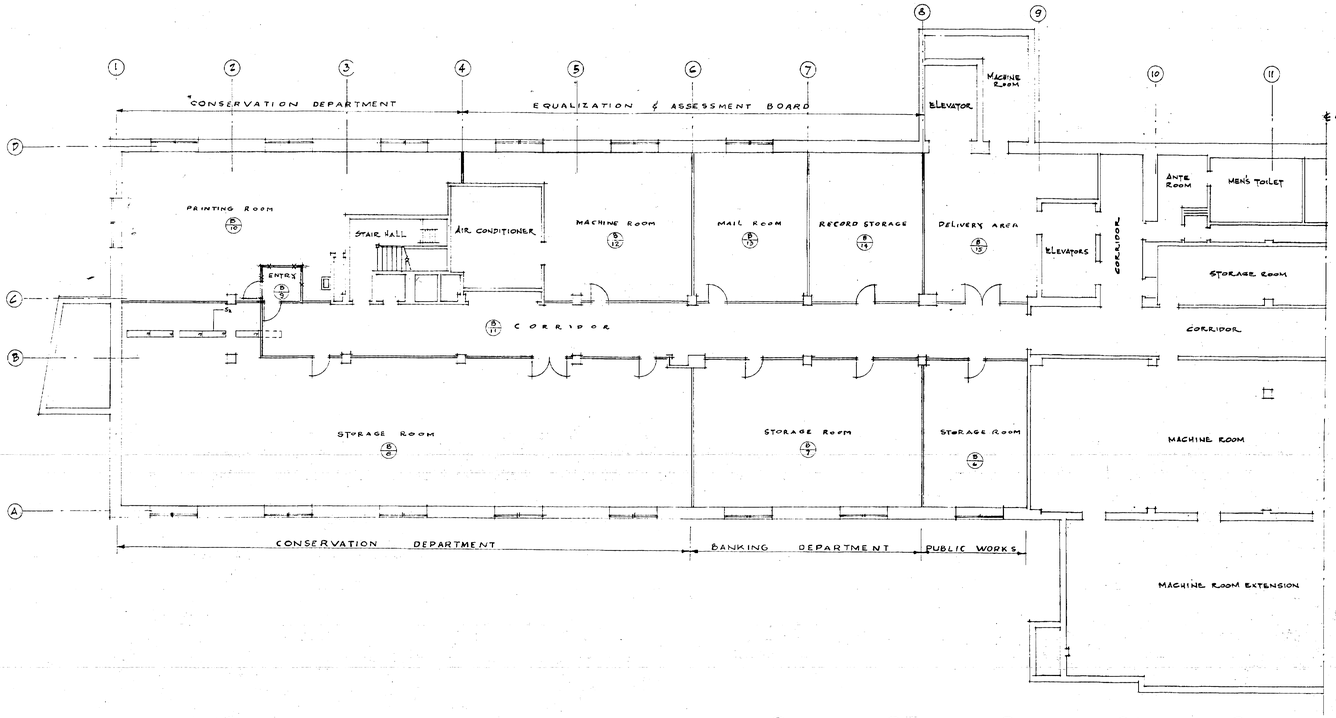

NOTES

1. EXTRA WORK IN THIS CONTRACT TO INCLUDE RELOCATING CERTAIN LIGHTING FIXTURES AS SHOWN AND THE FURNISHING AND INSTALLING OF ADDITIONAL LIGHTING FIXTURES, JUNCTION BOXES AND SWITCHES WITH CIRCUIT EXTENSIONS TO THESE FACILITIES. RECONNECT LIGHTING FIXTURES FOR SWITCHING AS SHOWN.
2. STEEL PARTITIONS WITH OUTLET BOX OPENINGS WILL BE FURNISHED AND INSTALLED BY OTHERS. ELECTRIC CONTRACTOR SHALL FURNISH AND INSTALL SWITCH BOXES, SWITCHES AND CIRCUIT CONNECTIONS THERETO IN STEEL PARTITIONS AFTER THEIR ERECTION.
3. WORK NOT CHANGED BY THESE DRAWINGS SHALL BE INSTALLED AS PER BASE CONTRACT.
4. ADDITIONAL JUNCTION BOXES FOR SWITCH LEGS TO METAL PARTITIONS SHALL BE MOUNTED FLUSH WITH FINISHED CEILING ADJACENT TO METAL PARTITIONS. JUNCTION BOXES SHALL HAVE BLANK COVERS.
5. LOCAL SWITCHES INSTALLED IN METAL PARTITIONS SHALL BE P.E.S. NO. 1814313 OR EQUAL. WIRING WITHIN METAL PARTITIONS SHALL BE DONE WITH FLEXIBLE ARMORED CABLE (BX)
6. HOMERUNS SHALL BE RELOCATED AS REQUIRED.

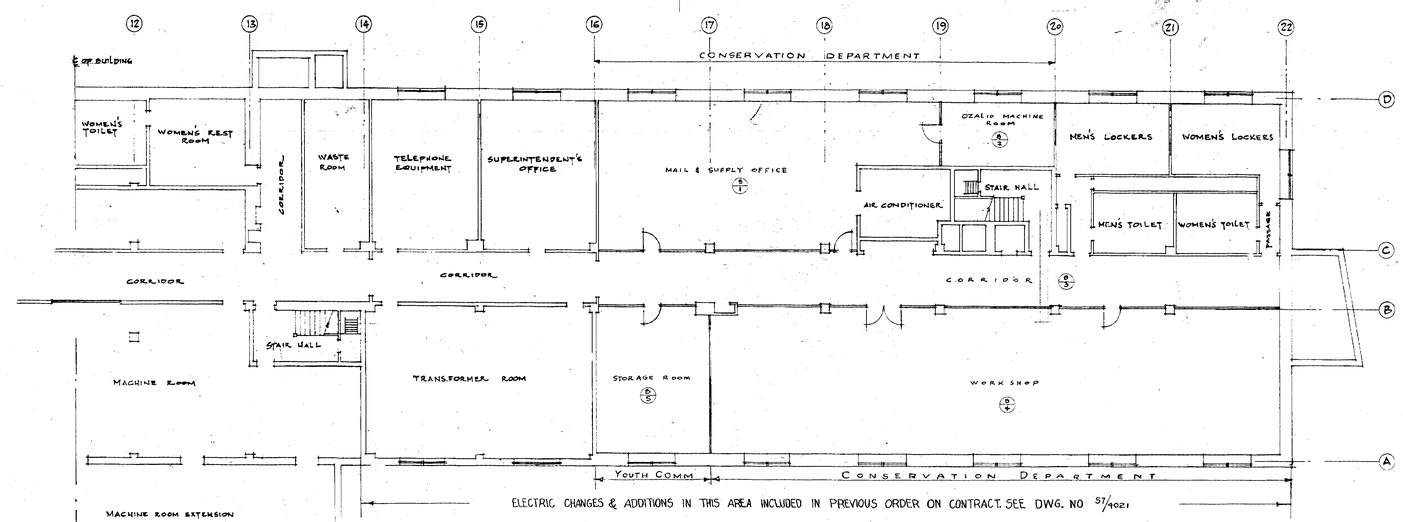

REVISIONS

SYMBOLS

- ADDITIONAL OR RELOCATED FACILITIES IN THIS CONTRACT
- FACILITIES INCLUDED IN BASE CONTRACT OR PREVIOUS ORDERS TO REMAIN
- FACILITIES TO BE OMITTED OR RELOCATED
- MOVEABLE METAL PARTITIONS BY OTHERS-CEILING HEIGHT
- MOVEABLE METAL PARTITIONS BY OTHERS- LESS THAN CEILING HEIGHT

SCANNED 2005

DEPARTMENT OF COMMERCE STATE OFFICE BUILDING CAMPUS SITE ALBANY NEW YORK		
DRAWN BY	ELECTRIC	PROJECT NO. 1-478
TRACED BY V.G.V.	ELECTRIC CHANGES AND ADDITIONS TO CONFORM WITH OFFICE PARTITIONING	SPECIFICATION NO. 18884
CHECKED BY H.A.	BASEMENT FLOOR PLAN	DATE APRIL 16, 1957
CROSS CHECKED BY H.A.		SCALE 1/8"=1'0"
FIELD CHECKED BY ARCH'T		DRAWING NO. 57/4017
APPROVED BY CHG	STATE OF NEW YORK DEPARTMENT OF PUBLIC WORKS DIVISION OF ARCHITECTURE CARL W. LARSON STATE ARCHITECT	

NOTE: DRAWING NOT TO SCALE

NYS OFFICE OF GENERAL SERVICES

Serving New York

ANDREW M. CUOMO
Governor
ROANN M. DESTITO
Commissioner

CONSULTANT

WARNING:
THE ALTERATION OF THIS MATERIAL IN ANY WAY, UNLESS DONE UNDER THE DIRECTION OF A COMPARABLE PROFESSIONAL, I.E. ARCHITECT FOR AN ARCHITECT, ENGINEER FOR AN ENGINEER OR LANDSCAPE ARCHITECT FOR A LANDSCAPE ARCHITECT, IS A VIOLATION OF THE NEW YORK STATE EDUCATION LAW AND/OR REGULATIONS AND IS A CLASS 'A' MISDEMEANOR.

CONTRACT:
CONSTRUCTION

TITLE:
DEMOLISH BUILDING
NOS. 1 & 1A

LOCATION:
STATE OFFICE BUILDING CAMPUS
1220 WASHINGTON AVENUE
ALBANY, N.Y. 12226

CLIENT:
NEW YORK STATE
OFFICE OF GENERAL SERVICES

MARK	DATE	DESCRIPTION
	8/26/13	BID DOCUMENTS

PROJECT NUMBER: 44845 – C

DESIGNED BY:
DRAWN BY:
FIELD CHECK:
APPROVED:

SHEET TITLE:
EXIST. ELECTRICAL REF. DWG.
BASEMENT FLOOR PLAN
ELEC. CHANGES & ADDITIONS

DRAWING NUMBER:
57–4017

SHEET OF

Sep 12,2013 – 10:24am
v:\Designed\Const\p44845\CadStru\ELEC\57-4017.dwg
36x24 PLOT SHEET

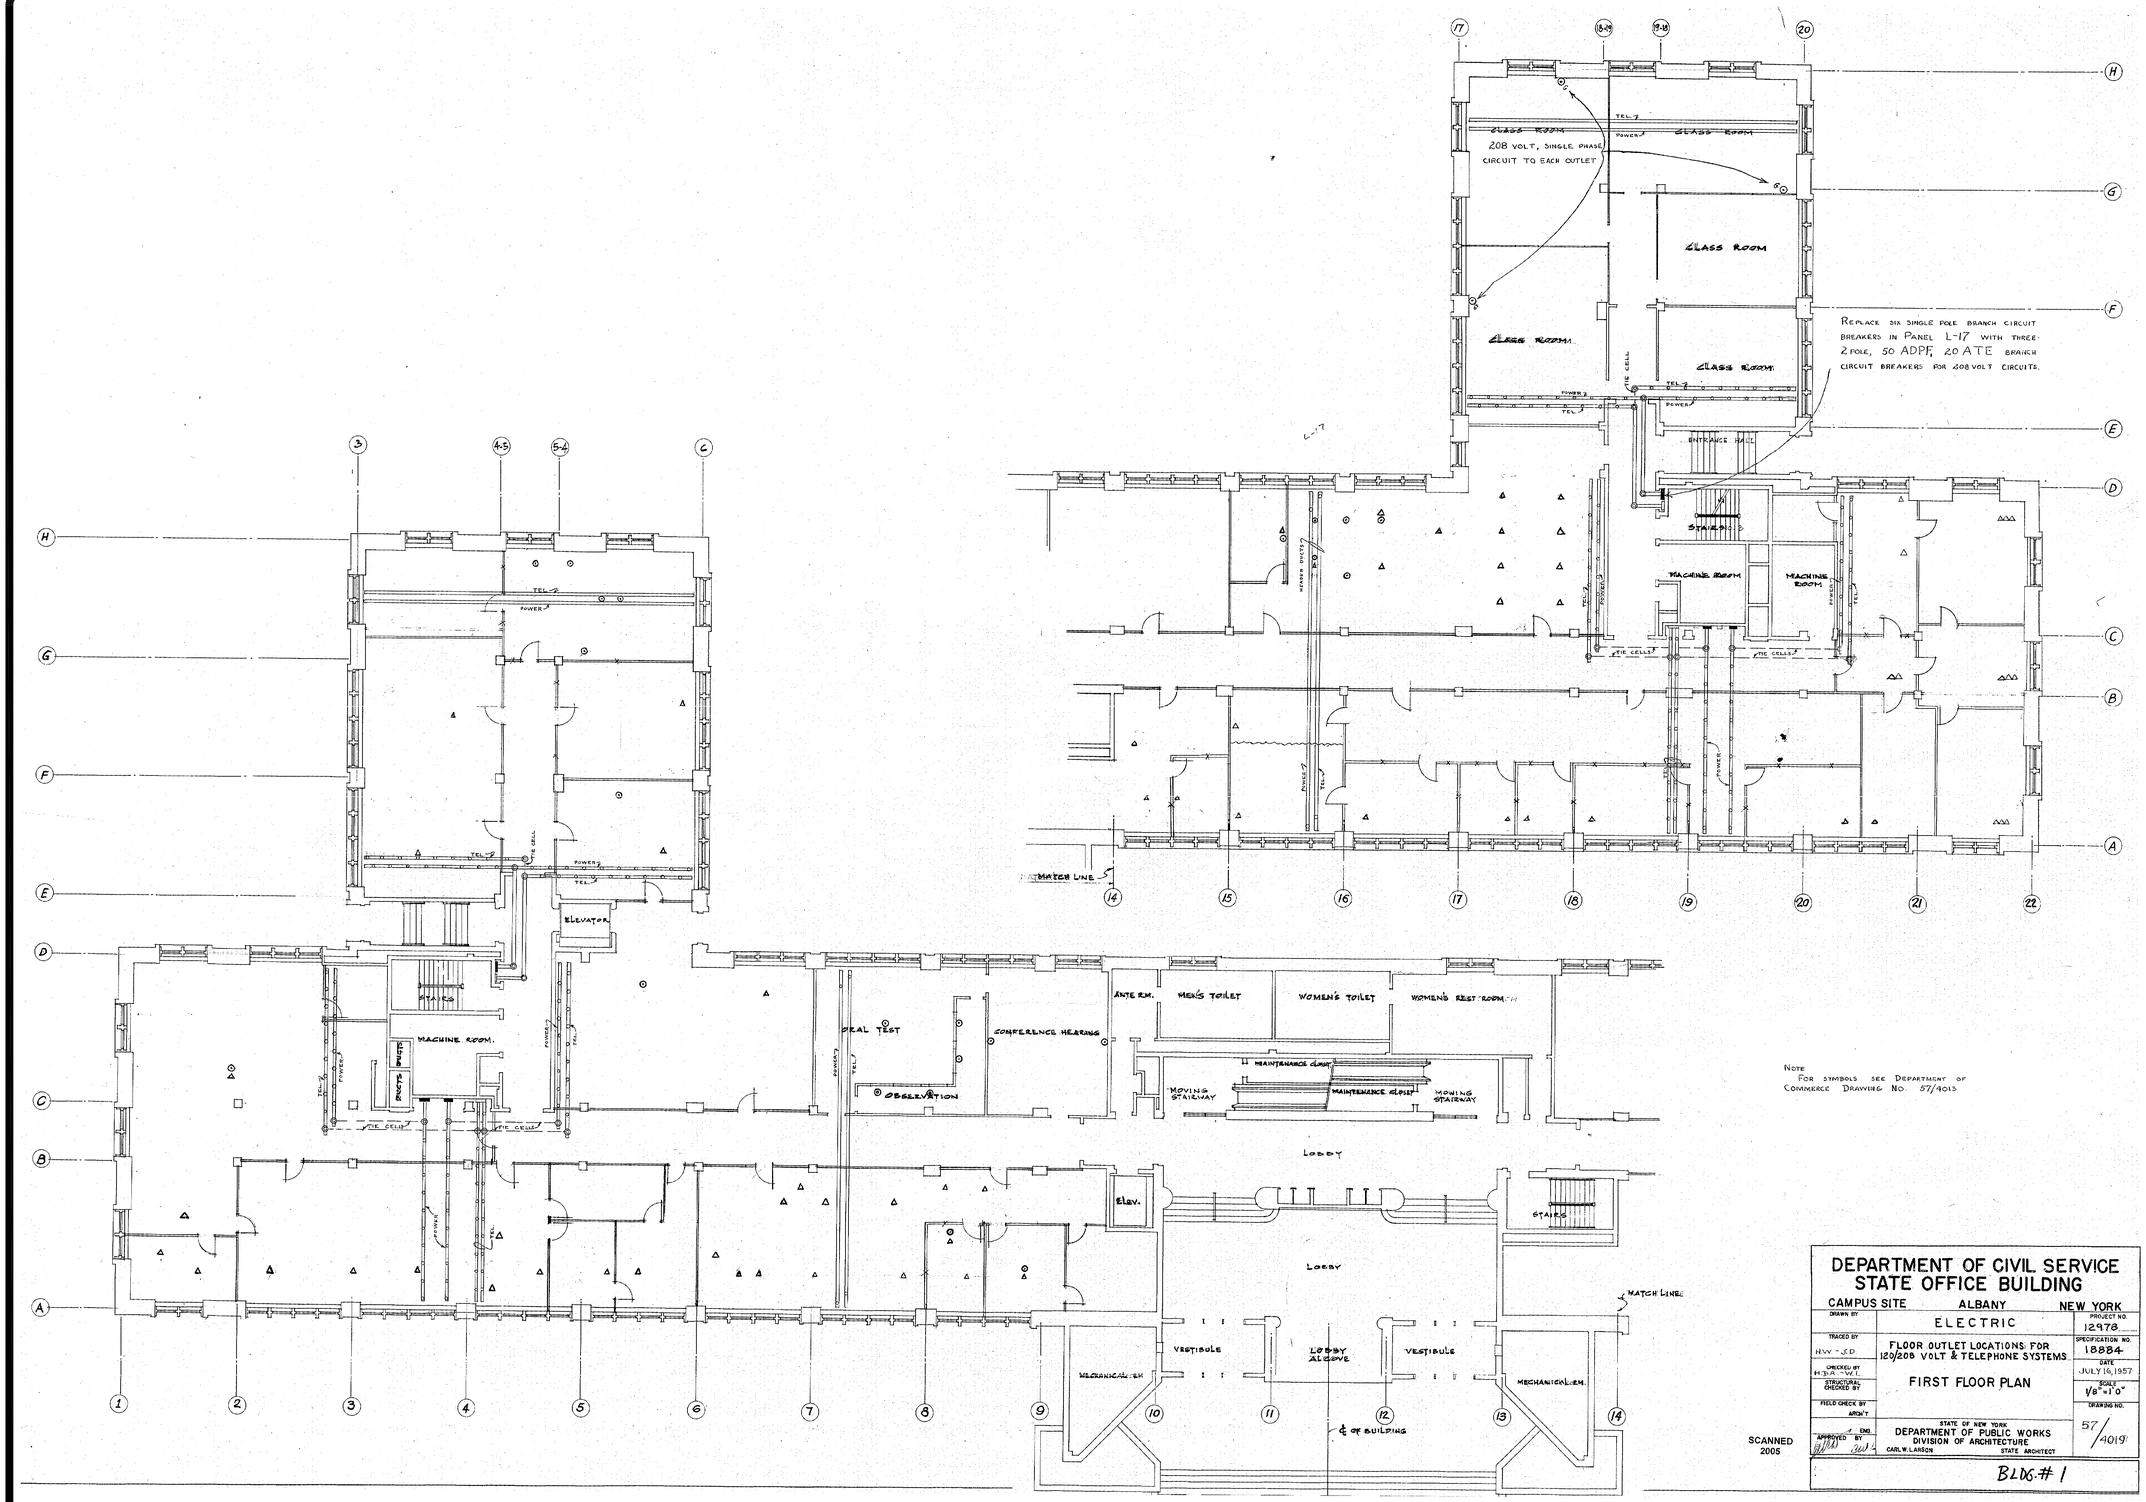

NOTE
FOR SYMBOLS SEE DEPARTMENT OF COMMERCE DRAWING NO. 57/4013

SCANNED 2005

DEPARTMENT OF CIVIL SERVICE
STATE OFFICE BUILDING
CAMPUS SITE ALBANY NEW YORK

DRAWN BY	ELECTRIC	PROJECT NO. 12978
TRACED BY H.W.-J.D.	FLOOR OUTLET LOCATIONS FOR 120/208 VOLT & TELEPHONE SYSTEMS	SPECIFICATION NO. 18884
CHECKED BY H.B.A.-W.L.	FIRST FLOOR PLAN	DATE JULY 16, 1957
STRUCTURAL CHECKED BY		SCALE 1/8"=1'0"
FIELD CHECK BY ARCH'T		DRAWING NO. 57/4019
APPROVED BY END	STATE OF NEW YORK DEPARTMENT OF PUBLIC WORKS DIVISION OF ARCHITECTURE CARL W. LARSON STATE ARCHITECT	

BLDG. # 1

NOTE: DRAWING NOT TO SCALE

NYS OFFICE OF GENERAL SERVICES
Serving New York
ANDREW M. CUOMO
Governor
ROANN M. DESTITO
Commissioner

CONSULTANT

WARNING:
THE ALTERATION OF THIS MATERIAL IN ANY WAY, UNLESS DONE UNDER THE DIRECTION OF A COMPARABLE PROFESSIONAL, I.E. ARCHITECT FOR AN ARCHITECT, ENGINEER FOR AN ENGINEER OR LANDSCAPE ARCHITECT FOR A LANDSCAPE ARCHITECT, IS A VIOLATION OF THE NEW YORK STATE EDUCATION LAW AND/OR REGULATIONS AND IS A CLASS 'A' MISDEMEANOR.

CONTRACT:
CONSTRUCTION

TITLE:
DEMOLISH BUILDING
NOS. 1 & 1A

LOCATION:
STATE OFFICE BUILDING CAMPUS
1220 WASHINGTON AVENUE
ALBANY, N.Y. 12226

CLIENT:
NEW YORK STATE
OFFICE OF GENERAL SERVICES

MARK	DATE	DESCRIPTION
	8/26/13	BID DOCUMENTS

PROJECT NUMBER: 44845 – C
DESIGNED BY:
DRAWN BY:
FIELD CHECK:
APPROVED:

SHEET TITLE:
EXIST. ELECTRICAL REF. DWG.
FIRST FLOOR PLAN
120/208 VOLT & TELE. OUTLETS

DRAWING NUMBER:
57–4019

SHEET OF

Sep 12,2013 - 10:23am
V:\DesignAndConstr\p448xx\44845\CadStru\ELEC\57-4019.dwg
36x24 PLOT SHEET

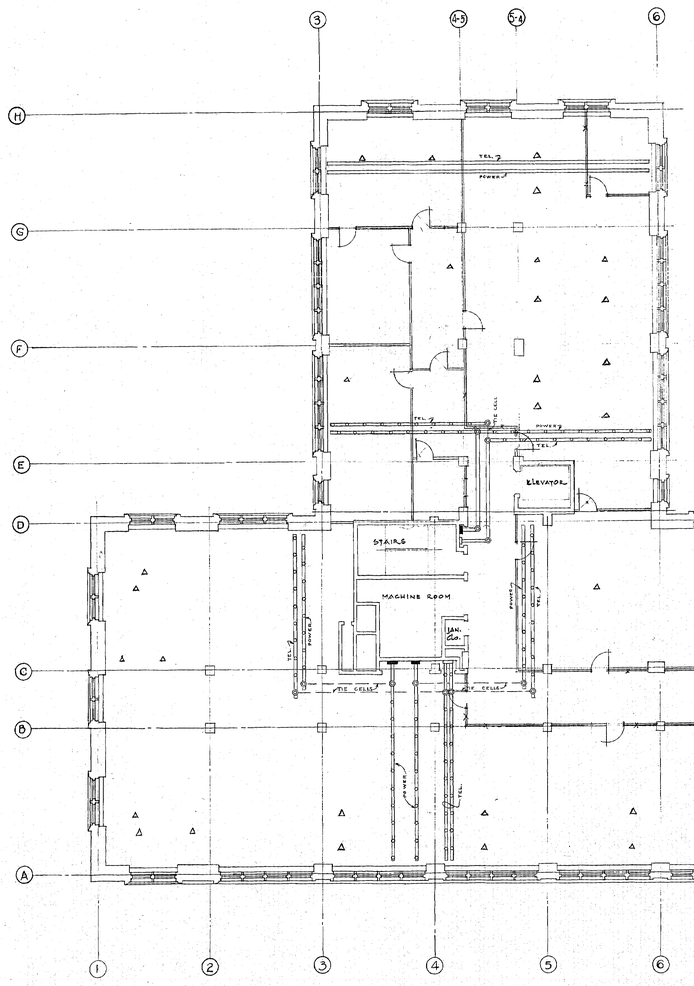

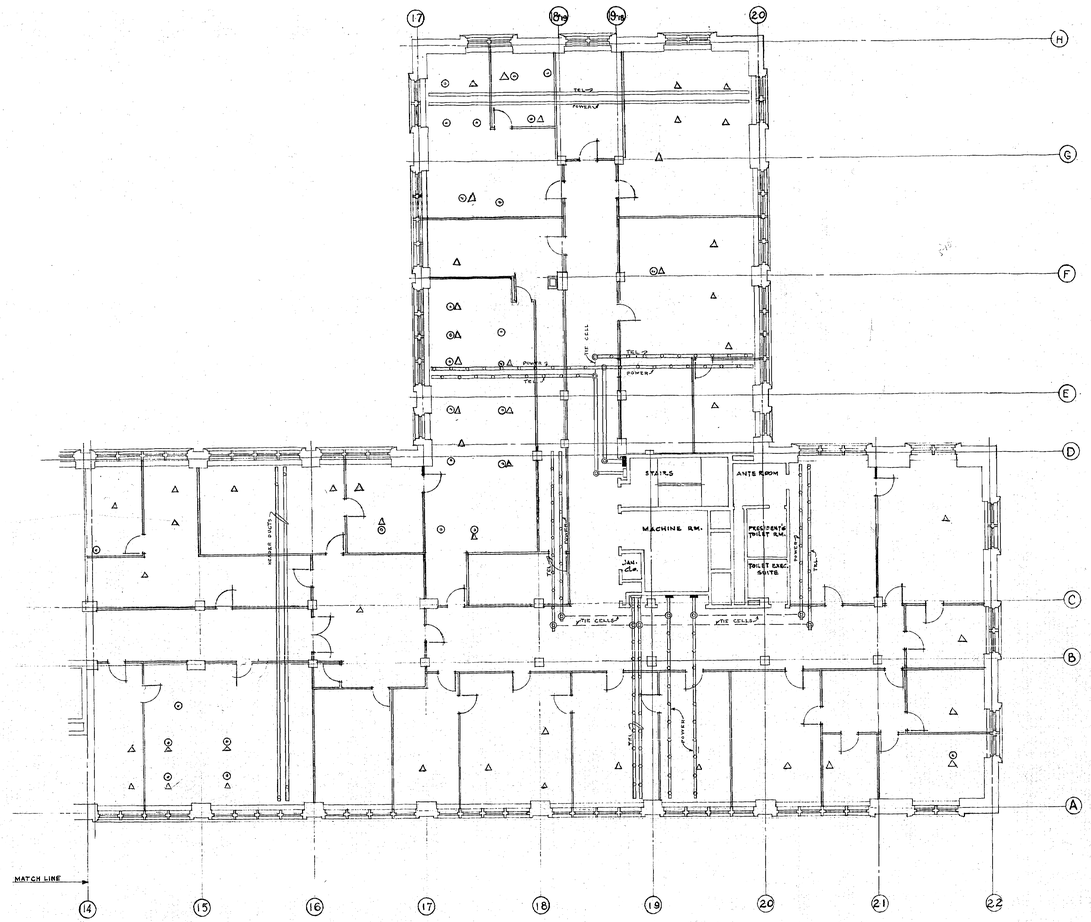

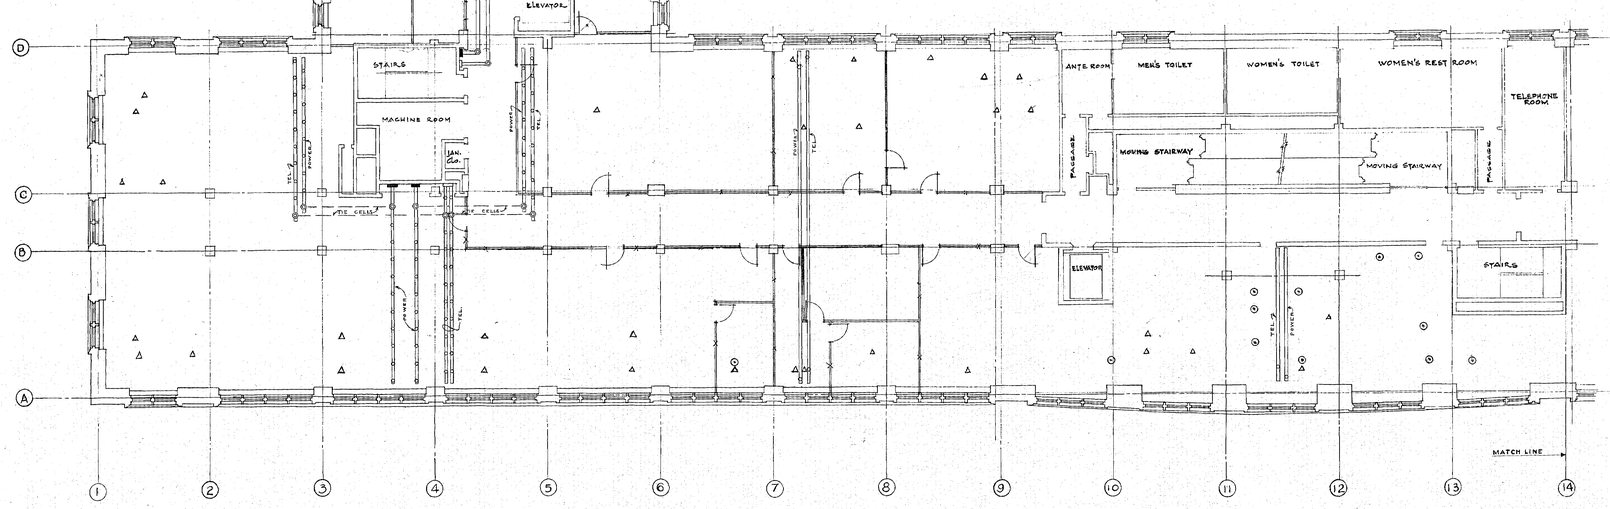

NOTE
FOR SYMBOLS SEE DEPARTMENT OF COMMERCE DRAWING NO. 57/4013

SCANNED 2005

DEPARTMENT OF CIVIL SERVICE STATE OFFICE BUILDING		
CAMPUS SITE	ALBANY	NEW YORK
DRAWN BY	ELECTRIC	PROJECT NO. 12978
TRACED BY HW-JD	FLOOR OUTLET LOCATIONS FOR 120/208 VOLT & TELEPHONE SYSTEMS	SPECIFICATION NO. 18884
CHECKED BY HSA-WL	SECOND FLOOR PLAN	DATE JULY 16, 1957
STRUCTURAL CHECKED BY		SCALE 1/8"=1'0"
FIELD CHECK BY JACK T.		DRAWING NO. 57/4020
APPROVED BY ENG.	STATE OF NEW YORK DEPARTMENT OF PUBLIC WORKS DIVISION OF ARCHITECTURE CARL W. LARSON STATE ARCHITECT	
BLDG # 1		

NOTE: DRAWING NOT TO SCALE

NYS OFFICE OF GENERAL SERVICES

Serving New York

ANDREW M. CUOMO
Governor
ROANN M. DESTITO
Commissioner

CONSULTANT

WARNING:
THE ALTERATION OF THIS MATERIAL IN ANY WAY, UNLESS DONE UNDER THE DIRECTION OF A COMPARABLE PROFESSIONAL, I.E. ARCHITECT FOR AN ARCHITECT, ENGINEER FOR AN ENGINEER OR LANDSCAPE ARCHITECT FOR A LANDSCAPE ARCHITECT, IS A VIOLATION OF THE NEW YORK STATE EDUCATION LAW AND/OR REGULATIONS AND IS A CLASS 'A' MISDEMEANOR.

CONTRACT:
CONSTRUCTION

TITLE:
DEMOLISH BUILDING
NOS. 1 & 1A

LOCATION:
STATE OFFICE BUILDING CAMPUS
1220 WASHINGTON AVENUE
ALBANY, N.Y. 12226

CLIENT:
NEW YORK STATE
OFFICE OF GENERAL SERVICES

MARK	DATE	DESCRIPTION
	8/26/13	BID DOCUMENTS

PROJECT NUMBER: 44845 – C

DESIGNED BY:
DRAWN BY:
FIELD CHECK:
APPROVED:

SHEET TITLE:
EXIST. ELECTRICAL REF. DWG.
SECOND FLOOR PLAN
120/208 VOLT & TELE. OUTLETS

DRAWING NUMBER:
57–4020

SHEET OF

Sep 12,2013 – 10:27am
W:\Designer\Constr\gs48ex\44845\CadStrc\ELEC\57-4020.dwg
36x24 PLOT SHEET

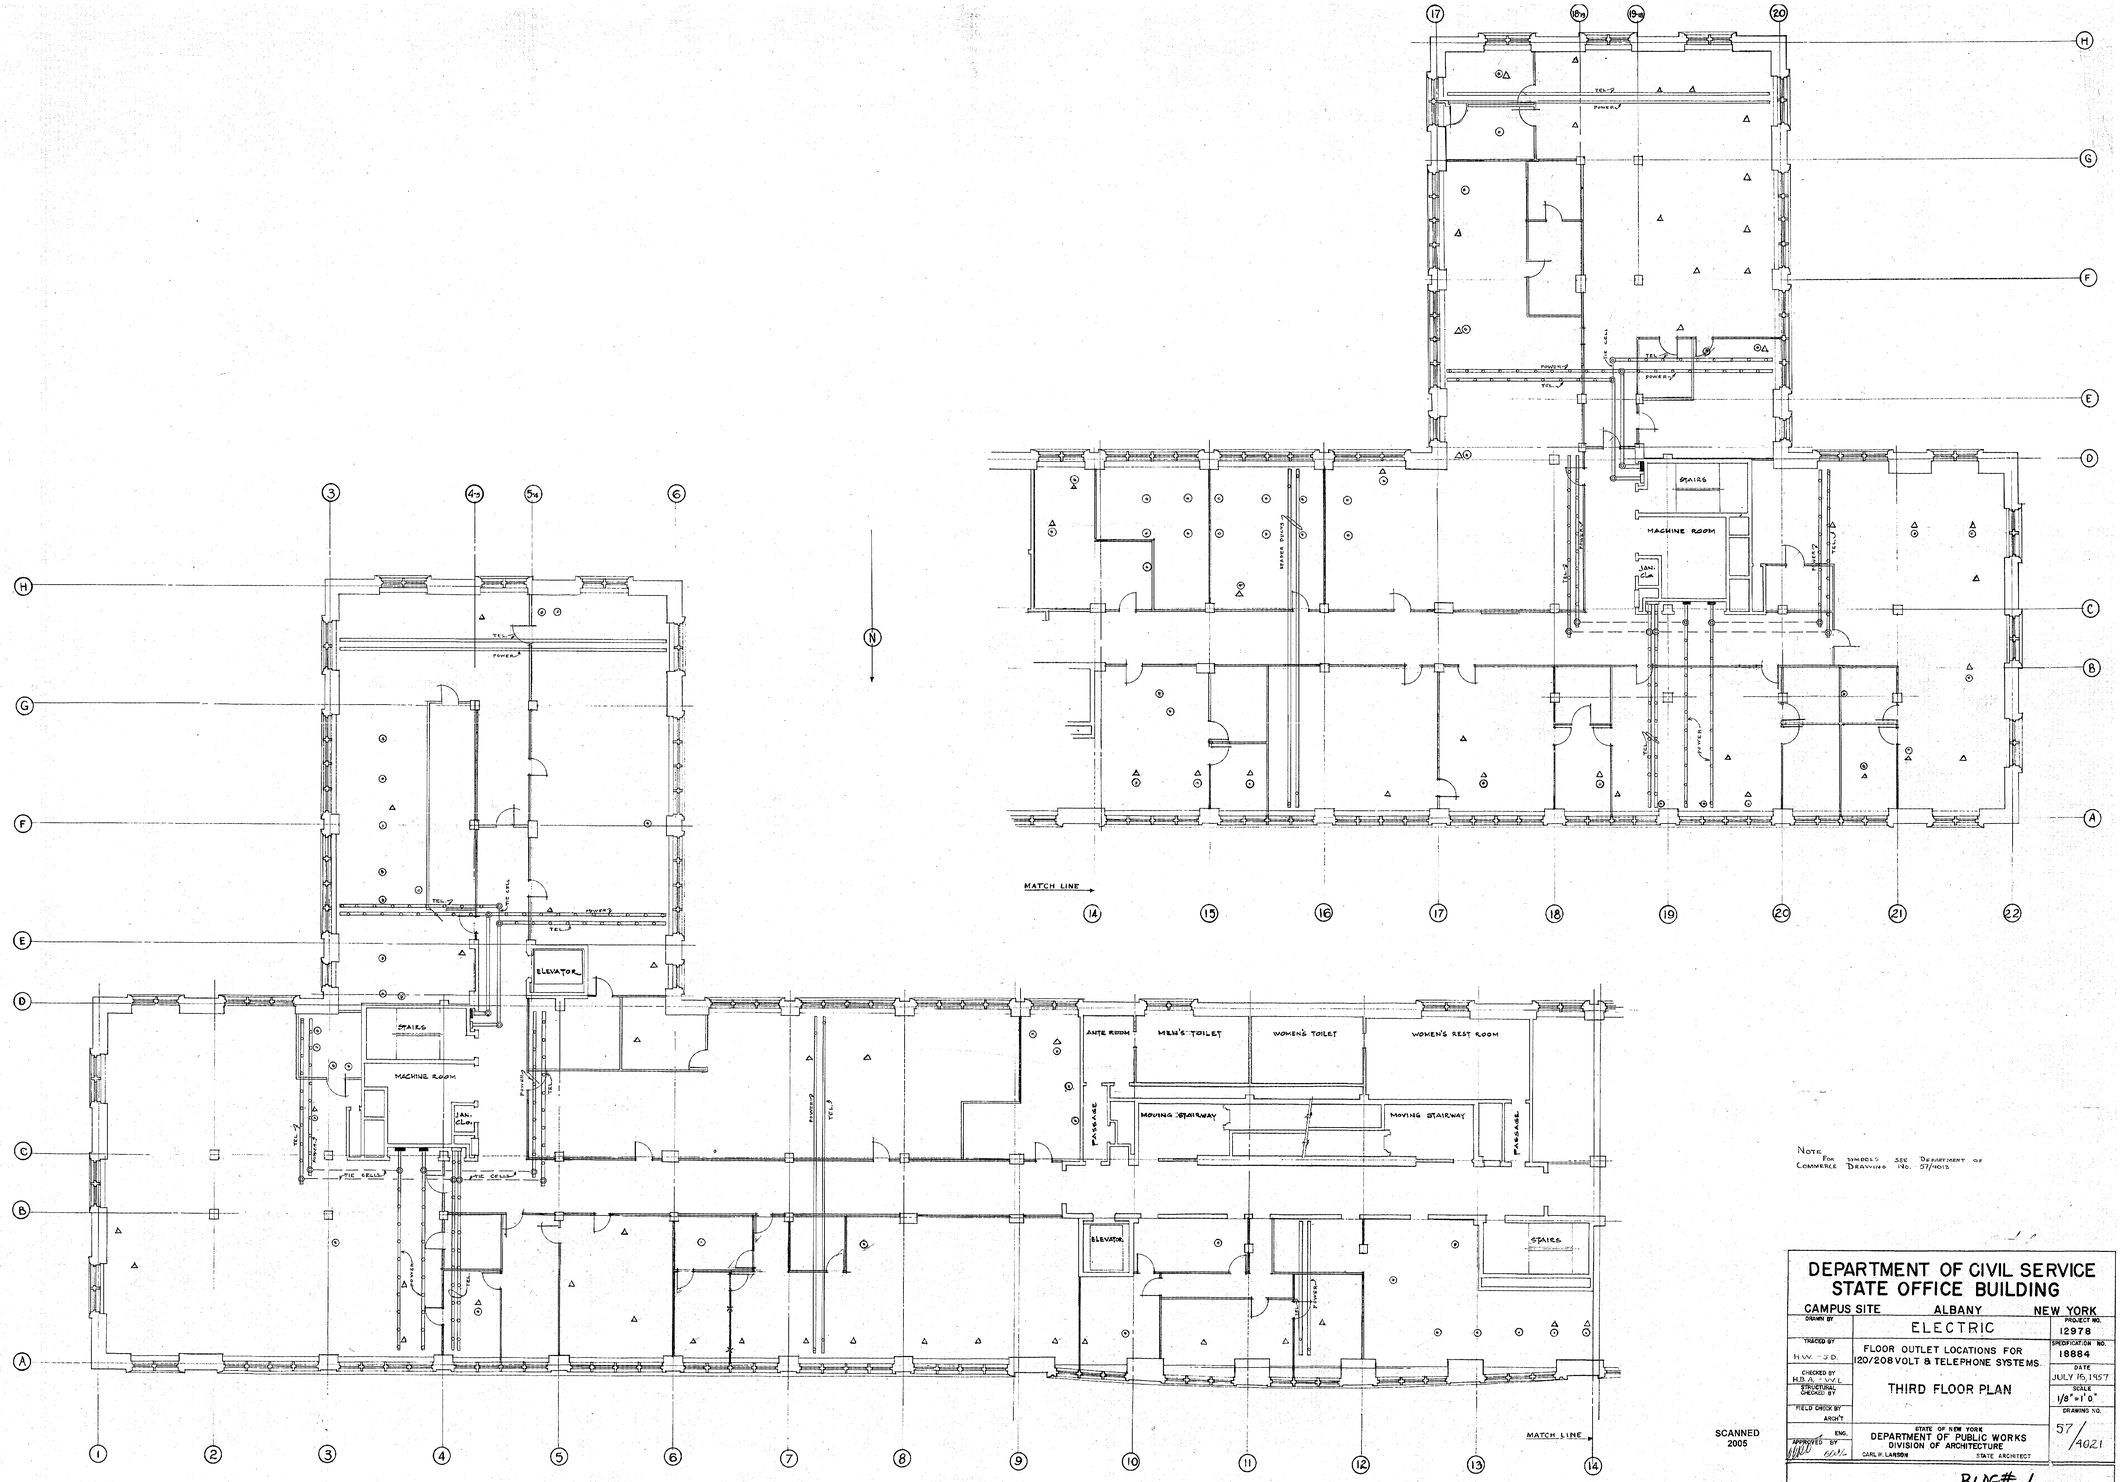

NOTE
FOR SYMBOLS SEE DEPARTMENT OF COMMERCE DRAWING NO. 57/4013

SCANNED 2005

DEPARTMENT OF CIVIL SERVICE
STATE OFFICE BUILDING

CAMPUS SITE ALBANY NEW YORK

DRAWN BY	ELECTRIC	PROJECT NO. 12978
TRACED BY H.W. - J.D.	FLOOR OUTLET LOCATIONS FOR 120/208 VOLT & TELEPHONE SYSTEMS.	SPECIFICATION NO. 18884
CHECKED BY R.B.A. - W.L.	THIRD FLOOR PLAN	DATE JULY 16, 1957
STRUCTURAL CHECKED BY		SCALE 1/8" = 1'0"
FIELD CHECK BY ARCH'T		DRAWING NO. 57/4021
ENG. APPROVED BY	STATE OF NEW YORK DEPARTMENT OF PUBLIC WORKS DIVISION OF ARCHITECTURE CARL W. LARSON STATE ARCHITECT	

BLDG# 1

NOTE: DRAWING NOT TO SCALE

NYS OFFICE OF GENERAL SERVICES
Serving New York

ANDREW M. CUOMO
Governor
ROANN M. DESTITO
Commissioner

CONSULTANT

WARNING:
THE ALTERATION OF THIS MATERIAL IN ANY WAY, UNLESS DONE UNDER THE DIRECTION OF A COMPARABLE PROFESSIONAL, I.E. ARCHITECT FOR AN ARCHITECT, ENGINEER FOR AN ENGINEER OR LANDSCAPE ARCHITECT FOR A LANDSCAPE ARCHITECT, IS A VIOLATION OF THE NEW YORK STATE EDUCATION LAW AND/OR REGULATIONS AND IS A CLASS 'A' MISDEMEANOR.

CONTRACT:
CONSTRUCTION

TITLE:
DEMOLISH BUILDING
NOS. 1 & 1A

LOCATION:
STATE OFFICE BUILDING CAMPUS
1220 WASHINGTON AVENUE
ALBANY, N.Y. 12226

CLIENT:
NEW YORK STATE
OFFICE OF GENERAL SERVICES

MARK	DATE	DESCRIPTION
	8/26/13	BID DOCUMENTS

PROJECT NUMBER: 44845 – C
DESIGNED BY:
DRAWN BY:
FIELD CHECK:
APPROVED:

SHEET TITLE:
EXIST. ELECTRICAL REF. DWG.
THIRD FLOOR PLAN
120/208 VOLT & TELE. OUTLETS

DRAWING NUMBER:
57–4021

SHEET OF

Sep 12,2013 – 10:33am
V:\DesignAndConstr\p448xx\44845\CadStru\ELEC\57-4021.dwg
36x24 PLOT SHEET

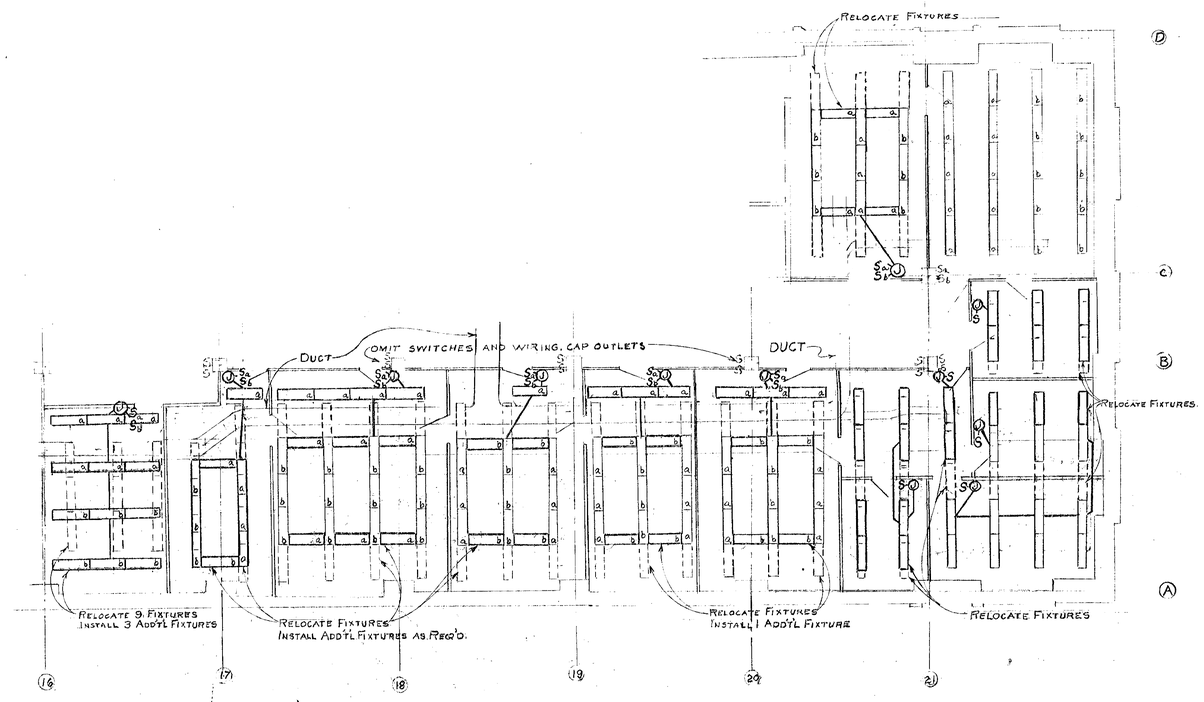

NOTES:

1. RECONNECT LIGHTING FIXTURES FOR SWITCHING AS SHOWN.
2. STEEL PARTITIONS WITH OUTLET BOX OPENINGS WILL BE FURNISHED AND INSTALLED BY OTHERS. ELECTRIC CONTRACTOR SHALL FURNISH & INSTALL SWITCH BOXES, SWITCHES AND CIRCUIT EXTENSIONS THERETO IN STEEL PARTITIONS AFTER THEIR ERECTION.
3. WORK NOT CHANGED BY THESE DRAWINGS SHALL BE INSTALLED AS PER BASE CONTRACT OR PREVIOUS CONTRACT.
4. ADDITIONAL JUNCTION BOXES FOR SWITCH LEGS TO METAL PARTITIONS SHALL BE MOUNTED FLUSH WITH FINISHED CEILING ADJACENT TO METAL PARTITIONS. JUNCTION BOXES SHALL HAVE BLANK COVERS.
5. LOCAL SWITCHES INSTALLED IN METAL PARTITIONS SHALL BE P.&S NO 1311 & 1313 OR EQUAL. WIRING WITHIN METAL PARTITIONS SHALL BE DONE WITH FLEXIBLE ARMORED CABLE (BX)
6. SPACE FIXTURES IN CONTINUOUS ROWS TO FIT AGAINST ENDS OF CROSS FIXTURES. NOTCH FIXTURE TRIM AS REQUIRED.
7. LIGHTING FIXTURES SHOWN ARE TYPE FD 2/40 AS PER BASE CONTRACT.
8. WORK OF THIS CONTRACT SHALL INCLUDE HOME RUN RELOCATIONS AS NECESSARY.

PART SECOND FLOOR PLAN - WEST END

LEGEND:

- ① JUNCTION BOX - SINGLE
- S SINGE POLE SWITCH
- —— ADDITIONAL OR RELOCATED FACILITIES IN THIS CONTRACT.
- —— FACILITIES INCLUDED IN BASE CONTRACT OR PREVIOUS ORDER ON CONTRACT TO REMAIN.
- - - FACILITIES IN BASE CONTRACT OR PREVIOUS ORDER ON CONTRACT TO BE REMOVED OR OMITTED
- ═══ MOVABLE METAL PARTITIONS BY OTHERS - CEILING HEIGHT

REVISIONS

DEPARTMENT OF CIVIL SERVICE
STATE OFFICE BUILDING

CAMPUS SITE ALBANY NEW YORK

DRAWN BY: HBA	ELECTRIC	PROJECT NO 12978
TRACED BY: HBA	ELECTRIC CHANGES & ADDITIONS TO CONFORM WITH OFFICE PARTITIONING & DUCT WORK.	SPECIFICATION NO 18884
CHECKED BY: C.S.D.		DATE JUNE 19, 1957
CROSS CHECKED BY: C.S.D.	PART SECOND FLOOR PLAN	SCALE 1/8" = 1'-0"
FIELD CHECK BY ARCH.	STATE OF NEW YORK DEPARTMENT OF PUBLIC WORKS DIVISION OF ARCHITECTURE CARL W. LARSON STATE ARCHITECT	DRAWING NO. 57/4022
APPROVED BY: ENGR. CIVIL		

SCANNED
2005

NOTE: DRAWING NOT TO SCALE

NYS OFFICE OF GENERAL SERVICES
Serving New York

ANDREW M. CUOMO
Governor
ROANN M. DESTITO
Commissioner

CONSULTANT

WARNING:
THE ALTERATION OF THIS MATERIAL IN ANY WAY, UNLESS DONE UNDER THE DIRECTION OF A COMPARABLE PROFESSIONAL, I.E. ARCHITECT FOR AN ARCHITECT, ENGINEER FOR AN ENGINEER OR LANDSCAPE ARCHITECT FOR A LANDSCAPE ARCHITECT, IS A VIOLATION OF THE NEW YORK STATE EDUCATION LAW AND/OR REGULATIONS AND IS A CLASS 'A' MISDEMEANOR.

CONTRACT: CONSTRUCTION

TITLE: DEMOLISH BUILDING NOS. 1 & 1A

LOCATION: STATE OFFICE BUILDING CAMPUS
1220 WASHINGTON AVENUE
ALBANY, N.Y. 12226

CLIENT: NEW YORK STATE OFFICE OF GENERAL SERVICES

MARK	DATE	DESCRIPTION
	8/26/13	BID DOCUMENTS

PROJECT NUMBER: 44845 – C

DESIGNED BY:
DRAWN BY:
FIELD CHECK:
APPROVED:

SHEET TITLE:
EXIST. ELECTRICAL REF. DWG.
PART 2ND FLOOR PLAN
ELEC. CHANGES & ADDITIONS

DRAWING NUMBER: 57–4022

SHEET OF

Sep 12,2013 – 10:33am
V:\DesignAndConstr\p448xx\44845\CadStru\ELEC\57-4022.dwg
36x24 PLOT SHEET

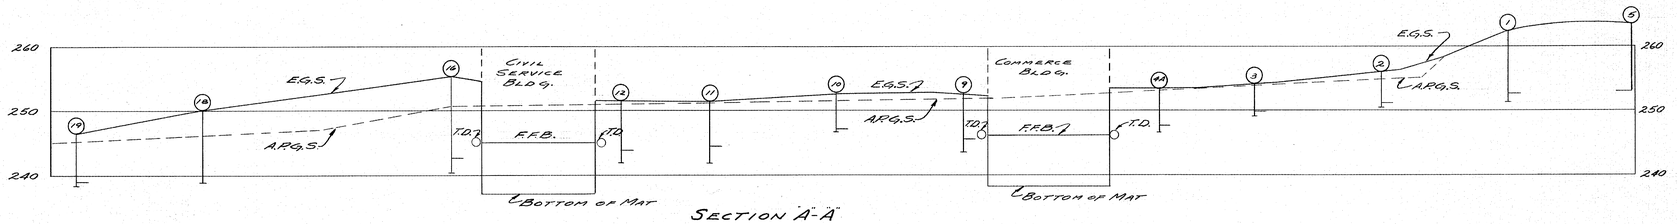

SECTION 'A'-'A'

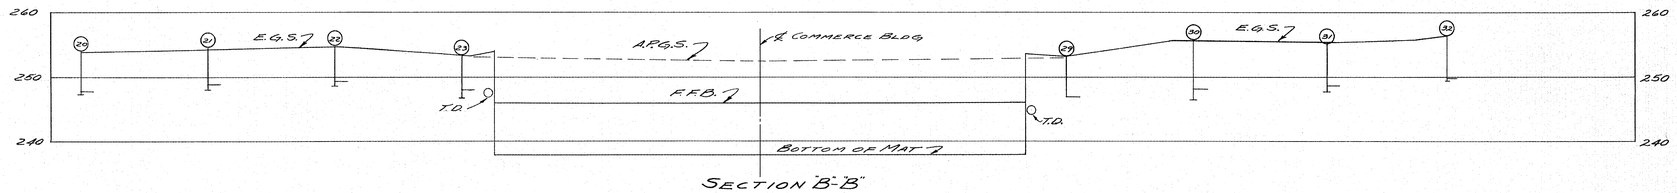

SECTION 'B'-'B'

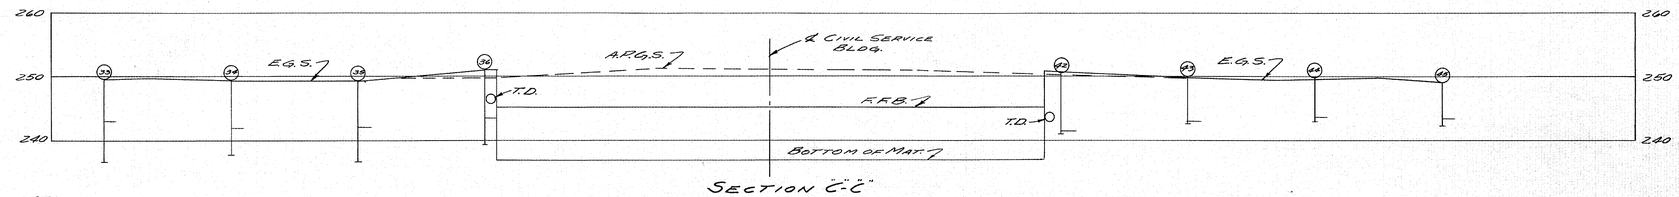

SECTION 'C'-'C'

PROFILES

SCALES ==== HORIZONTAL 1" = 10'-0"
VERTICAL 1" = 50'-0"

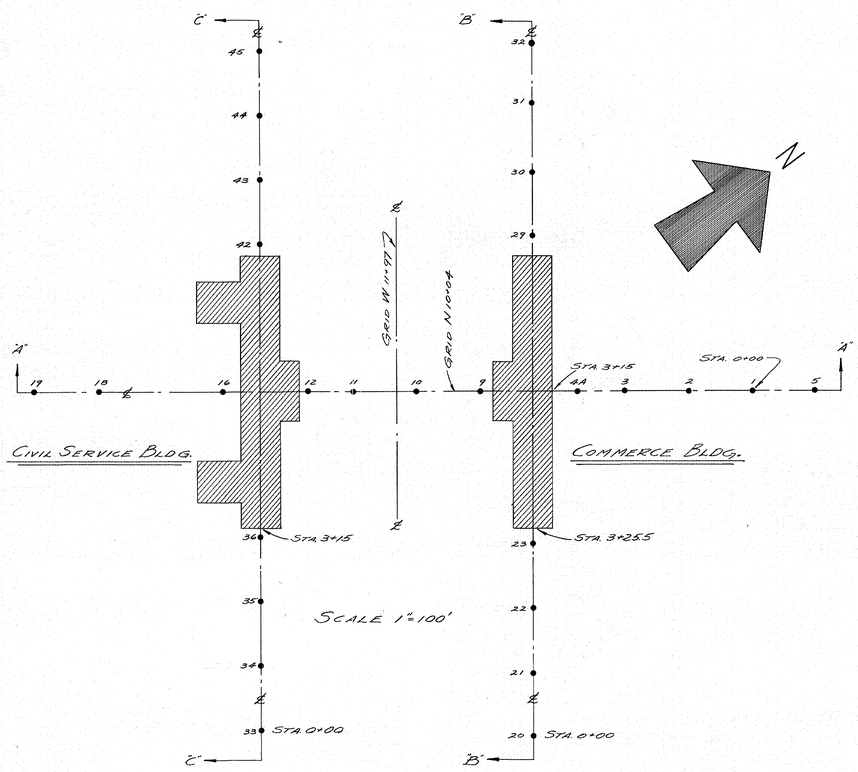

SYMBOLS

E.G.S. = EXISTING GROUND SURFACE

A.P.G.S. = APPROXIMATE PRECONSTRUCTION GROUND SURFACE

T.D. O = TILE DRAINS

F.F.B. = FINISHED FLOOR IN BASEMENT

(5) — AUGER HOLE NUMBER

SURFACE OF EXISTING GROUND AT HOLES IN AUGUST, 1956

LIMIT OF OBSERVED WATER LEVEL

BOTTOM OF AUGER HOLES

NOTES

THE CONTRACTOR IS ADVISED THAT PREVIOUS CONTRACTORS ON THIS SITE HAVE EXPERIENCED CONSIDERABLE DIFFICULTY WITH EXCAVATION BELOW THE GROUND WATER TABLE DUE TO PRESENCE OF UNSTABLE SATURATED FINE GRAINED MATERIALS GENERALLY UNDERLYING THE SITE.

THE LOGS OF OTHER BORINGS OF THE "CAMPUS SITE" ARE ON FILE IN THE DIVISION OF ARCHITECTURE AND MAY BE EXAMINED ON REQUEST BY PROSPECTIVE BIDDERS.

THE AUGER HOLES SHOWN ON THIS SHEET WERE DRILLED AND THE WATER LEVEL OBSERVATIONS MADE BETWEEN AUGUST 23 AND AUGUST 27, 1956 AND ARE INDICATIVE OF CONDITIONS AT THAT TIME. THIS INFORMATION IS GIVEN FOR THE CONTRACTORS INFORMATION ONLY, WITHOUT INTERPRETATION.

NEW YORK STATE OFFICE BUILDING SITE
"CAMPUS SITE"

ALBANY		NEW YORK
DRAWN BY R.E.M.	GENERAL ENGINEERING	PROJECT No. 14077
CHECKED BY J.L.	CIVIL SERVICE & COMMERCE BLDG.'S BUILDING UNITS 1 & 2	SPEC. No. 14077 G.E.
TRACED BY R.E.M.	SERVICE CONNECTIONS	DATE JAN 18 1957
TRACING CKD. BY J.P.C.	SEWER & WATER LINES SUBSURFACE INFORMATION	SCALE AS SHOWN
FIELD CHECK BY J.H. Hazle J.S.C. 1/30/57	STATE OF NEW YORK DEPARTMENT OF PUBLIC WORKS	DRAWING No. 57/5008
APPROVED BY	DIVISION OF ARCHITECTURE CARL W. LARSON STATE ARCHITECT	

APPROVED BY _____

DATED _____

NOTE: DRAWING NOT TO SCALE

NYS OFFICE OF GENERAL SERVICES
Serving New York
ANDREW M. CUOMO
Governor
ROANN M. DESTITO
Commissioner

CONSULTANT

WARNING:
THE ALTERATION OF THIS MATERIAL IN ANY WAY, UNLESS DONE UNDER THE DIRECTION OF A COMPARABLE PROFESSIONAL, I.E. ARCHITECT FOR AN ARCHITECT, ENGINEER FOR AN ENGINEER OR LANDSCAPE ARCHITECT FOR A LANDSCAPE ARCHITECT, IS A VIOLATION OF THE NEW YORK STATE EDUCATION LAW AND/OR REGULATIONS AND IS A CLASS 'A' MISDEMEANOR.

CONTRACT:
CONSTRUCTION

TITLE:
DEMOLISH BUILDING NOS. 1 & 1A

LOCATION:
STATE OFFICE BUILDING CAMPUS
1220 WASHINGTON AVENUE
ALBANY, N.Y. 12226

CLIENT:
NEW YORK STATE OFFICE OF GENERAL SERVICES

MARK	DATE	DESCRIPTION
	8/26/13	BID DOCUMENTS

PROJECT NUMBER: 44845 – C

DESIGNED BY:
DRAWN BY:
FIELD CHECK:
APPROVED:

SHEET TITLE:
EXIST. SITE REF. DWG.
SERVICE CONNECTIONS
SEWER & WATER LINES
SUBSURFACE INFORMATION

DRAWING NUMBER:
57–5008

SHEET OF

Sep 12,2013 – 11:25am
V:\Designed\Const\p44xx\44845\CivilStru\SITE\57-5008.dwg
36x24 PLOT SHEET

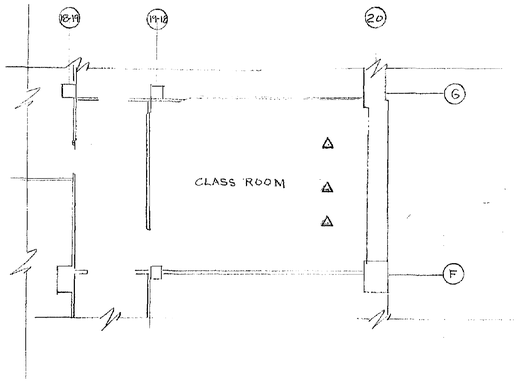

FIRST FLOOR - WEST WING

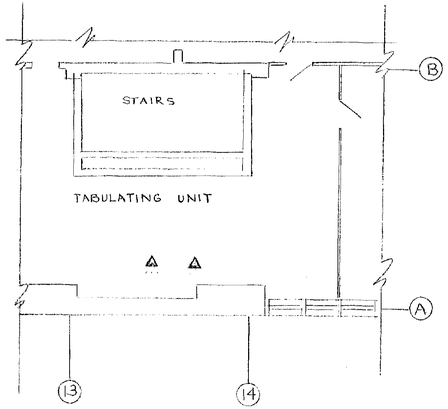

SECOND FLOOR - CENTER

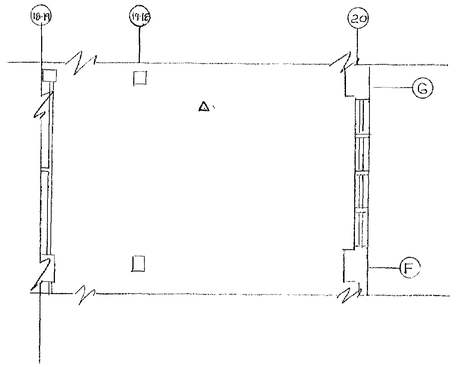

THIRD FLOOR - WEST WING

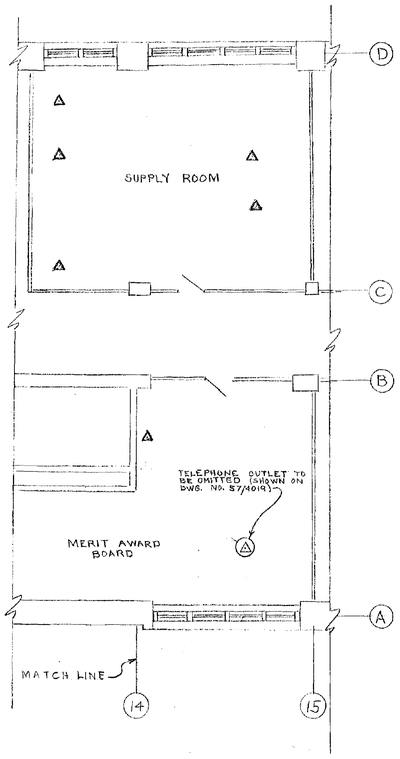

FIRST FLOOR - WEST WING

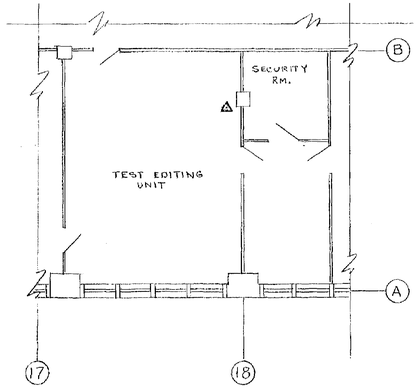

THIRD FLOOR - WEST WING

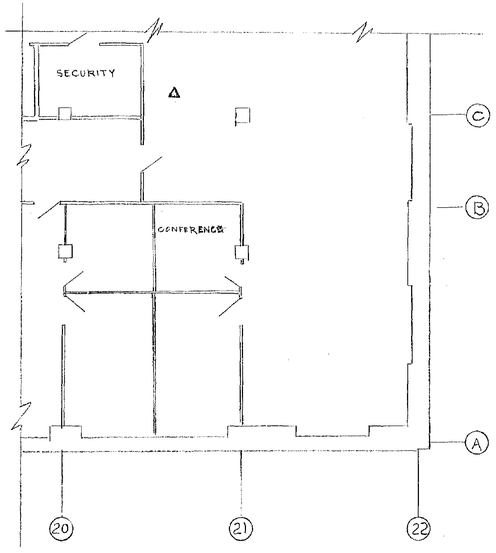

THIRD FLOOR - WEST WING

SYMBOLS & ABBREVIATIONS

△ NEW TELEPHONE OUTLET

Ⓐ TELEPHONE OUTLET TO BE OMITTED

REVISIONS

DEPARTMENT OF CIVIL SERVICE
STATE OFFICE BUILDING

CAMPUS SITE ALBANY NEW YORK

DRAWN BY H.W.	ELECTRIC	PROJECT NO 12978
TRACED BY H.W.	FLOOR OUTLET LOCATIONS FOR TELEPHONE SYSTEMS	SPECIFICATION NO. 18884
CHECKED BY C.L.D.	PART 1ST, 2ND & 3RD FLOOR PLANS	DATE JAN. 9, 1958
CROSS CHECK BY C.L.D.		SCALE 1/8" = 1'0"
FIELD CHECK BY ARCH'T		DRAWING NO 58/4023
ENG.	STATE OF NEW YORK DEPARTMENT OF PUBLIC WORKS DIVISION OF ARCHITECTURE	
APPROVED BY	CARL W. LARSON STATE ARCHITECT	

SCANNED
2005

NOTE: DRAWING NOT TO SCALE

NYS OFFICE OF GENERAL SERVICES
Serving New York

ANDREW M. CUOMO
Governor
ROANN M. DESTITO
Commissioner

CONSULTANT

WARNING:
THE ALTERATION OF THIS MATERIAL IN ANY WAY, UNLESS DONE UNDER THE DIRECTION OF A COMPARABLE PROFESSIONAL, I.E. ARCHITECT FOR AN ARCHITECT, ENGINEER FOR AN ENGINEER OR LANDSCAPE ARCHITECT FOR A LANDSCAPE ARCHITECT, IS A VIOLATION OF THE NEW YORK STATE EDUCATION LAW AND/OR REGULATIONS AND IS A CLASS 'A' MISDEMEANOR.

CONTRACT: CONSTRUCTION

TITLE: DEMOLISH BUILDING NOS. 1 & 1A

LOCATION: STATE OFFICE BUILDING CAMPUS
1220 WASHINGTON AVENUE
ALBANY, N.Y. 12226

CLIENT: NEW YORK STATE OFFICE OF GENERAL SERVICES

MARK	DATE	DESCRIPTION
	8/26/13	BID DOCUMENTS

PROJECT NUMBER: 44845 – C

DESIGNED BY:
DRAWN BY:
FIELD CHECK:
APPROVED:

SHEET TITLE: EXIST. ELECTRICAL REF. DWG. PART 1ST, 2ND & 3RD FLR. PLANS – TELE. OUTLETS

DRAWING NUMBER: 58–4023

SHEET OF

Sep 12,2013 – 10:32am
V:\DesignAndConstr\p448xx\44845\CadStru\ELEC\58-4023.dwg
36x24 PLOT SHEET

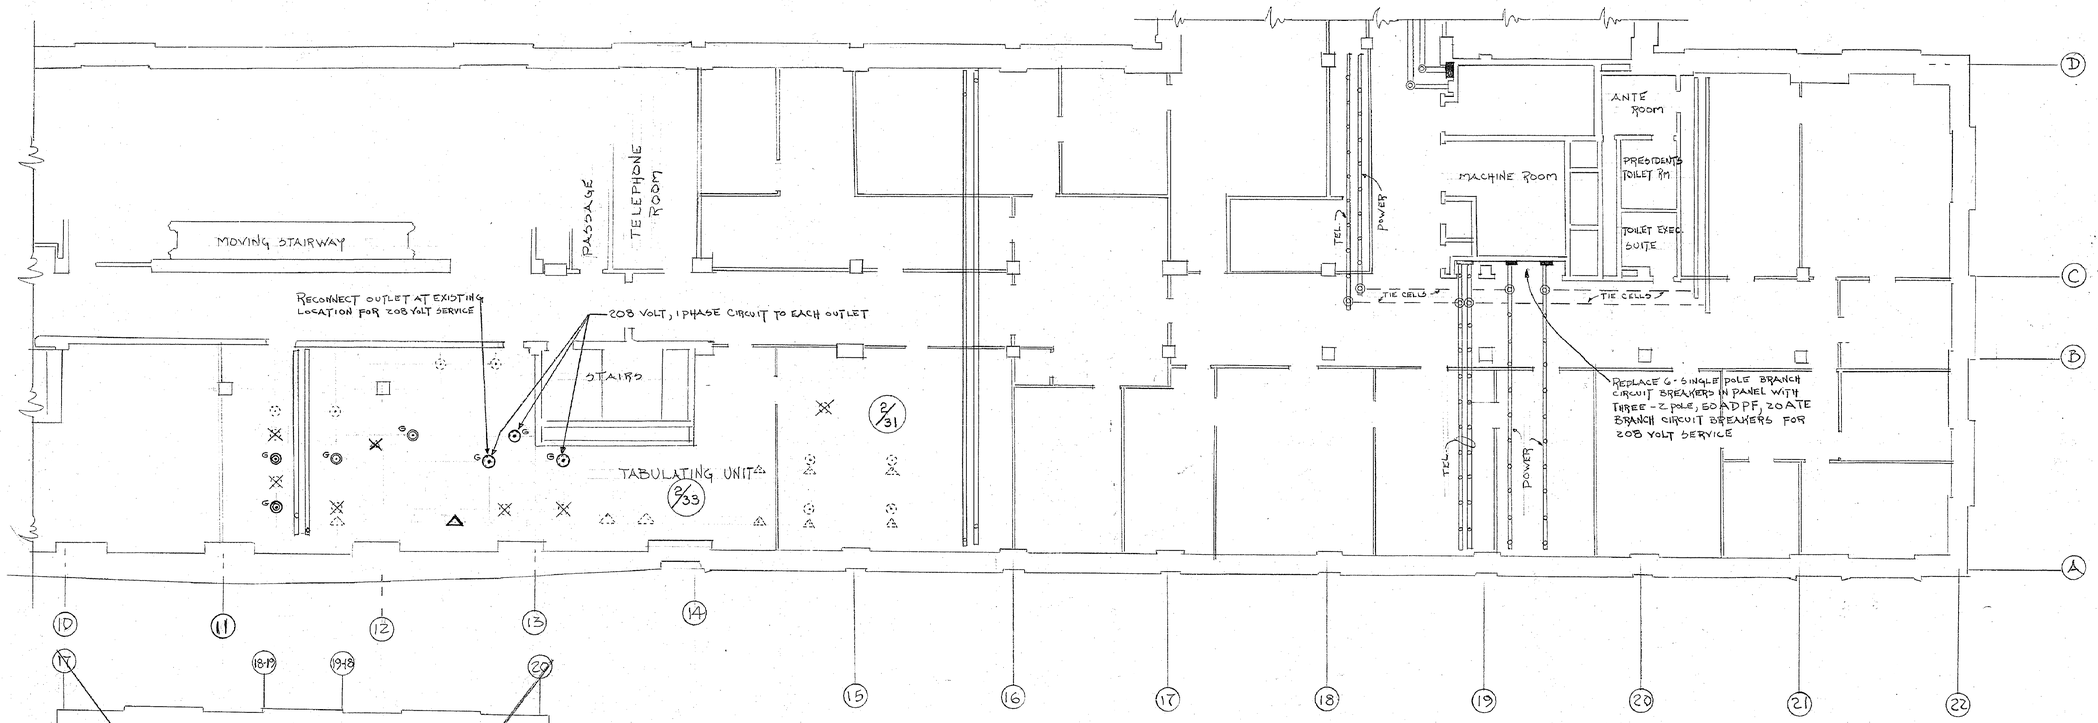

PART SECOND FLOOR PLAN

NOTE:
THIS DRAWING SHOWS LOCATIONS OF FLOOR OUTLETS IN SPACES 2/31 AND 2/33

SYMBOLS

- FLOOR OUTLET AND 250 VOLT, 20 AMPERE, 3 POLE, 2 WIRE, SINGLE CONVENIENCE RECEPTACLE WITH GROUNDING POLE GROUNDED TO RACEWAY.
- FLOOR OUTLET AND 250 VOLT, 10 AMPERE, 3 POLE 2 WIRE SINGLE CONVENIENCE RECEPTACLE WITH GROUNDING POLE GROUNDED TO RACEWAY.
- EXISTING FLOOR OUTLET & RECEPTACLE TO REMAIN.
- FLOOR OUTLET, RECEPTACLE AND WIRE TO BE REMOVED AND FLOOR CAP INSTALLED.
- EXISTING TELEPHONE FLOOR OUTLET TO REMAIN
- TELEPHONE FLOOR OUTLET TO BE REMOVED AND FLOOR CAP INSTALLED.
- NEW TELEPHONE FLOOR OUTLET

REVISIONS

DEPARTMENT OF CIVIL SERVICE
STATE OFFICE BUILDING
CAMPUS SITE ALBANY NEW YORK

DRAWN BY: R.V.D.	ELECTRIC	PROJECT NO. 12978
TRACED BY: RVD	FLOOR OUTLET LOCATIONS FOR 120/208 VOLT SYSTEM & TELEPHONE SYSTEM	SPECIFICATION NO 18884
CHECKED BY CLD		DATE MARCH 13, 1958
CROSS CHECKED BY CLD	PART SECOND FLOOR PLAN	SCALE 1/8" = 1'-0"
FIELD CHECKED BY ARCH'T		DRAWING NO. 58/4024
CLD ENG	STATE OF NEW YORK DEPARTMENT OF PUBLIC WORKS DIVISION OF ARCHITECTURE CARL W. LARSON STATE ARCHITECT	
APPROVED BY:		

APPROVED BY:
DATE: LETTER NO.

NOTE: DRAWING NOT TO SCALE

NYS OFFICE OF GENERAL SERVICES
Serving New York
ANDREW M. CUOMO
Governor
ROANN M. DESTITO
Commissioner

CONSULTANT

WARNING:
THE ALTERATION OF THIS MATERIAL IN ANY WAY, UNLESS DONE UNDER THE DIRECTION OF A COMPARABLE PROFESSIONAL, I.E. ARCHITECT FOR AN ARCHITECT, ENGINEER FOR AN ENGINEER OR LANDSCAPE ARCHITECT FOR A LANDSCAPE ARCHITECT, IS A VIOLATION OF THE NEW YORK STATE EDUCATION LAW AND/OR REGULATIONS AND IS A CLASS 'A' MISDEMEANOR.

CONTRACT: CONSTRUCTION

TITLE: DEMOLISH BUILDING NOS. 1 & 1A

LOCATION: STATE OFFICE BUILDING CAMPUS
1220 WASHINGTON AVENUE
ALBANY, N.Y. 12226

CLIENT: NEW YORK STATE OFFICE OF GENERAL SERVICES

MARK	DATE	DESCRIPTION
	8/26/13	BID DOCUMENTS

PROJECT NUMBER: 44845 – C
DESIGNED BY:
DRAWN BY:
FIELD CHECK:
APPROVED:

SHEET TITLE: EXIST. ELECTRICAL REF. DWG. PART 2ND FLR. PLAN – 120/208 VOLT & TELE. OUTLET

DRAWING NUMBER: 58–4024

SHEET OF

Sep 12,2013 – 10:32am
V:\DesignAndConstr\p448xx\44845\CadStru\ELEC\58-4024.dwg
36x24 PLOT SHEET

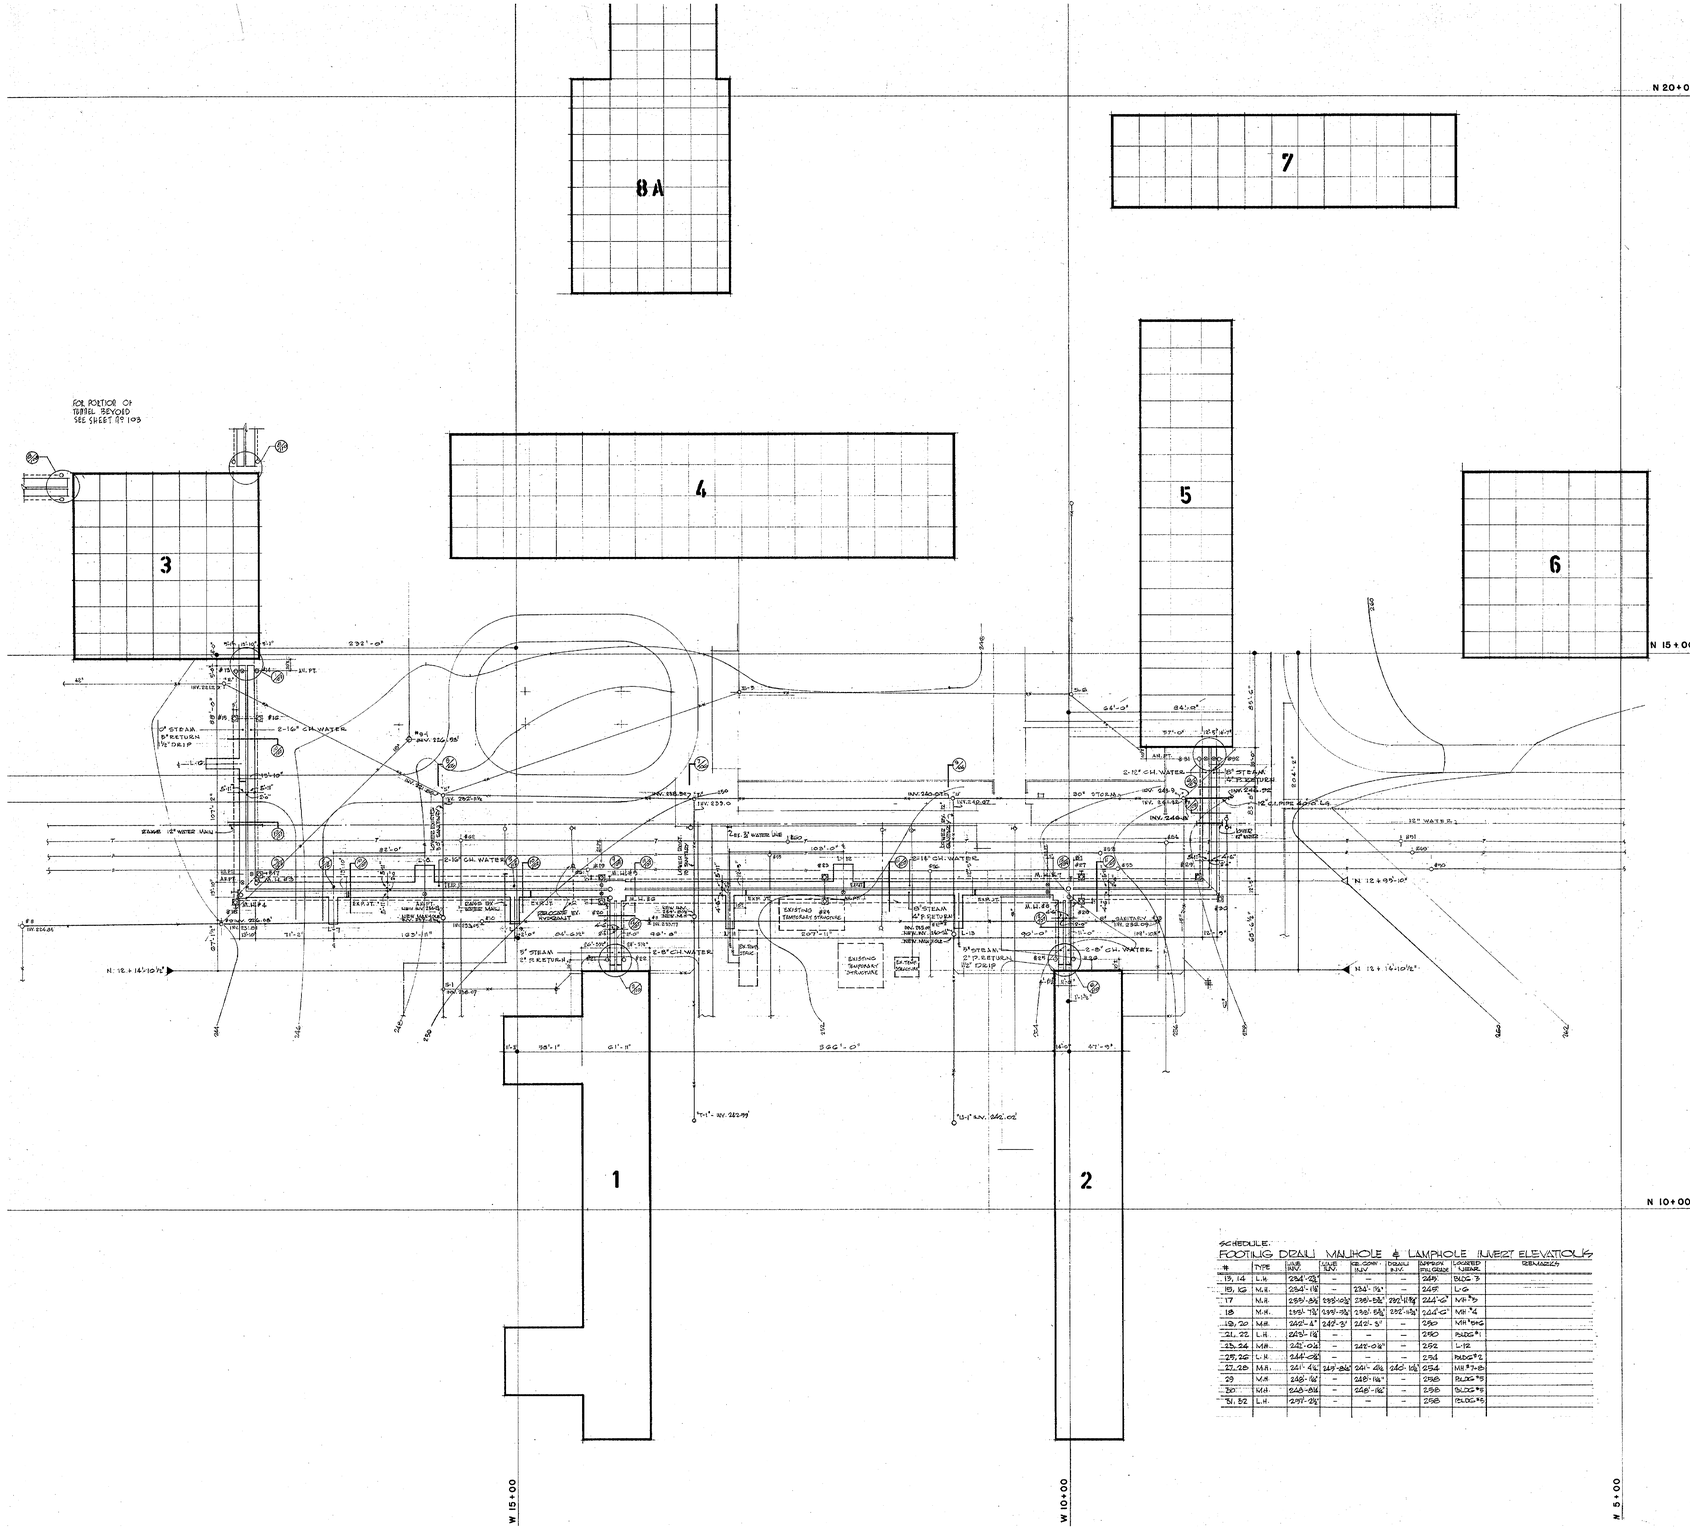

NOTES:

1. SEE GENERAL NOTES ON DRAWING NO. GO/102.

LEGEND

241	EXISTING CONTOUR
241	PROPOSED CONTOUR
	FOOTING DRAIN
#10	FOOTING DRAIN MANHOLE NUMBER, 10 - (WITH DRAIN)
#45	FOOTING DRAIN LAMP HOLE NUMBER, 45
A.P.#8	ANCHOR POINT
M.H.#4	MANHOLE NUMBER, 4
	EXISTING SANITARY SEWER
	EXISTING STORM SEWER
	EXISTING WATER LINE
	EXISTING TELEPHONE LINE
	EXISTING POWER
	EXISTING HYDRANT
	EXISTING VALVE
L-5	EXPANSION LOOP NUMBER, 5
	DETAIL REFERENCE NUMBER
1/60	DETAIL NUMBER / DRAWING NUMBER
CH. W. S.	CHILLED WATER SUPPLY
CH. W. R.	CHILLED WATER RETURN
CH. W.	CHILLED WATER (S. & R.)
H. P. S.	HIGH PRESSURE STEAM
H. P. DRIP	HIGH PRESSURE DRIP
P. RETURN	PUMPED CONDENSATE RETURN
M.H.#1 / M.H.#2	SUMP PIT DRAIN - MANHOLES NUMBER 1 & 2

SCHEDULE:
FOOTING DRAIN MANHOLE & LAMPHOLE INVERT ELEVATIONS

No.	TYPE	INVERT ENTRY	INVERT EXIT	INV. CORR. INV.	DRAIN P.V.	EXPANSION FOLLOWER	LOCATED IN BLDG.	REMARKS
13, 14	L.H.	234'-0½"	–	–	–	249	BLDG 3	
15, 16	M.H.	234'-1½"	–	234'-1½"	–	249	L-6	
17	M.H.	235'-8½"	235'-10½"	236'-8½"	235'-11½"	244'-6"	MH #3	
18	M.H.	235'-7½"	235'-9½"	236'-8½"	235'-10½"	244'-6"	MH #4	
19, 20	M.H.	242'-4"	242'-5"	242'-5"	–	250	MH #4G	
21, 22	L.H.	243'-1½"	–	–	–	250	BLDG #1	
23, 24	M.H.	241'-0½"	–	242'-0½"	–	252	L-12	
25, 26	L.H.	244'-0½"	–	–	–	254	BLDG #2	
27, 28	M.H.	241'-4½"	243'-8½"	241'-4½"	242'-1½"	254	MH #3-B	
29	M.H.	248'-1½"	–	248'-1½"	–	258	BLDG #3	
30	M.H.	248'-8½"	–	248'-1½"	–	258	BLDG #3	
31, 32	L.H.	257'-2½"	–	–	–	258	BLDG #3	

NOTE: DRAWING NOT TO SCALE

NYS OFFICE OF GENERAL SERVICES

Serving New York

ANDREW M. CUOMO
Governor
ROANN M. DESTITO
Commissioner

CONSULTANT

WARNING:

THE ALTERATION OF THIS MATERIAL IN ANY WAY, UNLESS DONE UNDER THE DIRECTION OF A COMPARABLE PROFESSIONAL, I.E. ARCHITECT FOR AN ARCHITECT, ENGINEER FOR AN ENGINEER OR LANDSCAPE ARCHITECT FOR A LANDSCAPE ARCHITECT, IS A VIOLATION OF THE NEW YORK STATE EDUCATION LAW AND/OR REGULATIONS AND IS A CLASS 'A' MISDEMEANOR.

MARK	DATE	DESCRIPTION
	8/26/13	BID DOCUMENTS

STATE OFFICE BUILDING
CAMPUS SITE ALBANY, N. Y.

DRAWN BY	CONSTRUCTION	PROJECT NO. 16297
TRACED BY	HEATING & CHILLED WATER TUNNELS	SPECIFICATION NO. 16297 - C
DIMENSIONS CHECKED BY	TUNNEL PLAN II	DATE AUG. 15, 1960
STRUCTURAL CHECKED BY	BLDG'S NO. 3, 1, 2 & 5	SCALE 1" = 40'-0"
FIELD CHECK BY	UNGER & UNGER - FRANCIS X. GINLY & ASSOCIATES ASSOCIATED ARCHITECTS 219 E. 44 ST. NEW YORK, N. Y. GI STASIO & VAN BUREN - STRUCTURAL ENGINEERS SYSKA & HENNESSY INC. MECHANICAL ENGINEERS	DRAWING NO. 60/104
APPROVED BY	STATE OF NEW YORK DEPARTMENT OF PUBLIC WORKS DIVISION OF ARCHITECTURE J. BURTON HUGHES SUPERINTENDENT CARL M. LARSEN STATE ARCHITECT	

APPROVED BY: E. BURTON HUGHES
DEPARTMENT OF PUBLIC WORKS
DATE: SEPT. 6, 1960 LETTER NO. 25828

PROJECT NUMBER:	44845 – C
DESIGNED BY:	
DRAWN BY:	
FIELD CHECK:	
APPROVED:	

SHEET TITLE:

EXIST. SITE REF. DWG.
TUNNEL PLAN II

DRAWING NUMBER:

60–104

SHEET OF

Sep 12,2013 - 11:04am
V:\Designand Const\p44845\CadSrv\SITE\60-104.dwg
36x24 PLOT SHEET

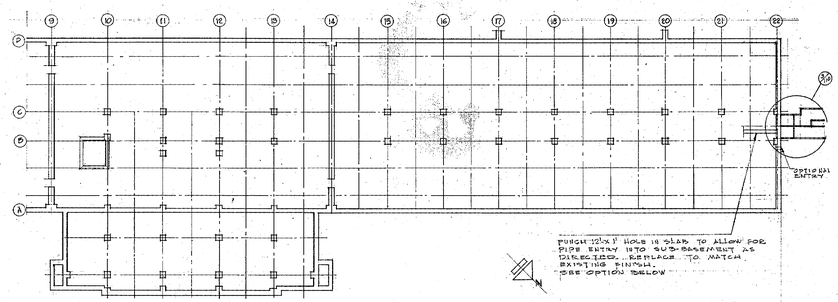

1/110 BASEMENT FLOOR PLAN BUILDING #1
SCALE: 1/16" = 1'-0"

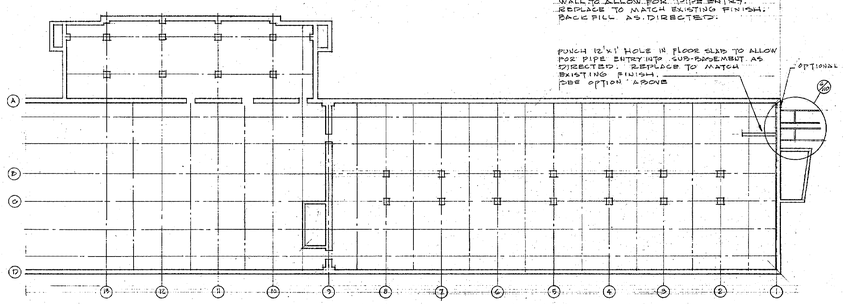

2/110 BASEMENT FLOOR PLAN BUILDING #2
SCALE: 1/16" = 1'-0"

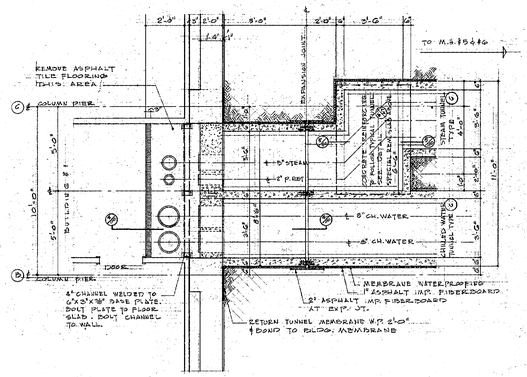

3/110 PLAN-THRU STEAM & CH.W. TUNNELS
AT BUILDING #1
SCALE: 3/8" = 1'-0"

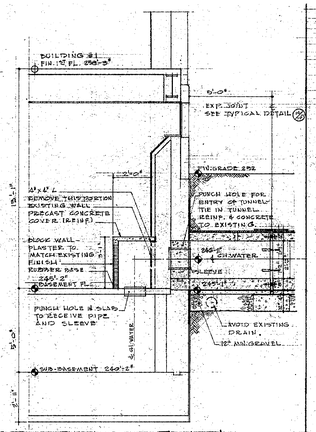

4/110 SECTION-THRU CH.W. TUNNEL
AT BUILDING #1

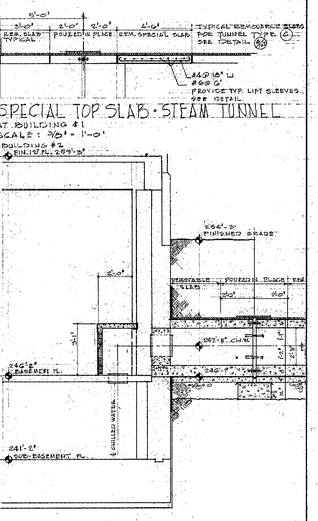

5/110 SPECIAL TOP SLAB-STEAM TUNNEL
AT BUILDING #1
SCALE: 3/8" = 1'-0"

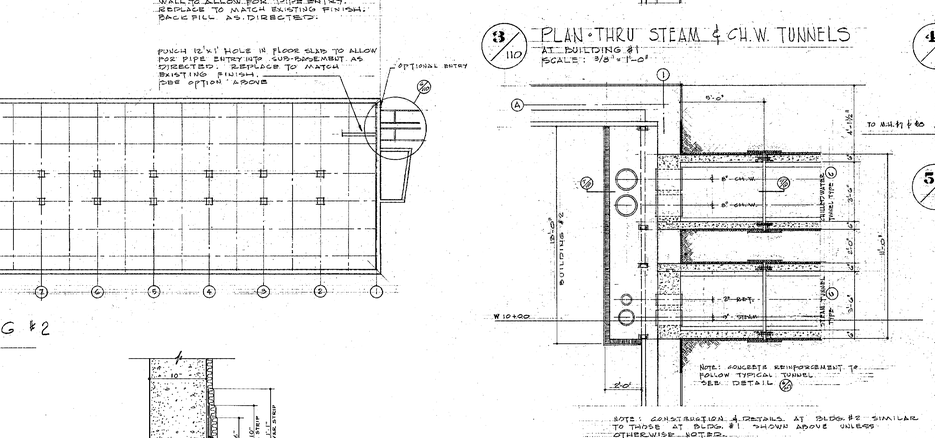

NOTE: CONSTRUCTION & DETAILS AT BLDG. #2 SIMILAR TO THOSE AT BLDG. #1 SHOWN ABOVE UNLESS OTHERWISE NOTED.

6/110 PLAN-THRU STEAM & CH.W. TUNNEL
AT BUILDING #2
SCALE: 3/8" = 1'-0"

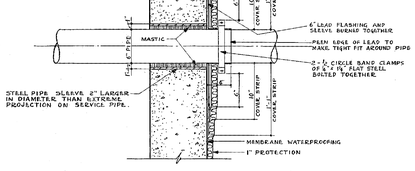

PIPE SLEEVE DETAILS
WHERE WATERPROOFING OCCURS.
SCALE - 12" = 1'-0"

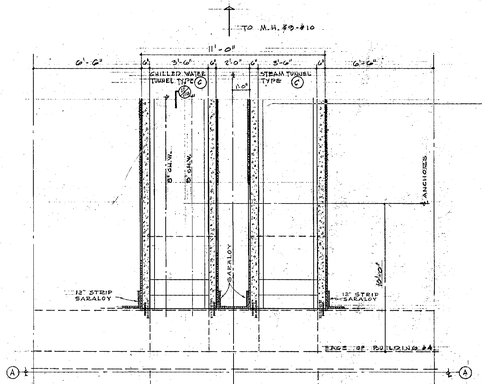

10/110 PLAN-THRU STEAM & CH.W. TUNNELS
AT BUILDING #4
SCALE: 3/8" = 1'-0"

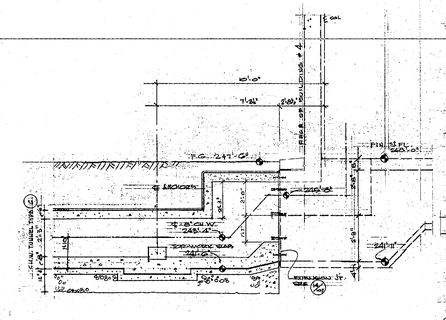

11/110 SECTION-THRU CH.W. TUNNEL
AT BUILDING #4
SCALE: 3/8" = 1'-0"

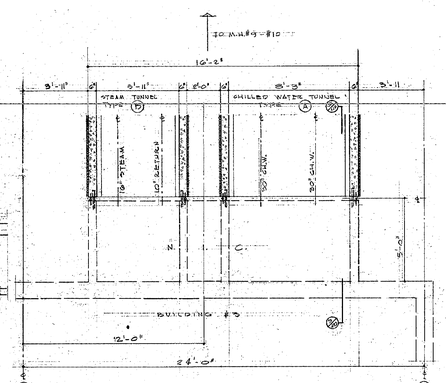

8/110 PLAN-THRU STEAM & CH.W. TUNNELS
AT NORTH CORNER BUILDING #3
SCALE: 3/8" = 1'-0"

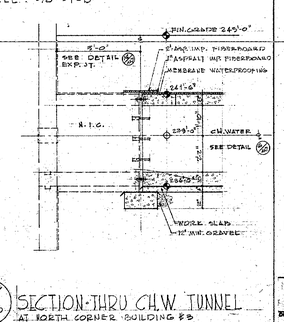

9/110 SECTION-THRU CH.W. TUNNEL
AT NORTH CORNER BUILDING #3
SCALE: 3/8" = 1'-0"

NOTES:

1. SEE GENERAL NOTES ON DWG NO. 60/100
2. PUNCHING OF HOLES IN EXISTING WALLS OR SLABS TO BE CO-ORDINATED WITH STATE ARCHITECTS OFFICE, D.P.W.
3. STRUCTURAL DESIGN CRITERIA
   A. CONCRETE: 5000# CONCRETE
   B. REINFORCING STEEL: INTERMEDIATE GRADE, 1-50% DEFORMATION
   C. MANHOLES & TUNNELS DESIGNED FOR: H20 LOADING ON EARTH 3'-0" (MIN.) ABOVE TOP OF SLAB (EQUIVALENT LOAD 1200#/SQ. FT.)

NOTE: DRAWING NOT TO SCALE

STATE OFFICE BUILDING CAMPUS SITE ALBANY, N. Y.		
DRAWN BY	CONSTRUCTION	PROJECT NO. 16297
TRACED BY	HEATING & CHILLED WATER TUNNELS	SPECIFICATION NO. 16297-C
SUPERVISOR CHECKED BY		DATE AUG. 12-1960
STRUCTURAL CHECKED BY	CONNECTIONS AT BLDGS NO. 1,2,3,&4	SCALE AS SHOWN
FIELD CHECK BY		DRAWING NO. 60/110
ARCHITECT LETTER & SEAL OVER PLACE OF ARCHITECT	UNGER & UNGER – FRANCIS X. GINA' & ASSOCIATES ASSOCIATED ARCHITECTS 215 E. 44 ST. NEW YORK 17, N. Y. D. STERO & VAN BUREN STRUCTURAL ENGINEERS EVSKA & HENNESSY INC. MECHANICAL ENGINEERS	
APPROVED BY	STATE OF NEW YORK DEPARTMENT OF PUBLIC WORKS DIVISION OF ARCHITECTURE CONSTRUCTION DESIGN CARL W. SWISON STATE ARCHITECT	
APPROVED BY: E. BURTON HUGES DEPARTMENT OF PUBLIC WORKS		
DATE: SEPT. 8, 1960 LETTER NO. 22965		

NYS OFFICE OF GENERAL SERVICES
Serving New York
ANDREW M. CUOMO
Governor
ROANN M. DESTITO
Commissioner

CONSULTANT

WARNING:
THE ALTERATION OF THIS MATERIAL IN ANY WAY, UNLESS DONE UNDER THE DIRECTION OF A COMPARABLE PROFESSIONAL, I.E. ARCHITECT FOR AN ARCHITECT, ENGINEER FOR AN ENGINEER OR LANDSCAPE ARCHITECT FOR A LANDSCAPE ARCHITECT, IS A VIOLATION OF THE NEW YORK STATE EDUCATION LAW AND/OR REGULATIONS AND IS A CLASS 'A' MISDEMEANOR.

MARK	DATE	DESCRIPTION
	8/26/13	BID DOCUMENTS

CONTRACT: CONSTRUCTION

TITLE: DEMOLISH BUILDING NOS. 1 & 1A

LOCATION: STATE OFFICE BUILDING CAMPUS
1220 WASHINGTON AVENUE
ALBANY, N.Y. 12226

CLIENT: NEW YORK STATE OFFICE OF GENERAL SERVICES

PROJECT NUMBER: 44845 – C

DESIGNED BY:
DRAWN BY:
FIELD CHECK:
APPROVED:

SHEET TITLE: EXIST. SITE REF. DWG. CONNECTION AT BUILDING

DRAWING NUMBER: 60–110

SHEET OF

Sep 12,2013 – 11:04am
V:\Designed\Consch\pH8ax\44845\CadStru\SITE\60-110.dwg
36x24 PLOT SHEET